



② UNIT TYPE 1 - LOFT LEVEL
1/8" = 1'-0"

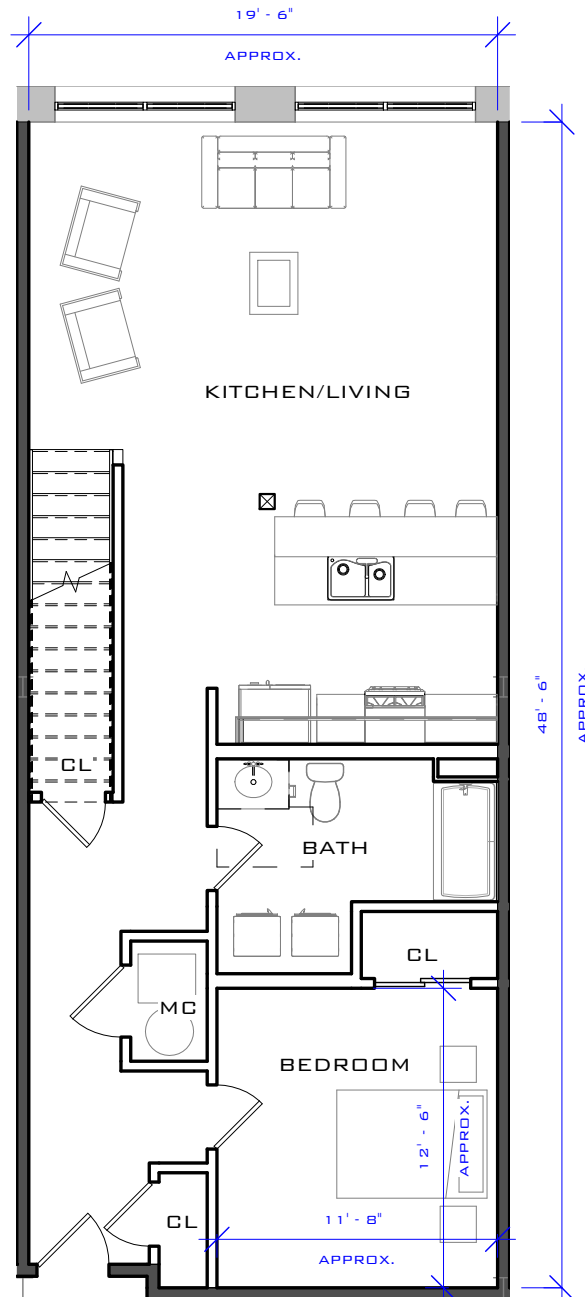


① UNIT TYPE 1 - MAIN LEVEL
1/8" = 1'-0"

DRAWING TITLE: UNIT TYPE 1 - 1,640 SQFT UNITS 9, 11, 13, 15, 17, 19, 21, 23, 25, 27	DWG No: <h1 style="text-align: center;">SK 1-1</h1>	DATE: 10/26/17
	<h2 style="text-align: center;">BRADY•SULLIVAN</h2> 670 N. COMMERCIAL ST. MANCHESTER, NH 03101 603.6226223	SCALE: 1/8" = 1'-0"
	PROJECT: ALCO BUILDING 35 IRON HORSE WAY, PROVIDENCE , RI	JOB NO: PROJECT NUMBER REVISED:


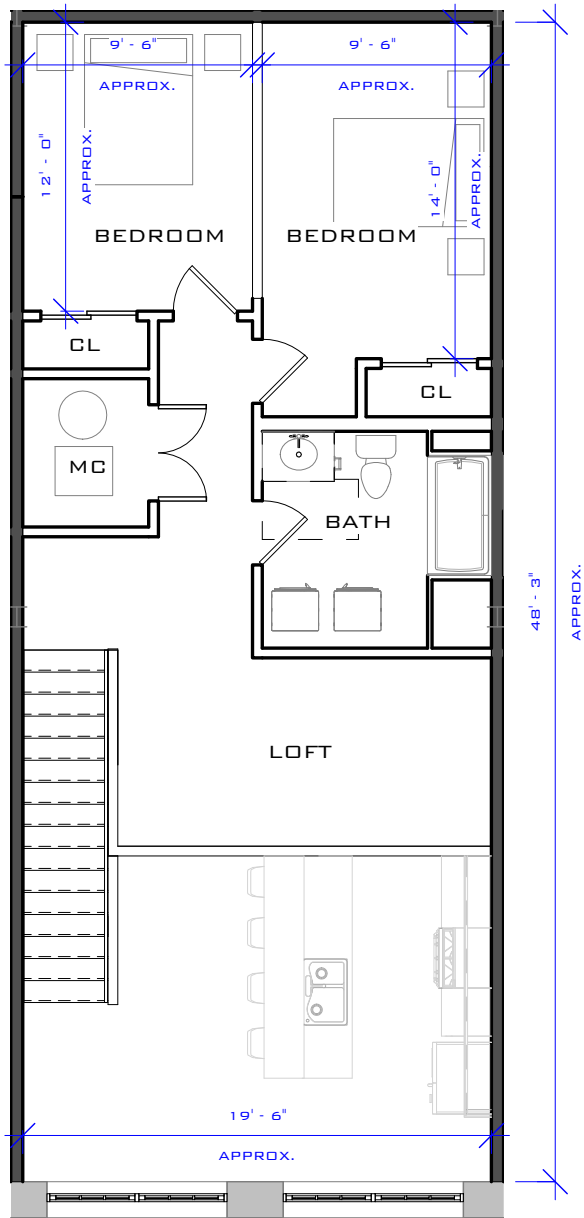


2 UNIT TYPE 2 - LOFT LEVEL
1/8" = 1'-0"

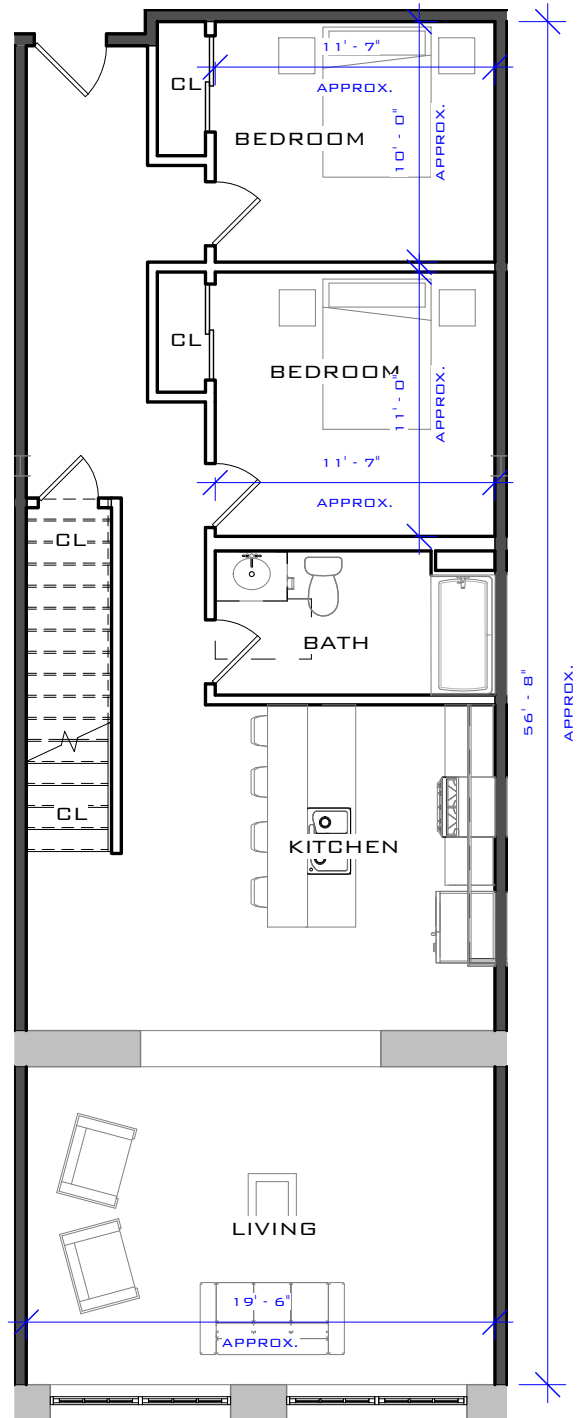

1 UNIT TYPE 2 - MAIN LEVEL
1/8" = 1'-0"



DRAWING TITLE: UNIT TYPE 2 - 1,842 SQFT UNITS 12, 14, 16, 18, 20, 22, 24, 26, 28	DWG No: <h1 style="text-align: center;">SK 1-2</h1>	DATE: 10/26/17
		SCALE: 1/8" = 1'-0"
PROJECT: ALCO BUILDING 35 IRON HORSE WAY, PROVIDENCE , RI	BRADY•SULLIVAN 670 N. COMMERCIAL ST. MANCHESTER, NH 03101 603.6226223	JOB NO: PROJECT NUMBER
		REVISED:

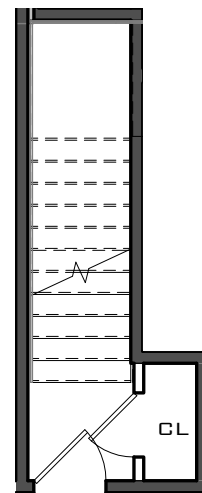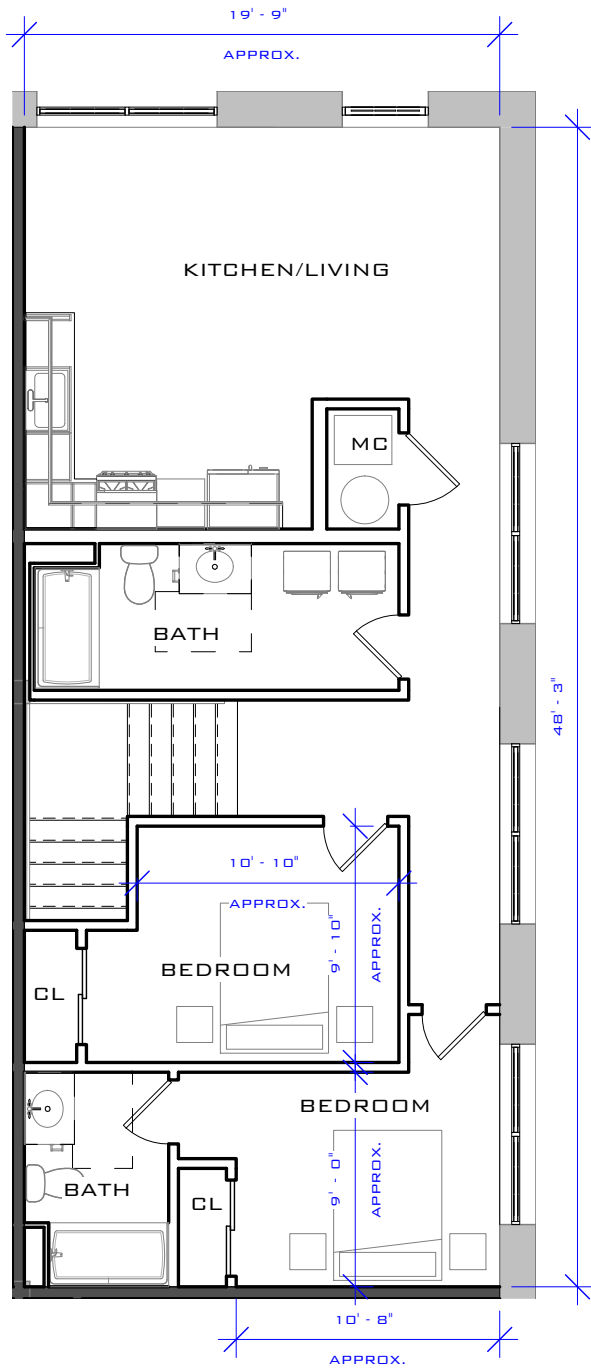

① UNIT TYPE 3 - ENTRY
1/8" = 1'-0"

② UNIT TYPE 3
1/8" = 1'-0"


DRAWING TITLE: UNIT TYPE 3 - 1,087 SQFT UNITS 3, 5	DWG NO: <h1>SK 1-3</h1>	DATE: 10/26/17	
	PROJECT: ALCO BUILDING 35 IRON HORSE WAY, PROVIDENCE , RI	SCALE: 1/8" = 1'-0"	JOB NO: PROJECT NUMBER
	BRADY•SULLIVAN 670 N. COMMERCIAL ST. MANCHESTER, NH 03101 603.6226223	REVISED:	

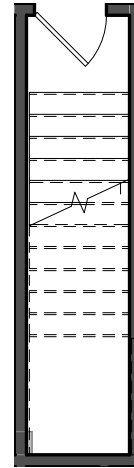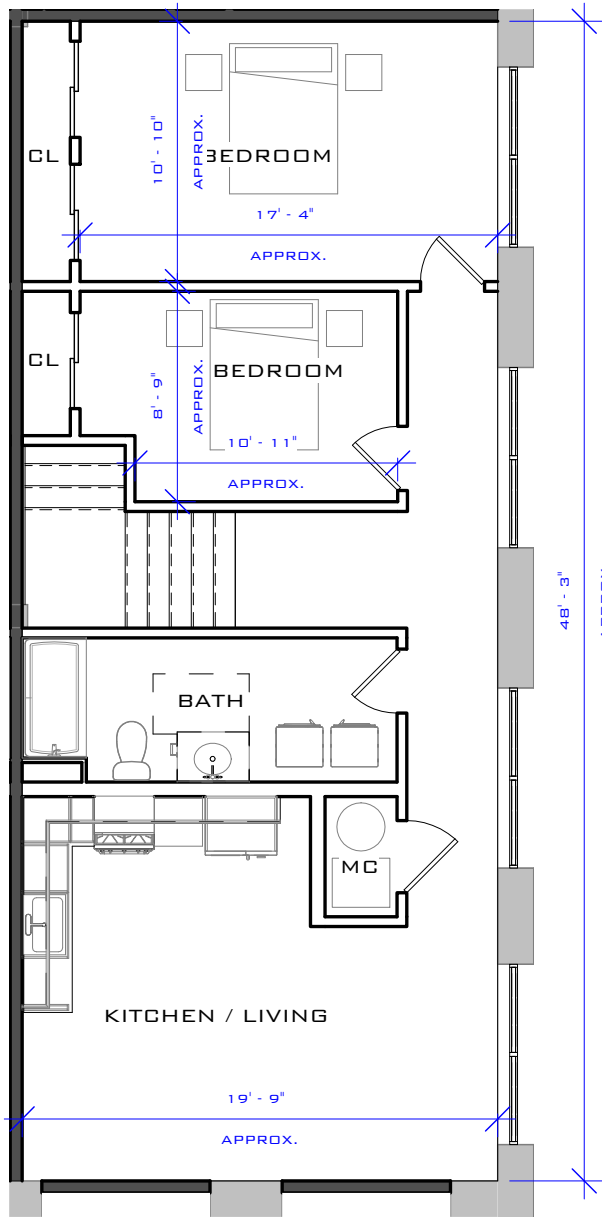

① UNIT TYPE 4 - ENTRY
 1/8" = 1'-0"


② UNIT TYPE 4
 1/8" = 1'-0"

DRAWING TITLE: UNIT TYPE 4 - 1,100 SQFT UNIT 4, 6	DWG No: <h1>SK 1-4</h1>	DATE: 10/26/17
		SCALE: 1/8" = 1'-0"
		JOB NO: PROJECT NUMBER
PROJECT: ALCO BUILDING 35 IRON HORSE WAY, PROVIDENCE , RI	BRADY•SULLIVAN 670 N. COMMERCIAL ST. MANCHESTER, NH 03101 603.6226223	REVISED:

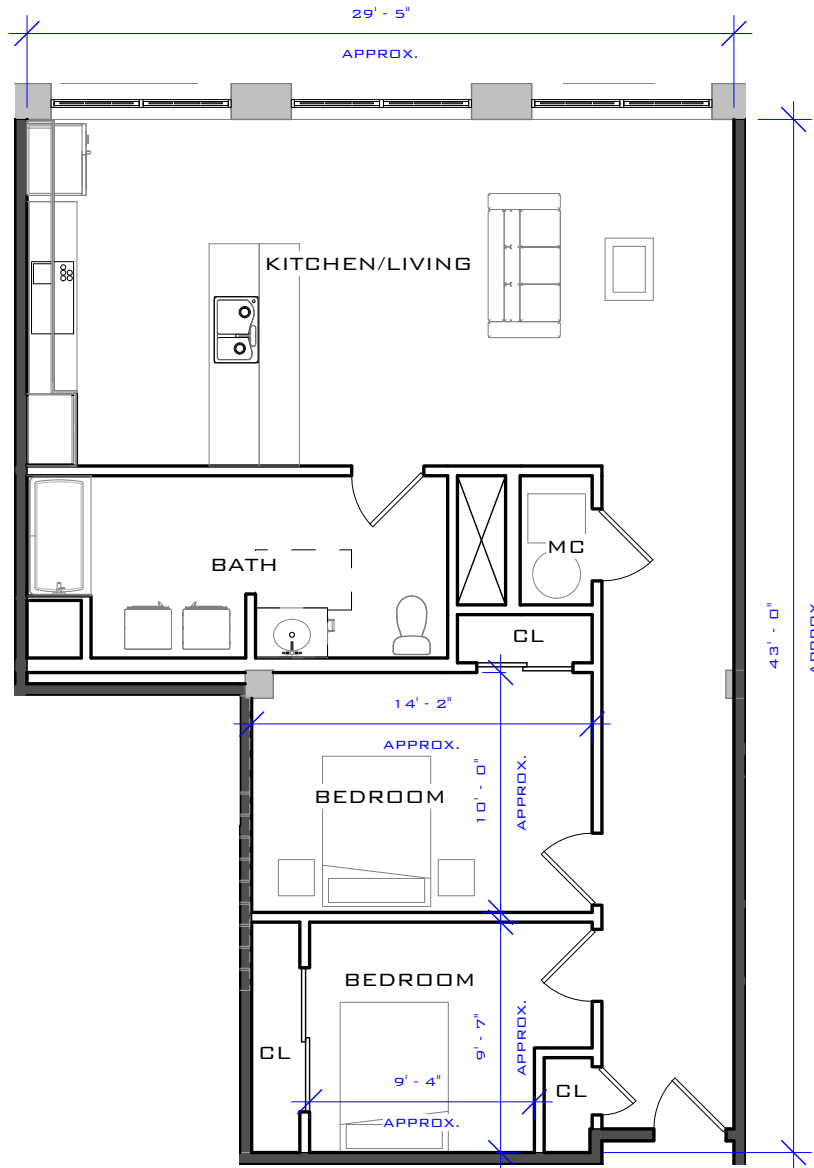


① UNIT TYPE 5
1/8" = 1'-0"

DRAWING TITLE: UNIT TYPE 5 - 1,120 SQFT UNITS 29, 35	DWG No: <h1>SK 1-5</h1>	DATE: 10/26/17
		SCALE: 1/8" = 1'-0"
		JOB NO: PROJECT NUMBER
PROJECT: ALCO BUILDING 35 IRON HORSE WAY, PROVIDENCE , RI	BRADY•SULLIVAN 670 N. COMMERCIAL ST. MANCHESTER, NH 03101 603.6226223	REVISED:

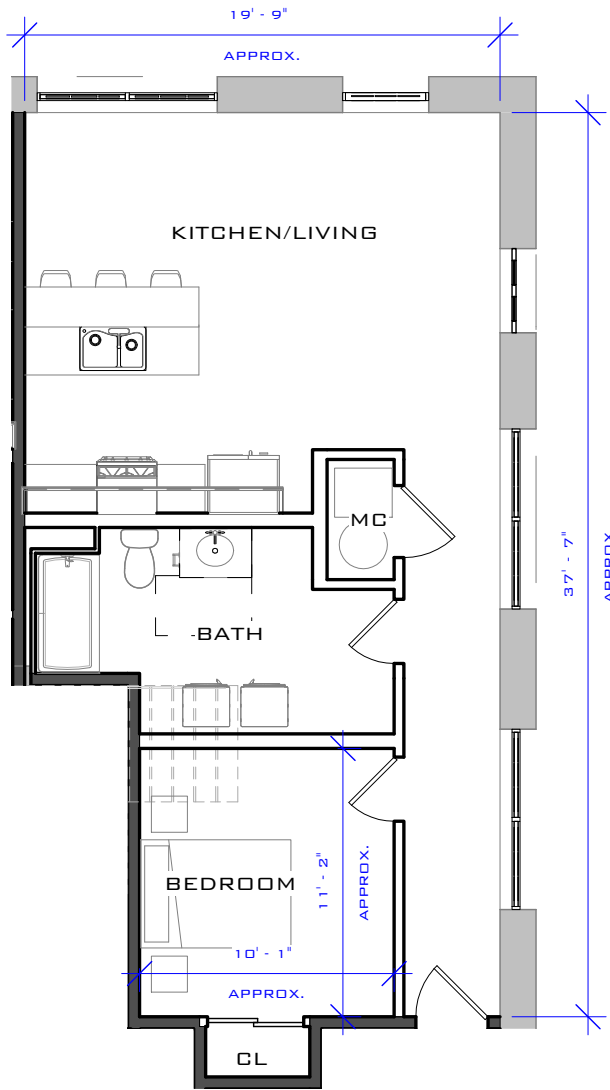


① UNIQUE UNIT 1
1/8" = 1'-0"

DRAWING TITLE: UNIQUE UNIT 1 - 731 SQFT UNIT 1	DWG No: <h1>SK 1-6</h1>	DATE: 10/26/17
		SCALE: 1/8" = 1'-0"
		JOB NO: PROJECT NUMBER
PROJECT: ALCO BUILDING 35 IRON HORSE WAY, PROVIDENCE , RI	BRADY•SULLIVAN 670 N. COMMERCIAL ST. MANCHESTER, NH 03101 603.6226223	REVISED:

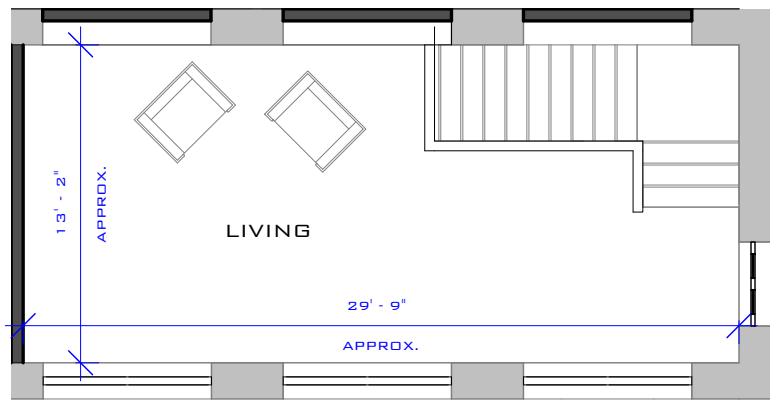


② UNIQUE UNIT 2 - SECOND LEVEL
1/8" = 1'-0"

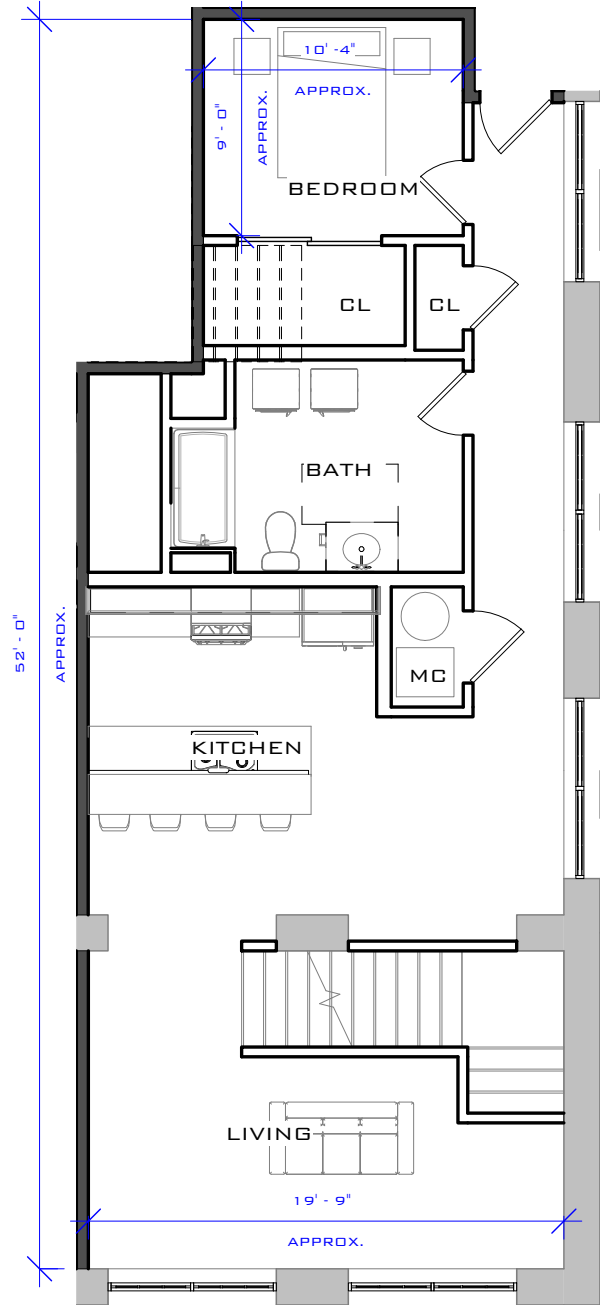


① UNIQUE UNIT 2 - MAIN LEVEL
1/8" = 1'-0"

DRAWING TITLE: UNIQUE UNIT 2 - 1,440 SQFT UNIT 2	DWG No: <h1>SK 1-7</h1>	DATE: 10/26/17
	BRADY•SULLIVAN 670 N. COMMERCIAL ST. MANCHESTER, NH 03101 603.6226223	SCALE: 1/8" = 1'-0"
	PROJECT: ALCO BUILDING 35 IRON HORSE WAY, PROVIDENCE , RI	JOB NO: PROJECT NUMBER REVISED:

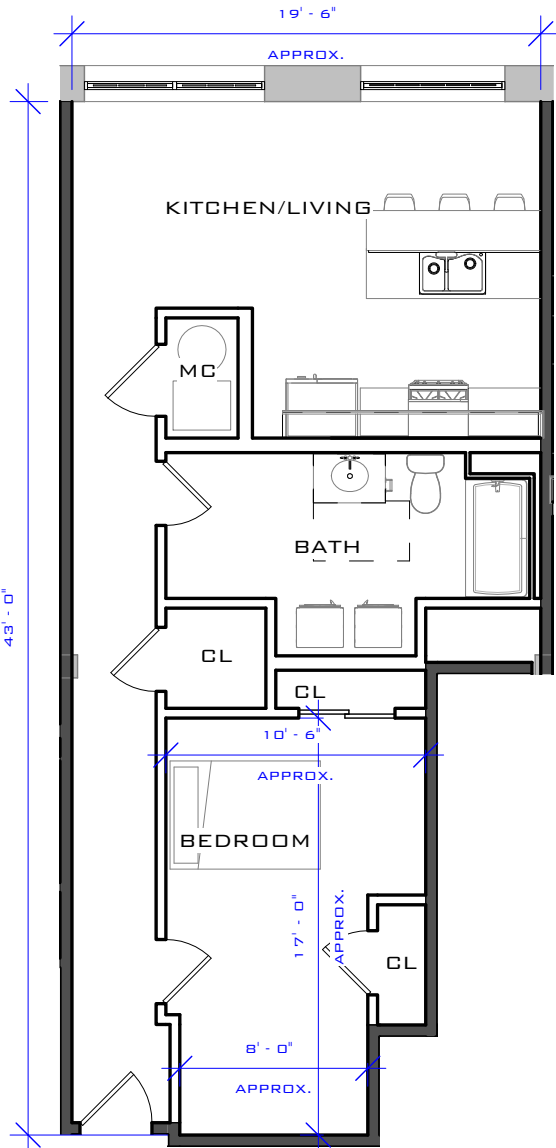


① **UNIQUE UNIT 7**
1/8" = 1'-0"

DRAWING TITLE: UNIQUE UNIT 7 - 767 SQFT UNIT 7	DWG No: <h1 style="text-align: center;">SK 1-8</h1>	DATE: 10/26/17
		SCALE: 1/8" = 1'-0"
		JOB NO: PROJECT NUMBER
PROJECT: ALCO BUILDING 35 IRON HORSE WAY, PROVIDENCE , RI	BRADY•SULLIVAN 670 N. COMMERCIAL ST. MANCHESTER, NH 03101 603.6226223	REVISED:

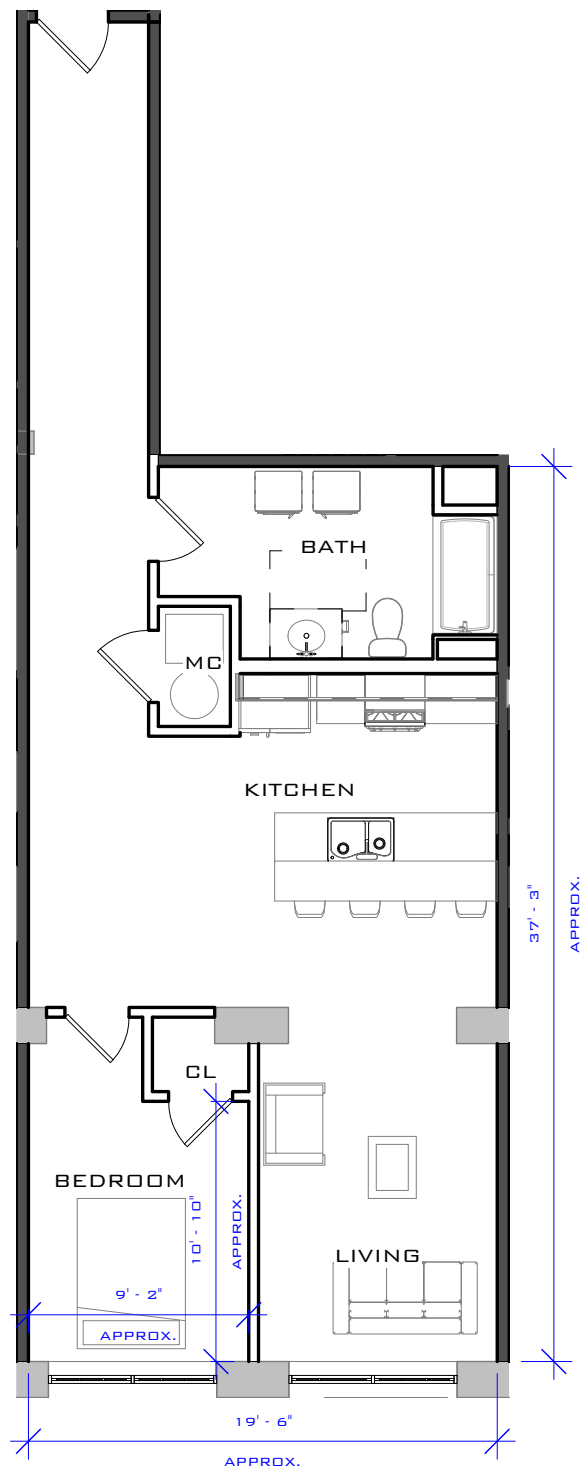


① **UNIQUE UNIT 8**
 1/8" = 1'-0"

DRAWING TITLE: UNIQUE UNIT 8 - 845 SQFT UNIT 8	DWG NO: <h1 style="text-align: center;">SK 1-9</h1>	DATE: 10/26/17
		SCALE: 1/8" = 1'-0"
		JOB NO: PROJECT NUMBER
PROJECT: ALCO BUILDING 35 IRON HORSE WAY, PROVIDENCE , RI	BRADY•SULLIVAN 670 N. COMMERCIAL ST. MANCHESTER, NH 03101 603.6226223	REVISED:

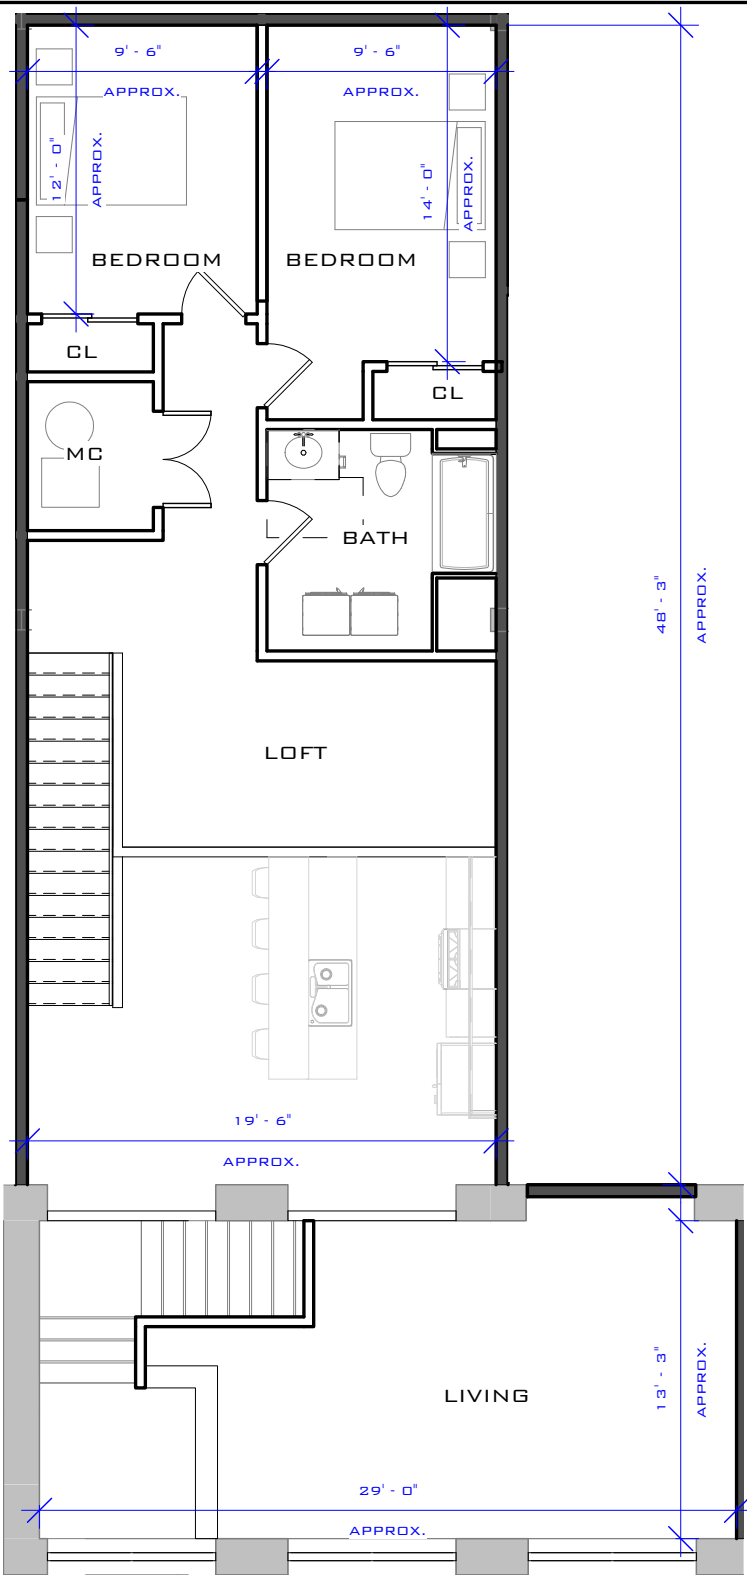


② UNIQUE UNIT TYPE 10 - LOFT LEVEL
1/8" = 1'-0"

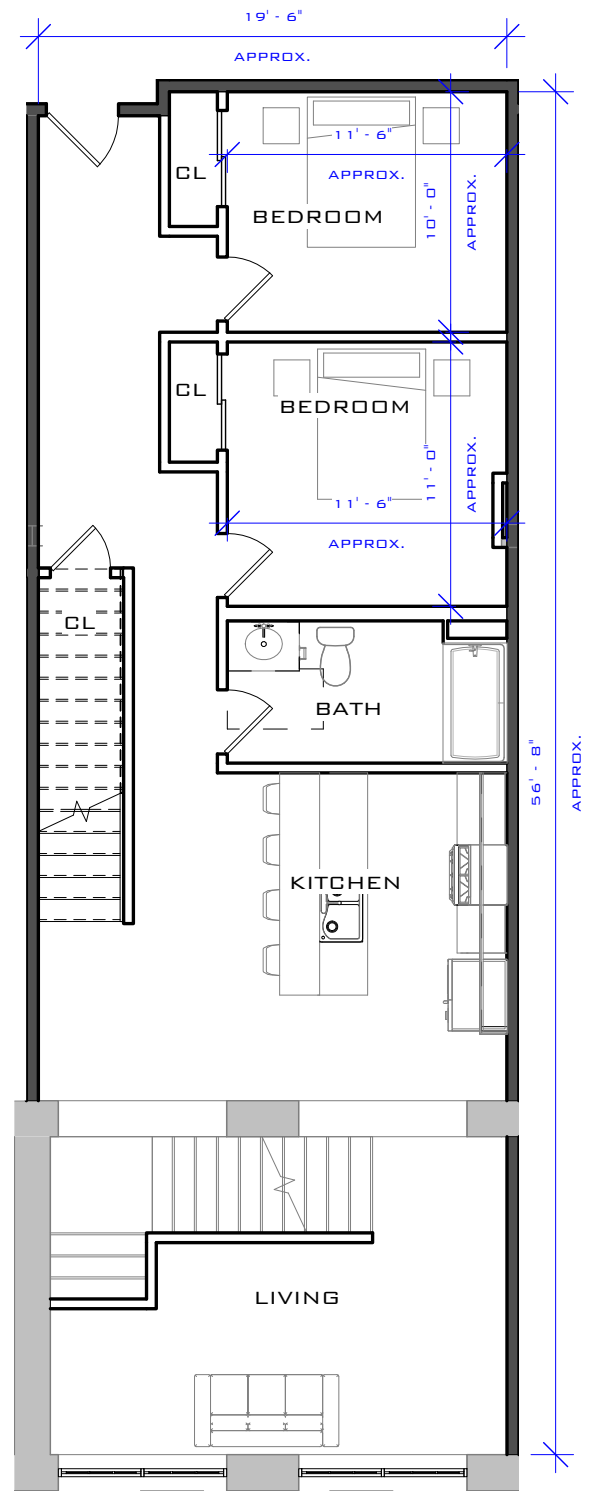


① UNIQUE UNIT TYPE 10 - MAIN LEVEL
1/8" = 1'-0"

DRAWING TITLE: UNIQUE UNIT 10 - 2,255 SQFT UNIT 10	DWG No:	DATE:	10/26/17
	SK 1-10	SCALE:	1/8" = 1'-0"
PROJECT: ALCO BUILDING 35 IRON HORSE WAY, PROVIDENCE , RI	BRADY•SULLIVAN	JOB NO:	PROJECT NUMBER
	670 N. COMMERCIAL ST. MANCHESTER, NH 03101 603.6226223	REVISED:	


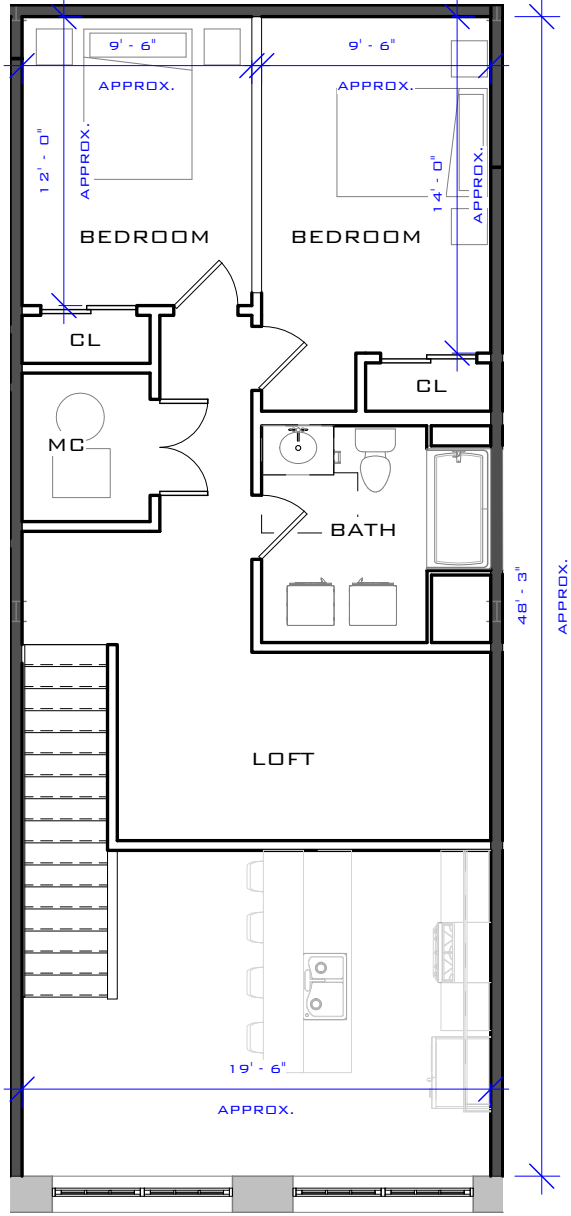


② UNIQUE UNIT 30 - LOFT LEVEL
1/8" = 1'-0"

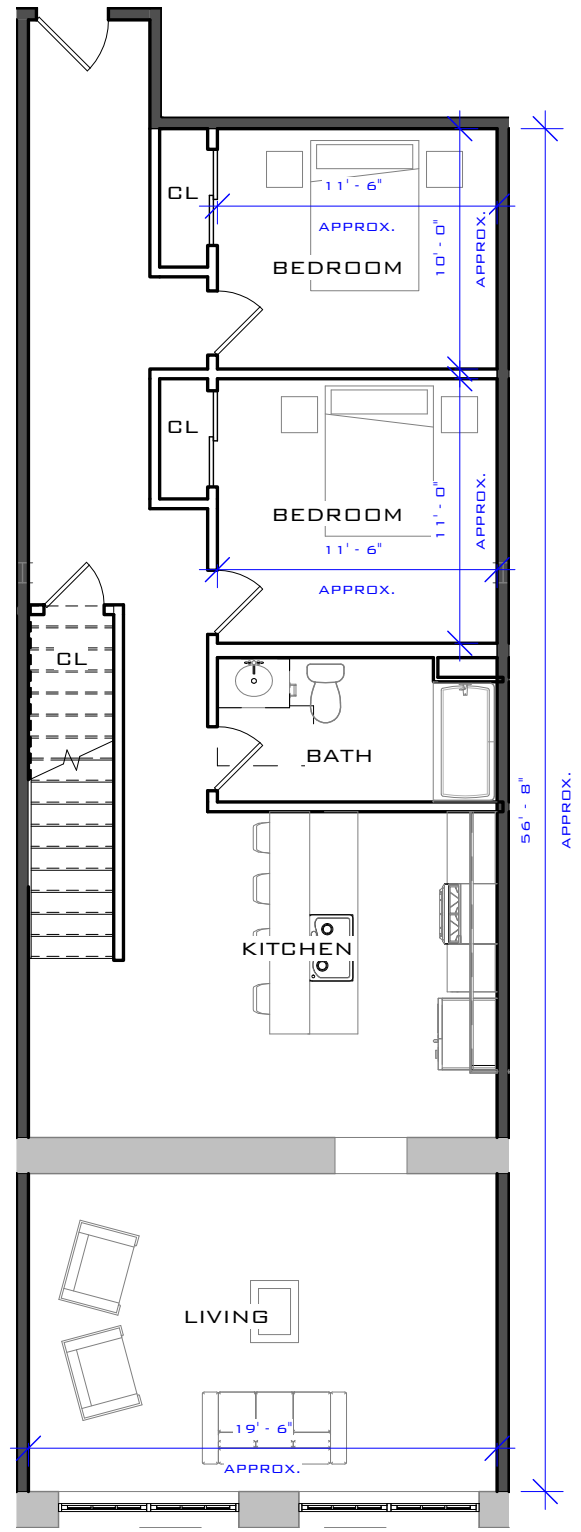

① UNIQUE UNIT 30 - MAIN LEVEL
1/8" = 1'-0"


DRAWING TITLE: UNIQUE UNIT 30 - 1,872 SQFT UNIT 30	DWG No: <h1>SK 1-11</h1>	DATE: 10/26/17
		SCALE: 1/8" = 1'-0"
		JOB NO: PROJECT NUMBER
PROJECT: ALCO BUILDING 35 IRON HORSE WAY, PROVIDENCE , RI	BRADY•SULLIVAN 670 N. COMMERCIAL ST. MANCHESTER, NH 03101 603.6226223	REVISED:

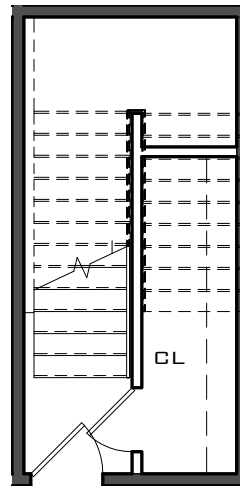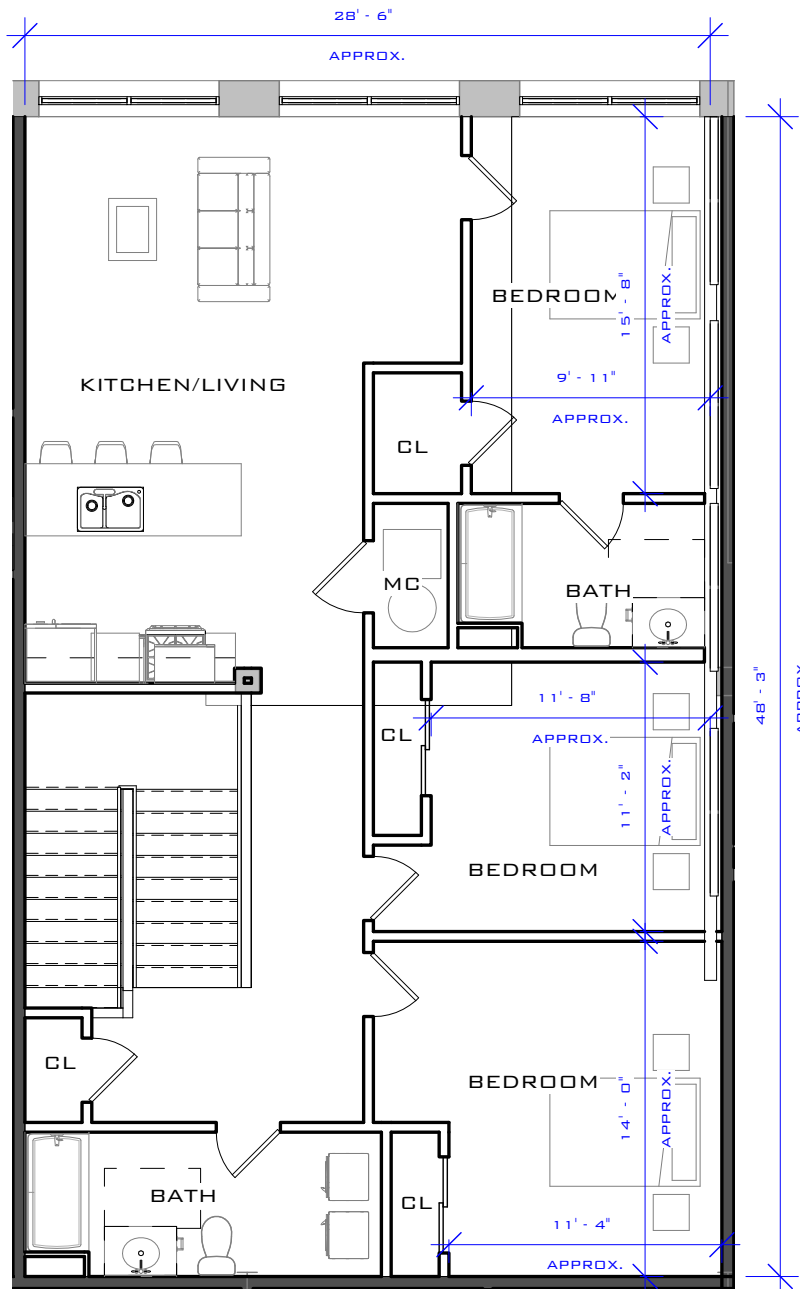

1 UNIQUE UNIT 31 - ENTRY
1/8" = 1'-0"


2 UNIQUE UNIT 31
1/8" = 1'-0"

DRAWING TITLE: UNIQUE UNIT 31 - 1,616 SQFT UNIT 31	DWG No: <h1>SK 1-12</h1>	DATE: 10/26/17
	<h2>BRADY•SULLIVAN</h2> 670 N. COMMERCIAL ST. MANCHESTER, NH 03101 603.6226223	SCALE: 1/8" = 1'-0"
	PROJECT: ALCO BUILDING 35 IRON HORSE WAY, PROVIDENCE , RI	JOB NO: PROJECT NUMBER


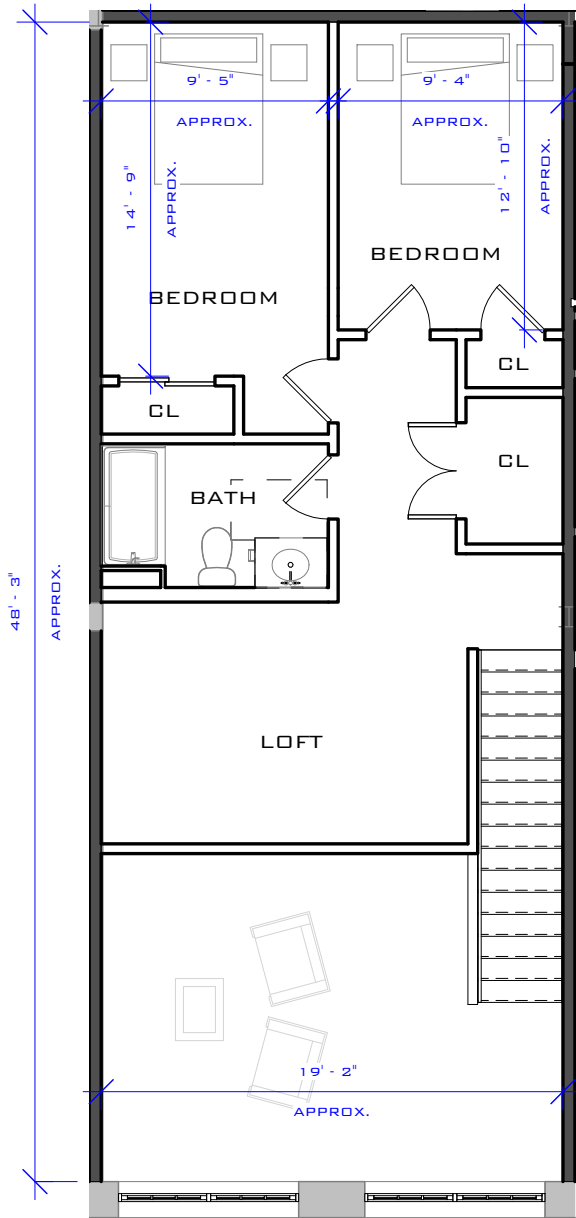


② **UNIQUE UNIT 32 - LOFT LEVEL**
1/8" = 1'-0"

① **UNIQUE UNIT 32 - MAIN LEVEL**
1/8" = 1'-0"

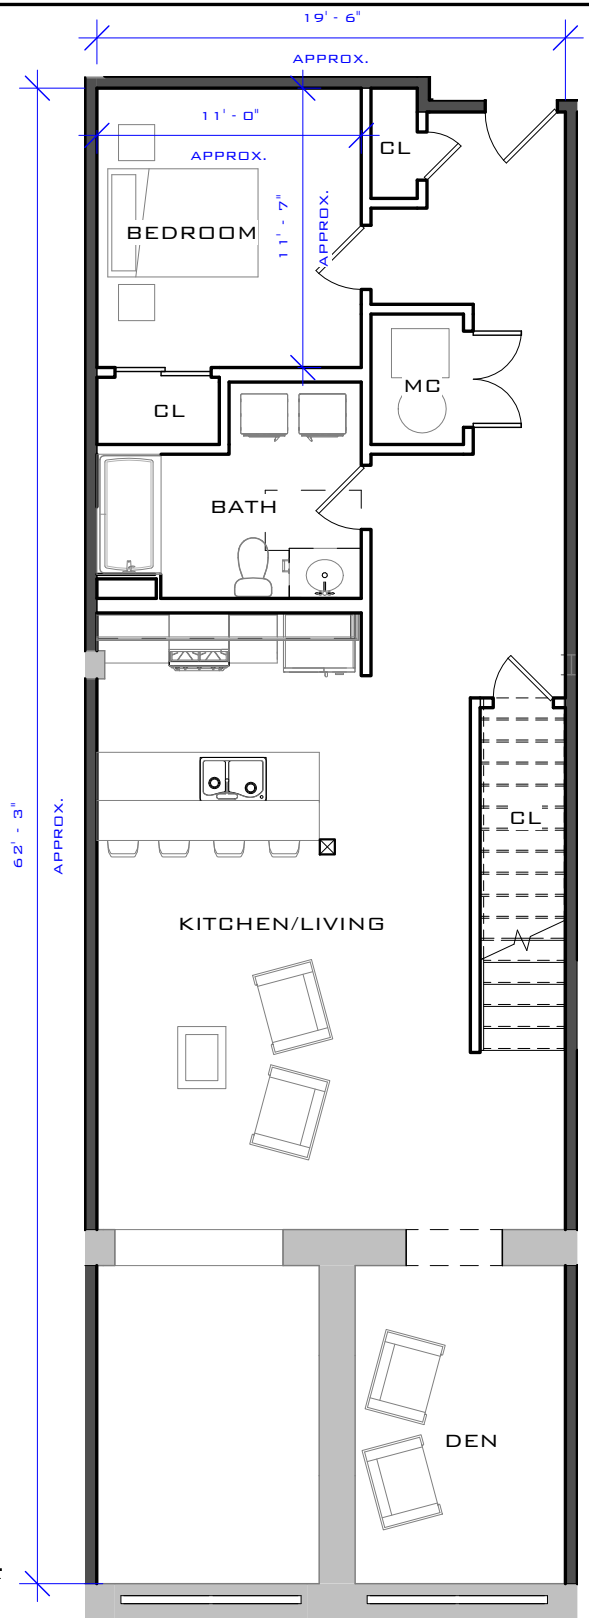


DRAWING TITLE: UNIQUE UNIT 32 - 1,941 SQFT UNIT 32	DWG No: <h1>SK 1-13</h1>	DATE: 10/26/17
		SCALE: 1/8" = 1'-0"
PROJECT: ALCO BUILDING 35 IRON HORSE WAY, PROVIDENCE , RI	BRADY•SULLIVAN 670 N. COMMERCIAL ST. MANCHESTER, NH 03101 603.6226223	JOB NO: PROJECT NUMBER
		REVISED:

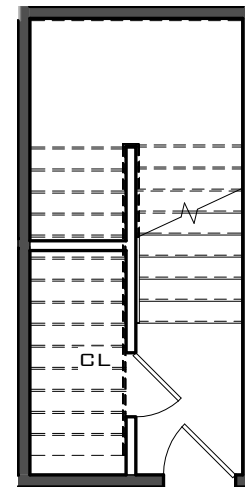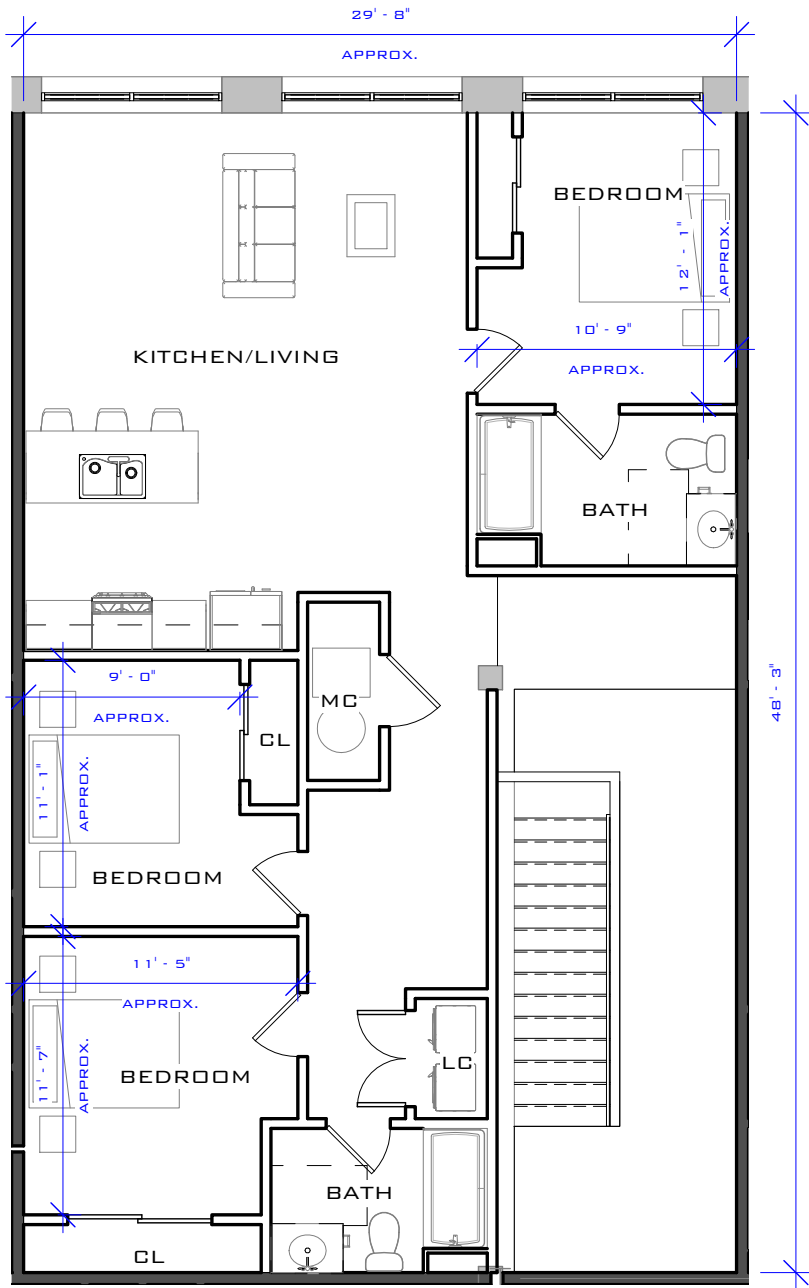

① UNIQUE UNIT 33
1/8" = 1'-0"



② UNIQUE UNIT 33 - ENTRY
1/8" = 1'-0"

DRAWING TITLE: UNIQUE UNIT 33 - 1,660 SQFT UNIT 33	DWG NO:	DATE:	10/26/17
	SK 1-14	SCALE:	1/8" = 1'-0"
PROJECT: ALCO BUILDING 35 IRON HORSE WAY, PROVIDENCE , RI	BRADY•SULLIVAN	JOB NO:	PROJECT NUMBER
	670 N. COMMERCIAL ST. MANCHESTER, NH 03101 603.6226223	REVISED:	

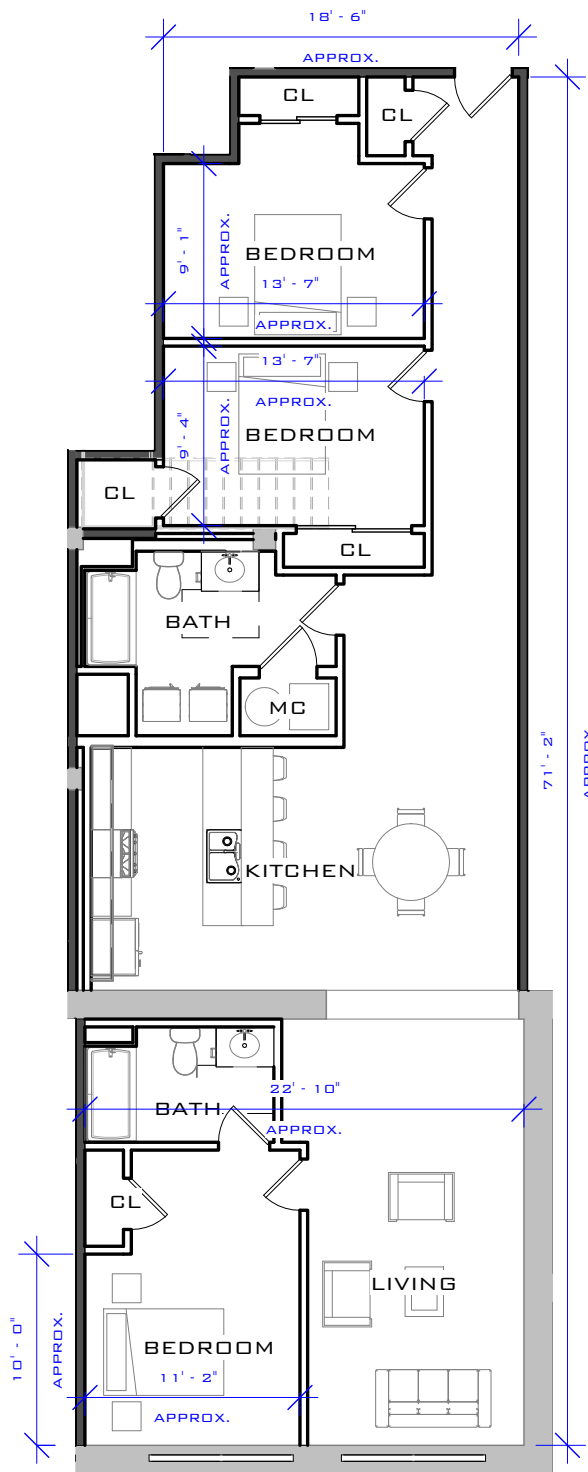

① **UNIQUE UNIT 34**
1" = 10'-0"



DRAWING TITLE: UNIQUE UNIT 34 - 1,589 SQFT UNIT 34	DWG No: <h1>SK 1-15</h1>	DATE: 10/26/17
	<h2>BRADY•SULLIVAN</h2> 670 N. COMMERCIAL ST. MANCHESTER, NH 03101 603.6226223	SCALE: 1" = 10'-0"
	PROJECT: ALCO BUILDING 35 IRON HORSE WAY, PROVIDENCE , RI	JOB NO: PROJECT NUMBER

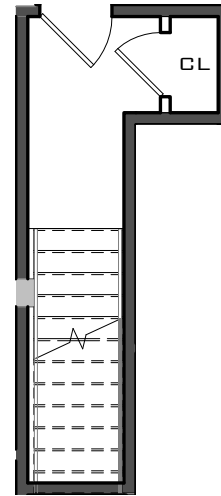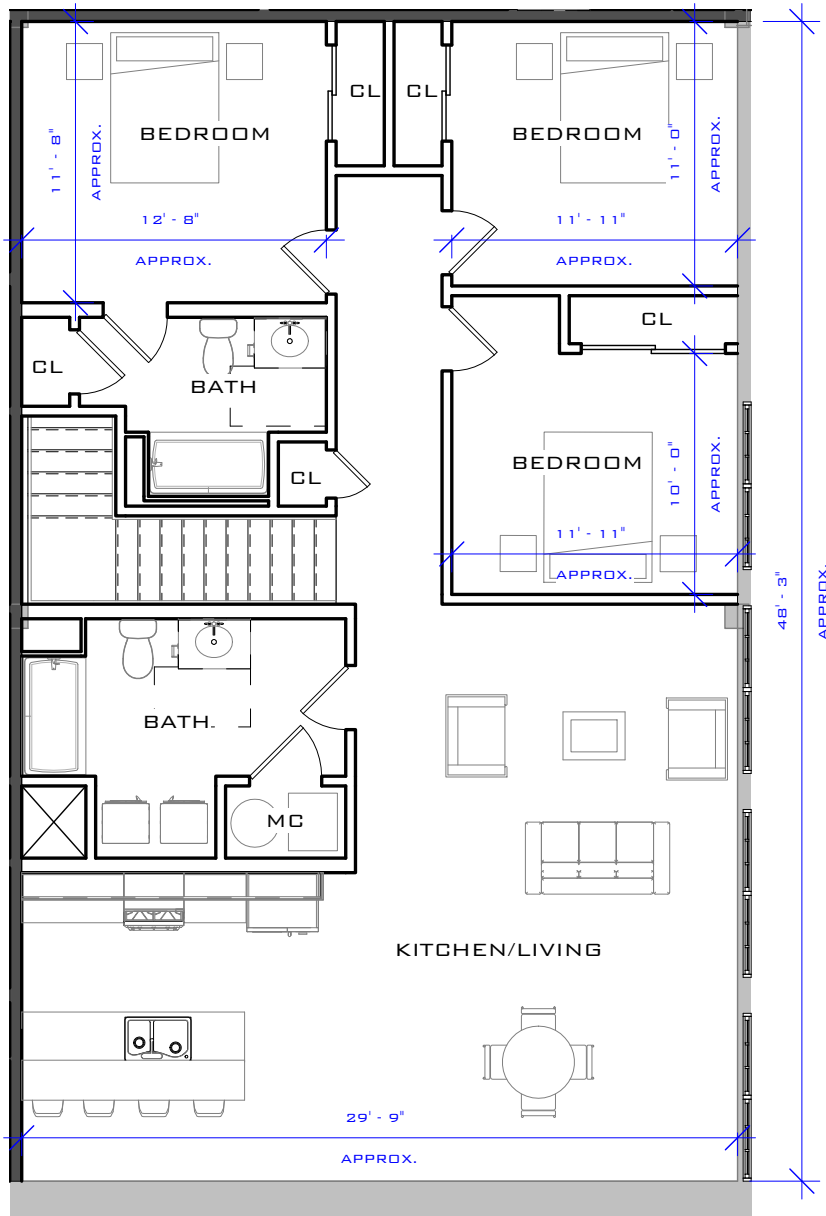

① **UNIQUE UNIT 36 - ENTANCE**
1/8" = 1'-0"

② **UNIQUE UNIT 36**
1/8" = 1'-0"



DRAWING TITLE: UNIQUE UNIT 36 - 1,577 SQFT UNIT 36	DWG No: SK 1-16	DATE: 10/26/17
		SCALE: 1/8" = 1'-0"
		JOB NO: PROJECT NUMBER
PROJECT: ALCO BUILDING 35 IRON HORSE WAY, PROVIDENCE , RI	BRADY•SULLIVAN 670 N. COMMERCIAL ST. MANCHESTER, NH 03101 603.6226223	REVISED:

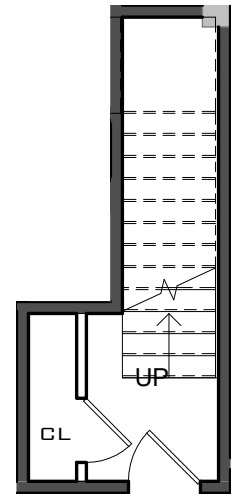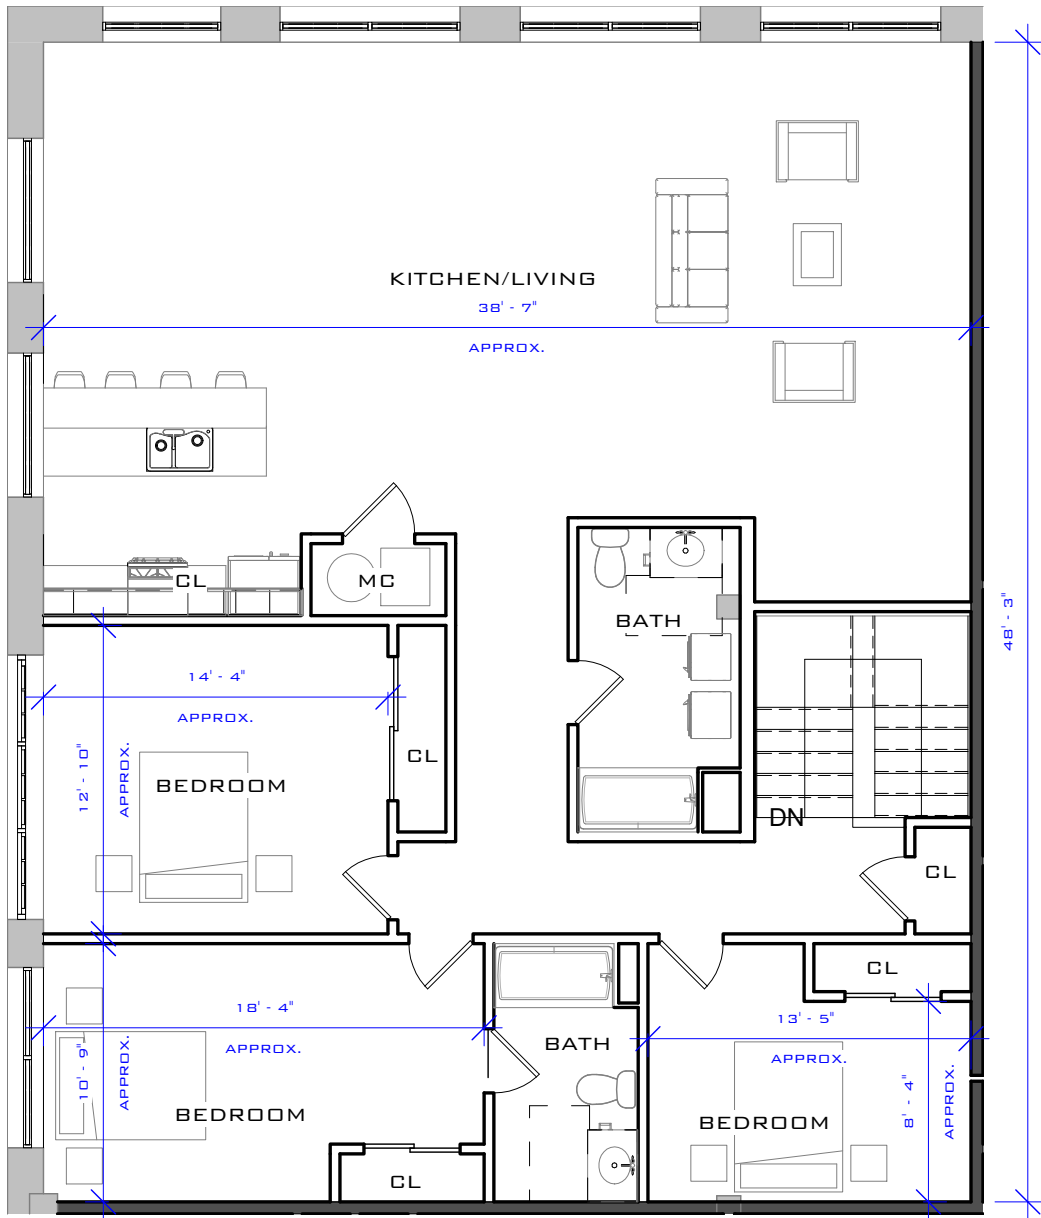

② **UNIQUE UNIT 37**
1/8" = 1'-0"

① **UNIQUE UNIT 37 - ENTRY**
1/8" = 1'-0"


DRAWING TITLE: UNIQUE UNIT 37 - 2,042 SQFT UNIT 37	DWG No: <h1>SK 1-17</h1>	DATE: 10/26/17
	<h2>BRADY•SULLIVAN</h2> 670 N. COMMERCIAL ST. MANCHESTER, NH 03101 603.6226223	SCALE: 1/8" = 1'-0"
	PROJECT: ALCO BUILDING 35 IRON HORSE WAY, PROVIDENCE , RI	JOB NO: PROJECT NUMBER

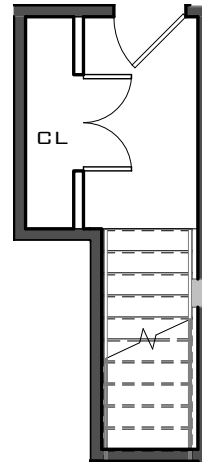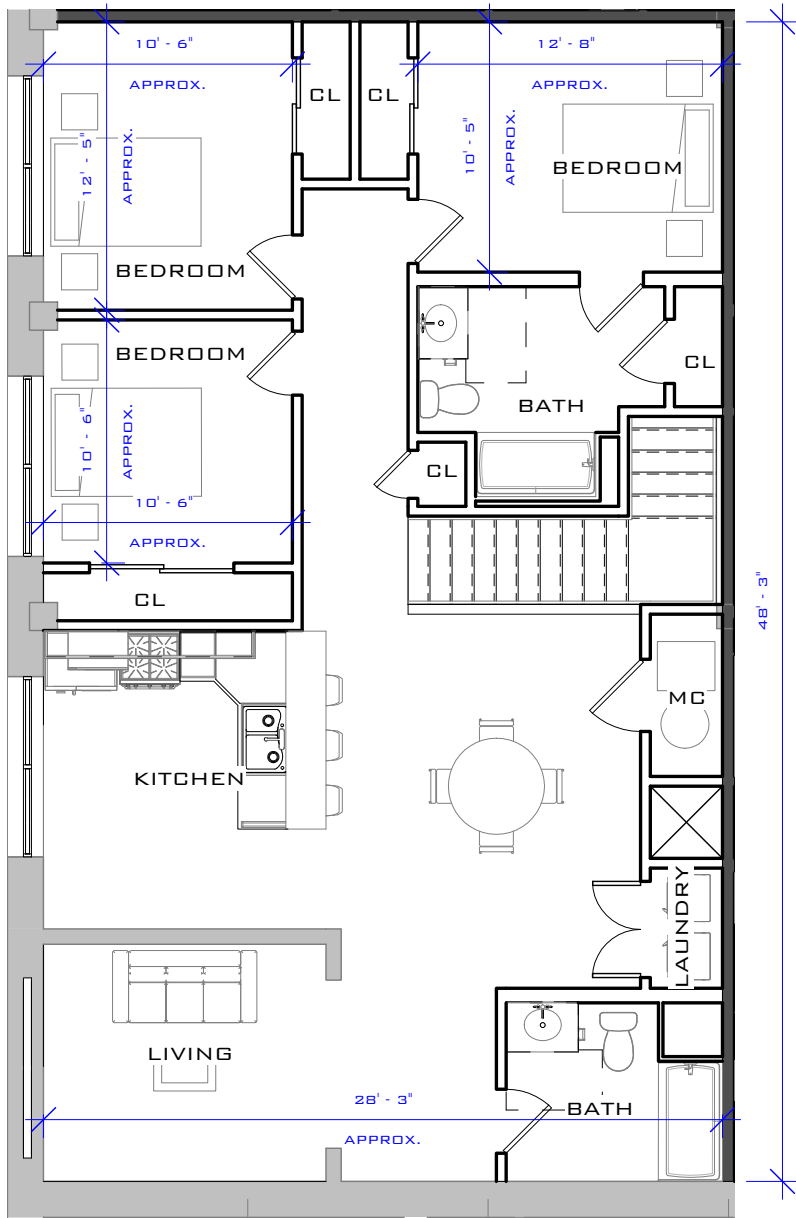

① UNIQUE UNIT 38 - ENTRY
1/8" = 1'-0"


② UNIQUE UNIT 38
1/8" = 1'-0"

DRAWING TITLE: UNIQUE UNIT 38 - 1,544 SQFT UNIT 38	DWG No:	DATE:	10/26/17
	SK 1-18	SCALE:	1/8" = 1'-0"
		JOB NO:	PROJECT NUMBER
PROJECT: ALCO BUILDING 35 IRON HORSE WAY, PROVIDENCE , RI	BRADY•SULLIVAN 670 N. COMMERCIAL ST. MANCHESTER, NH 03101 603.6226223		REVISED:

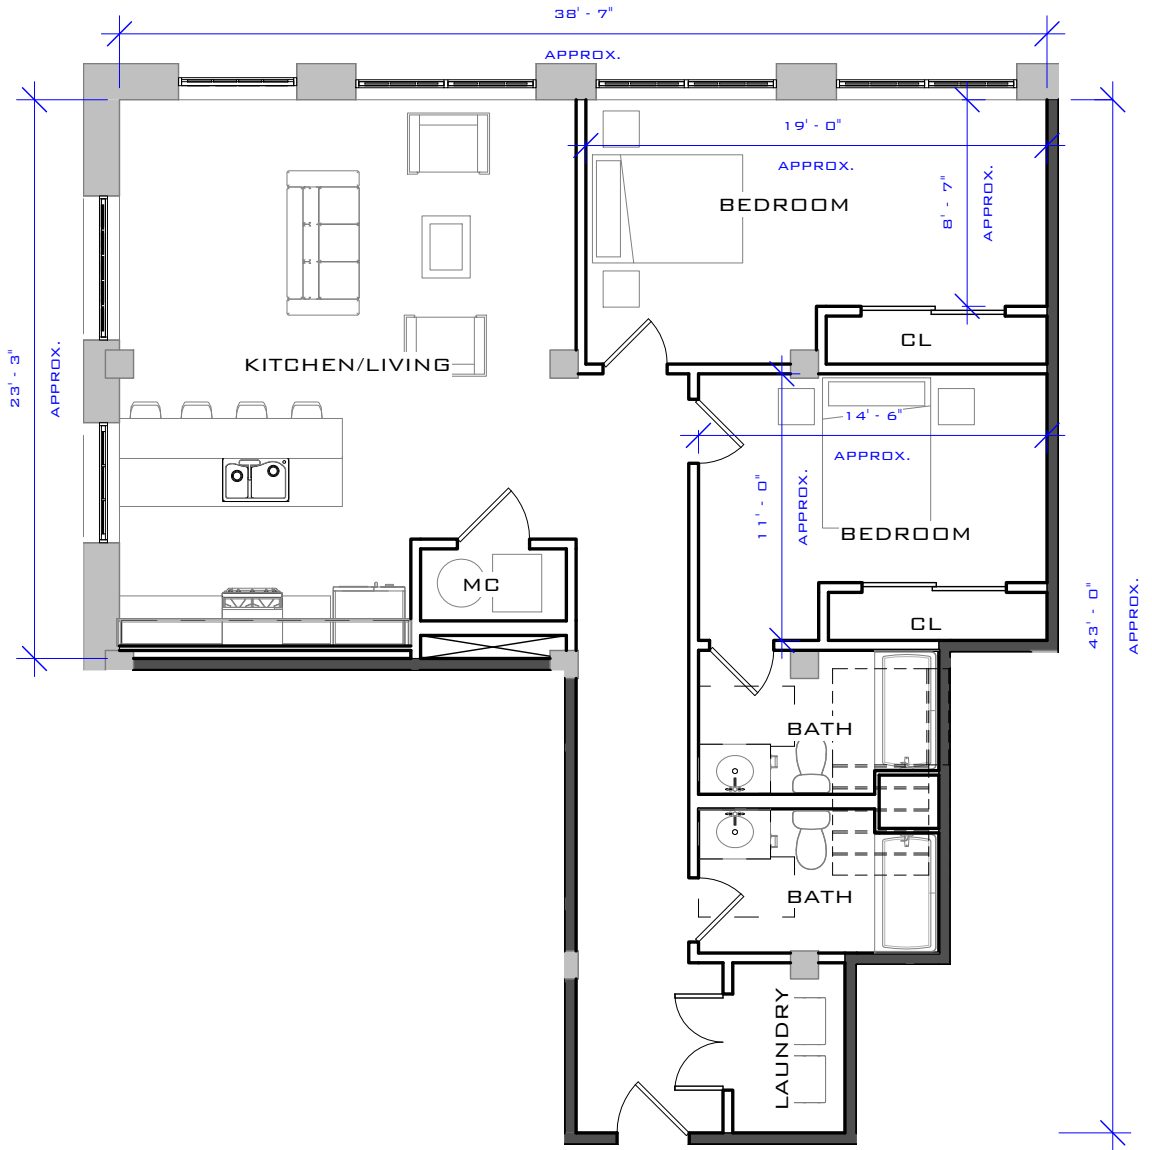


1 UNIQUE UNIT 39
 1/8" = 1'-0"

DRAWING TITLE: UNIQUE UNIT 39 - 1,219 SQFT UNIT 39	DWG No: <h1>SK 1-19</h1>	DATE: 10/26/17
	BRADY•SULLIVAN 670 N. COMMERCIAL ST. MANCHESTER, NH 03101 603.6226223	SCALE: 1/8" = 1'-0"
	PROJECT: ALCO BUILDING 35 IRON HORSE WAY, PROVIDENCE , RI	JOB NO: PROJECT NUMBER

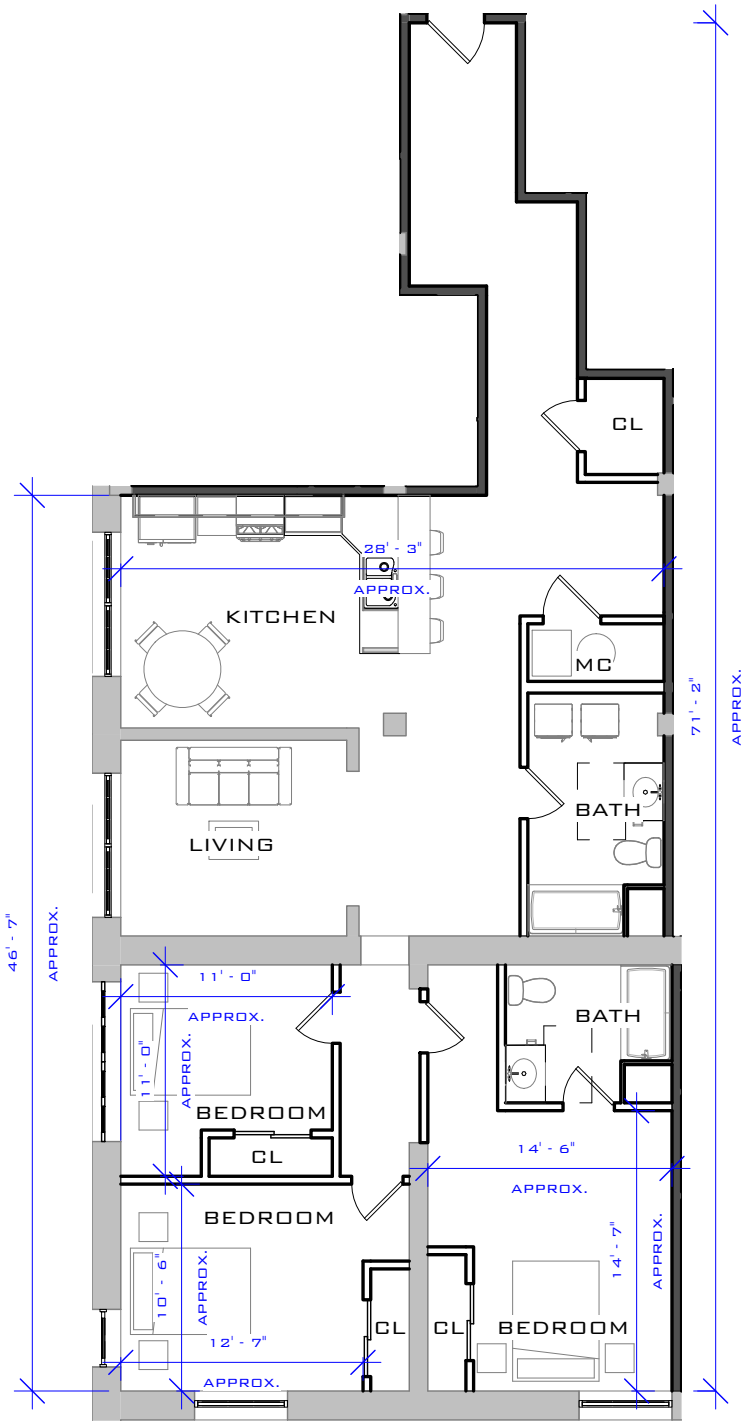

① **UNIQUE UNIT 40**
 1" = 10'-0"

DRAWING TITLE: UNIQUE UNIT 40 - 1,541 SQFT UNIT 40	DWG No: <h1>SK 1-20</h1>	DATE: 10/26/17
	<h2>BRADY•SULLIVAN</h2> 670 N. COMMERCIAL ST. MANCHESTER, NH 03101 603.6226223	SCALE: 1" = 10'-0"
	PROJECT: ALCO BUILDING 35 IRON HORSE WAY, PROVIDENCE , RI	JOB NO: PROJECT NUMBER

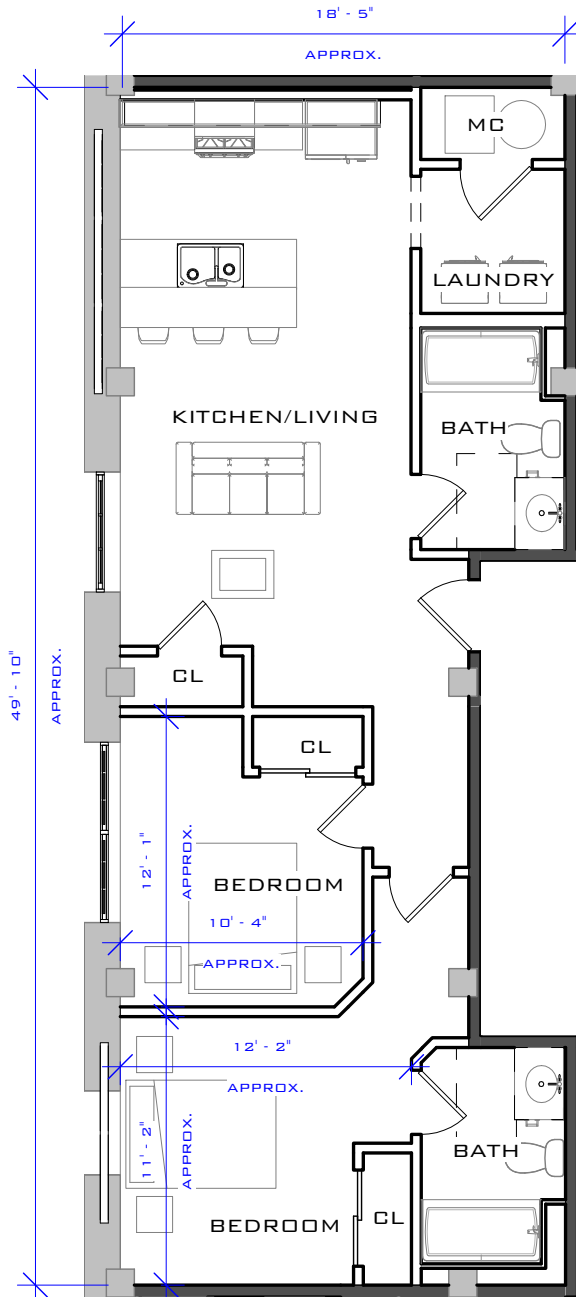

① UNIQUE UNIT 41
1/8" = 1'-0"

DRAWING TITLE: UNIQUE UNIT 41 - 888 SQFT UNIT 41	DWG No:	DATE: 10/26/17
	SK 1-21	SCALE: 1/8" = 1'-0"
		JOB NO: PROJECT NUMBER
PROJECT: ALCO BUILDING 35 IRON HORSE WAY, PROVIDENCE , RI	BRADY•SULLIVAN 670 N. COMMERCIAL ST. MANCHESTER, NH 03101 603.6226223	REVISED: