

(SIMILAR UNITS: A-101)

ACTUAL SQUARE FOOTAGE MAY VARY




**JUNCTION
SHOP MILLS**
JUNCTION SHOPS
MILL

UNIT A-101 (1,116 S.F.)

Project number	Project Number
Date	Issue Date
Drawn by	Author
Checked by	Checker

SKA-1-1

Scale 1/8" = 1'-0"

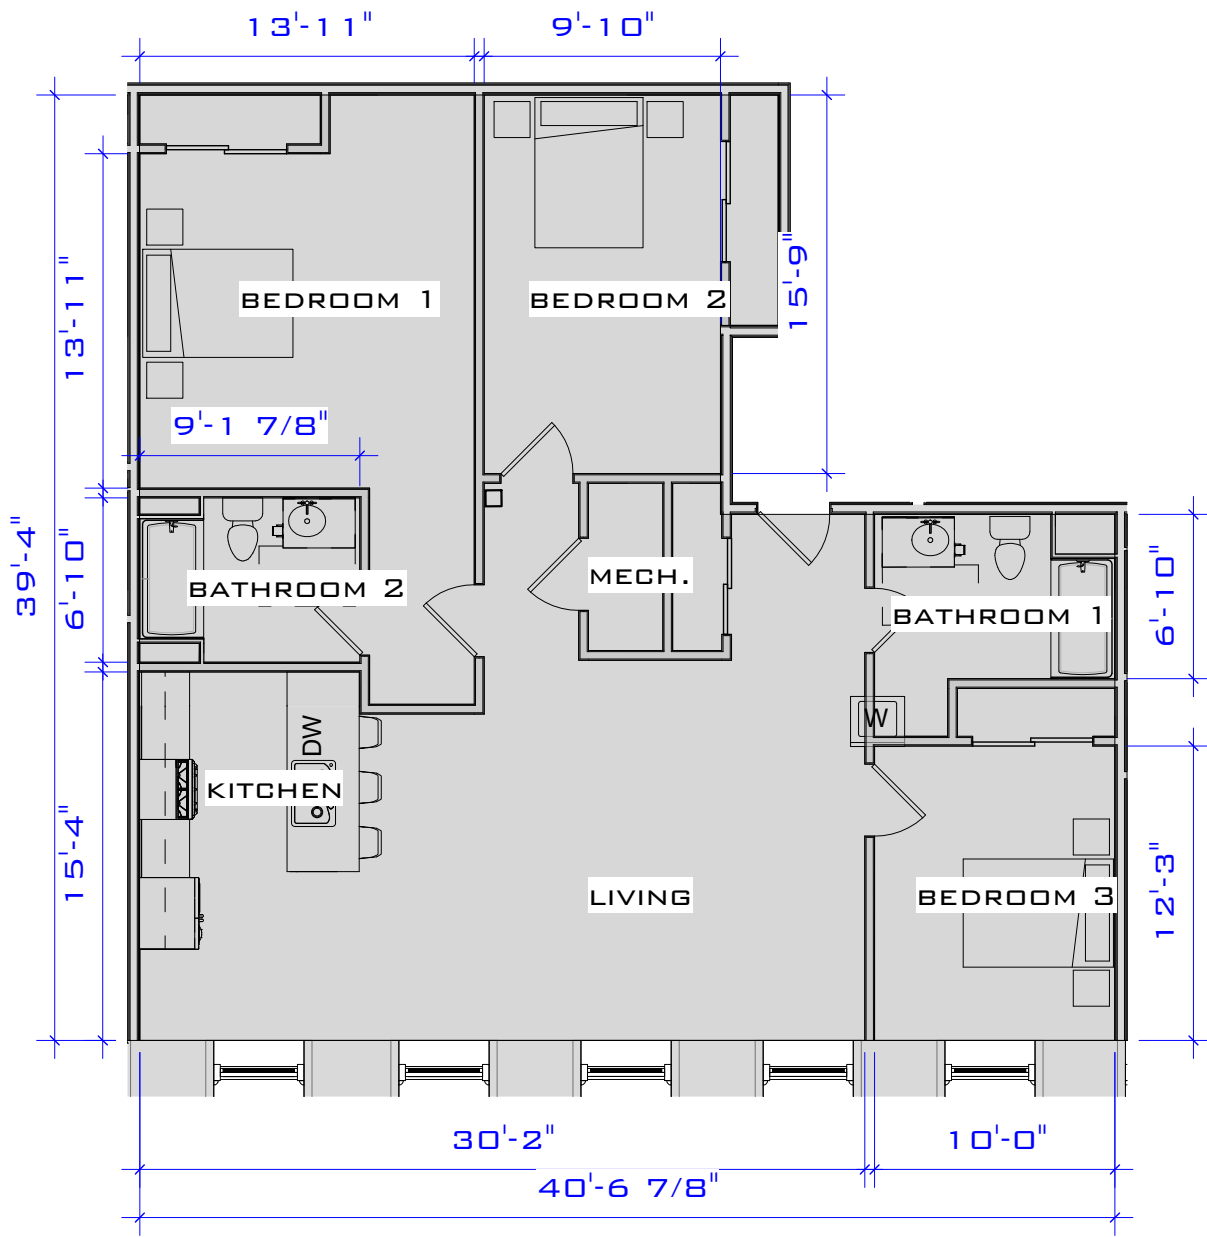

(SIMILAR UNITS: A-102)

ACTUAL SQUARE FOOTAGE MAY VARY




**JUNCTION
 SHOP MILLS**
 JUNCTION SHOPS
 MILL

UNIT A-102 (1,333 S.F.)

Project number	Project Number
Date	Issue Date
Drawn by	Author
Checked by	Checker

SKA-1-2

Scale 1/8" = 1'-0"

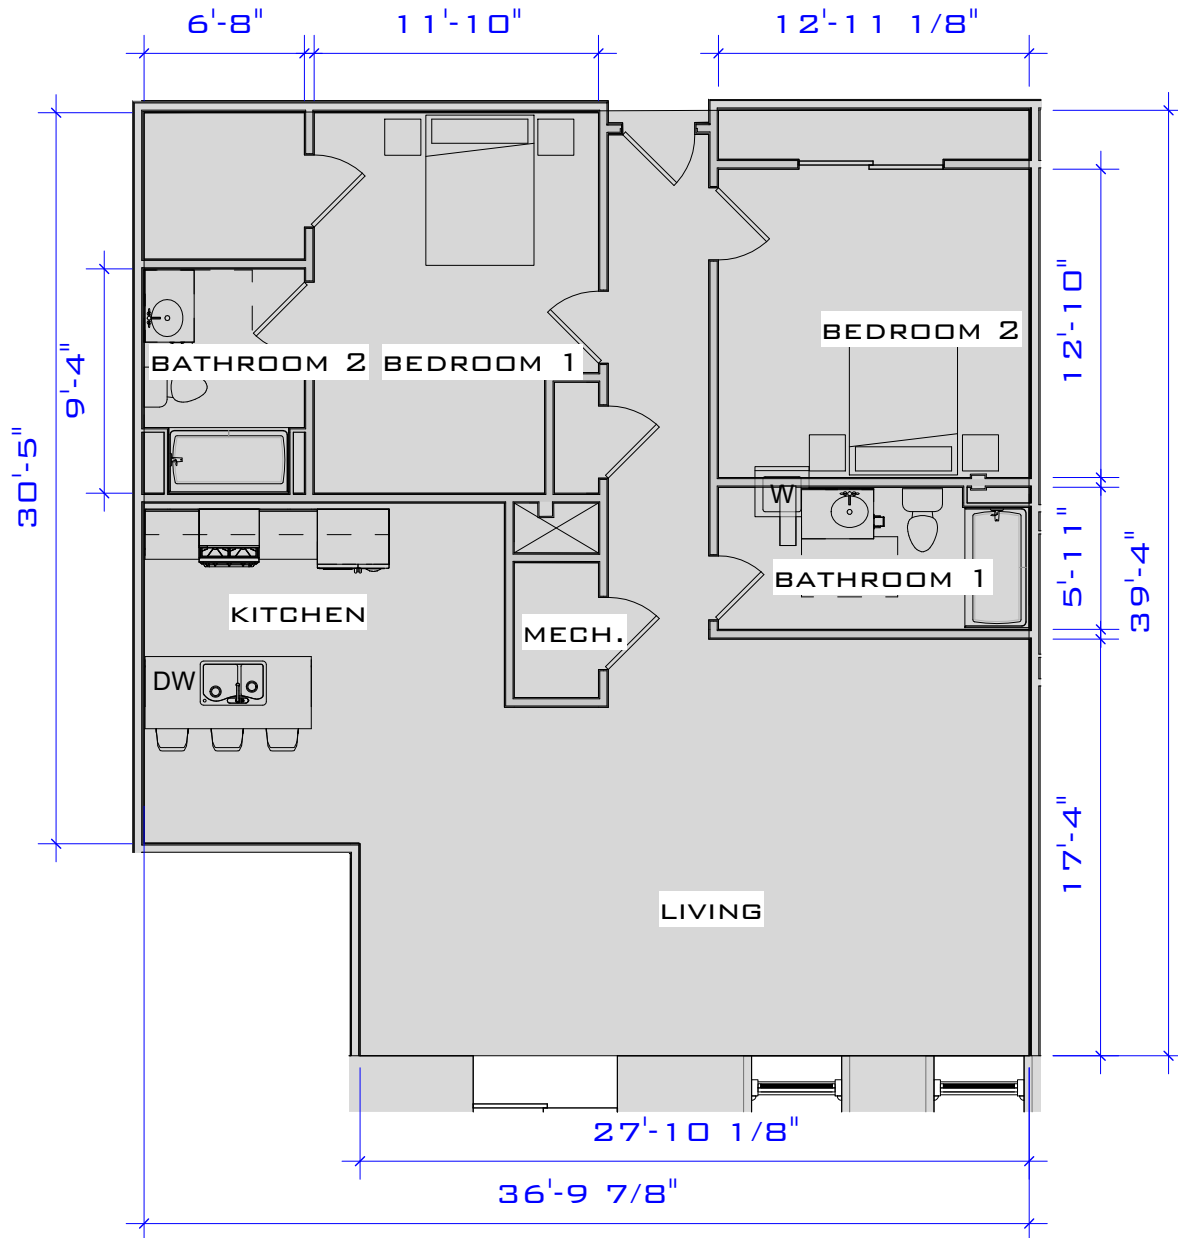

(SIMILAR UNITS: A-103)

ACTUAL SQUARE FOOTAGE MAY VARY




**JUNCTION
SHOP MILLS
JUNCTION SHOPS
MILL**

UNIT A-103 (1,368 S.F.)

Project number	Project Number
Date	Issue Date
Drawn by	Author
Checked by	Checker

SKA-1-3

Scale 1/8" = 1'-0"

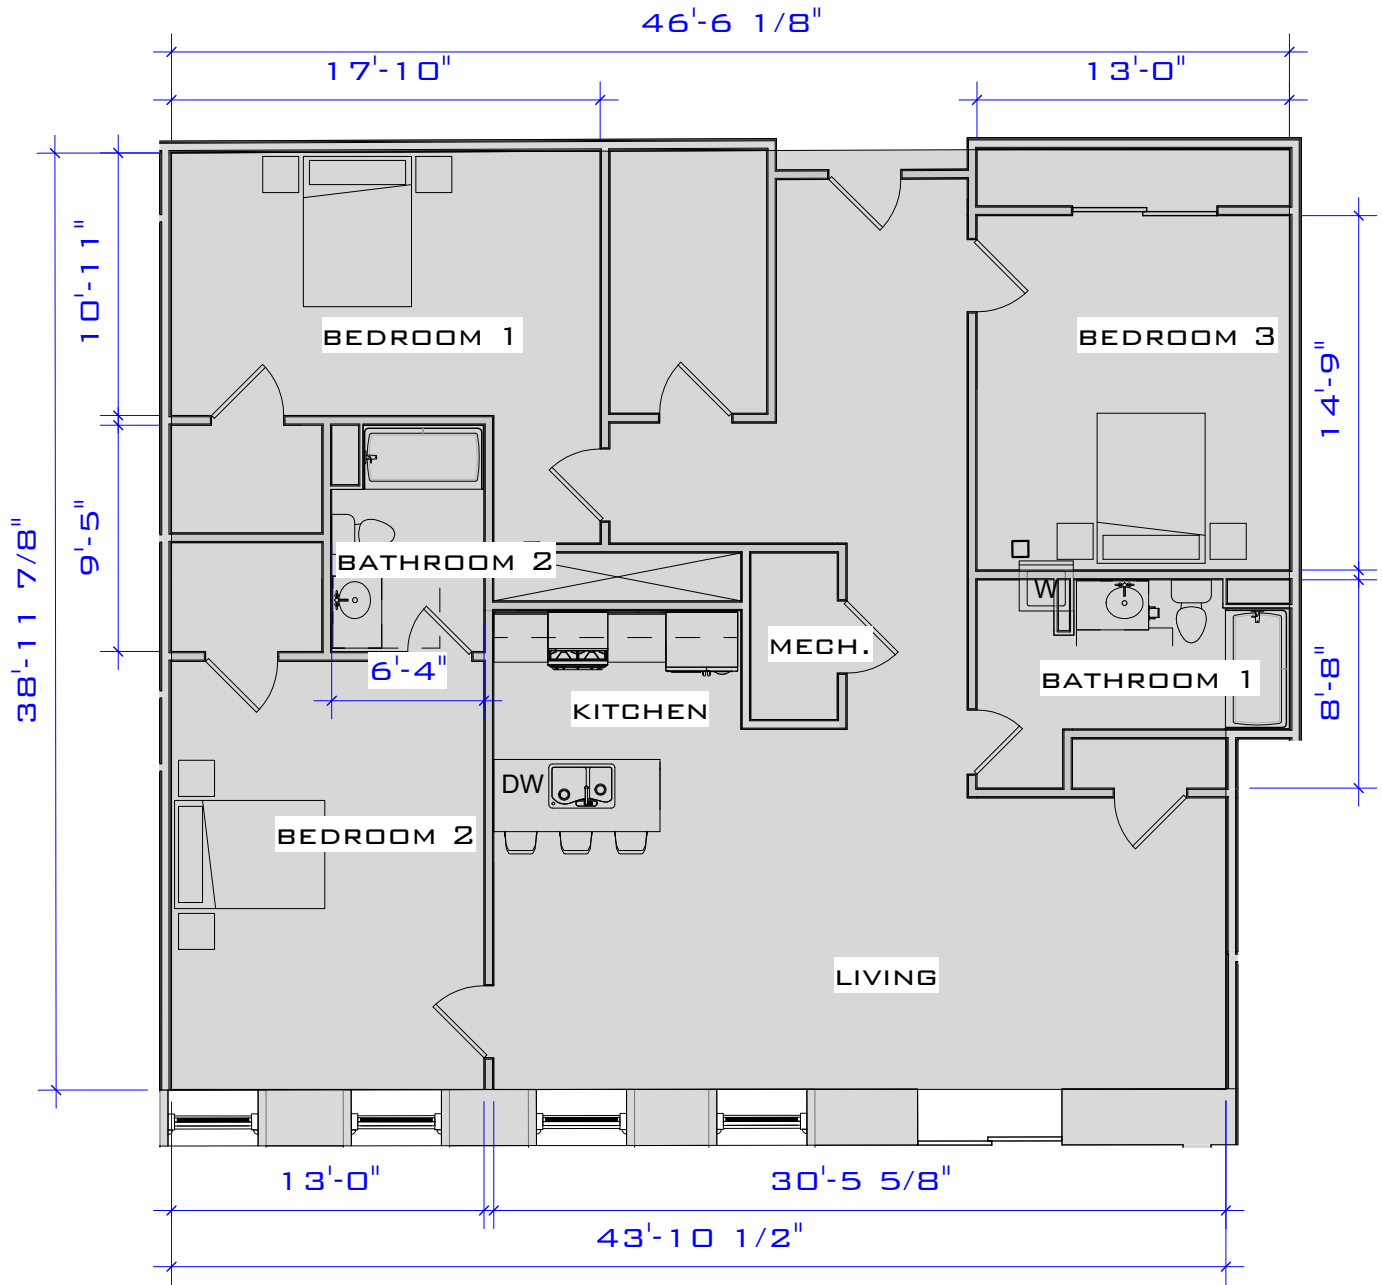

(SIMILAR UNITS: A-104)

ACTUAL SQUARE FOOTAGE MAY VARY




**JUNCTION
SHOP MILLS
JUNCTION SHOPS
MILL**

UNIT A-104 (1,776 S.F.)

Project number	Project Number
Date	Issue Date
Drawn by	Author
Checked by	Checker

SKA-1-4

Scale 1/8" = 1'-0"

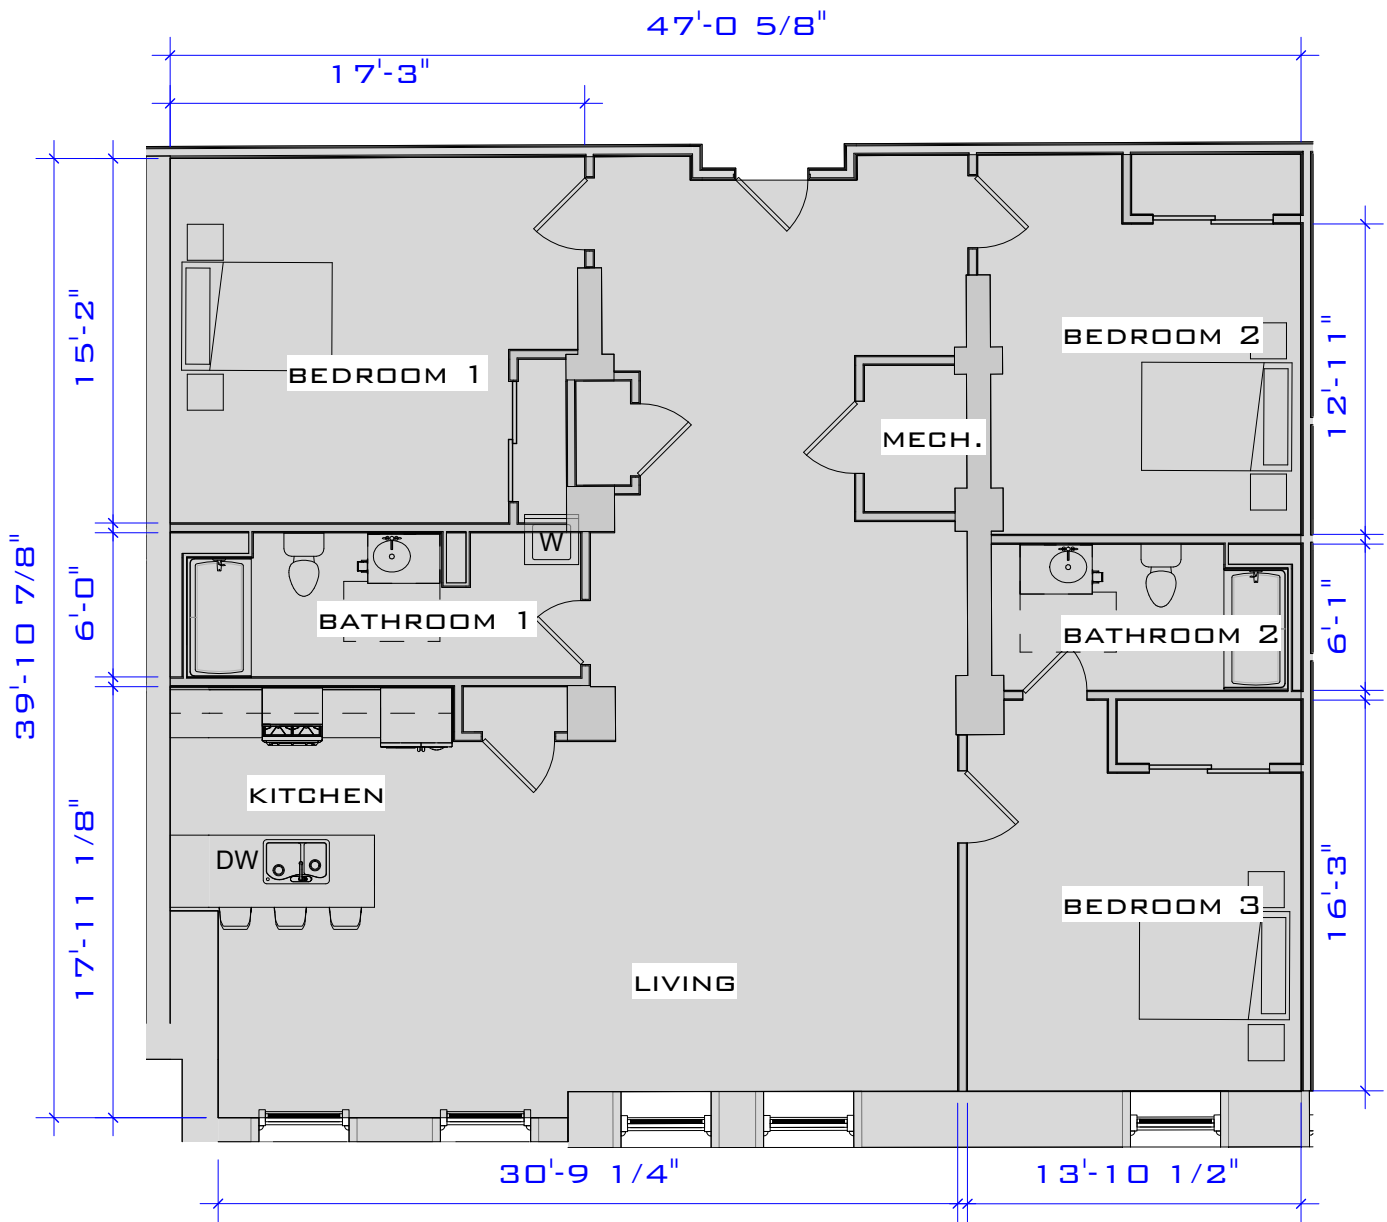

(SIMILAR UNITS: A-105)

ACTUAL SQUARE FOOTAGE MAY VARY




**JUNCTION
SHOP MILLS**
JUNCTION SHOPS
MILL

UNIT A-105 (1,825 S.F.)

Project number	Project Number
Date	Issue Date
Drawn by	Author
Checked by	Checker

SKA-1-5

Scale 1/8" = 1'-0"

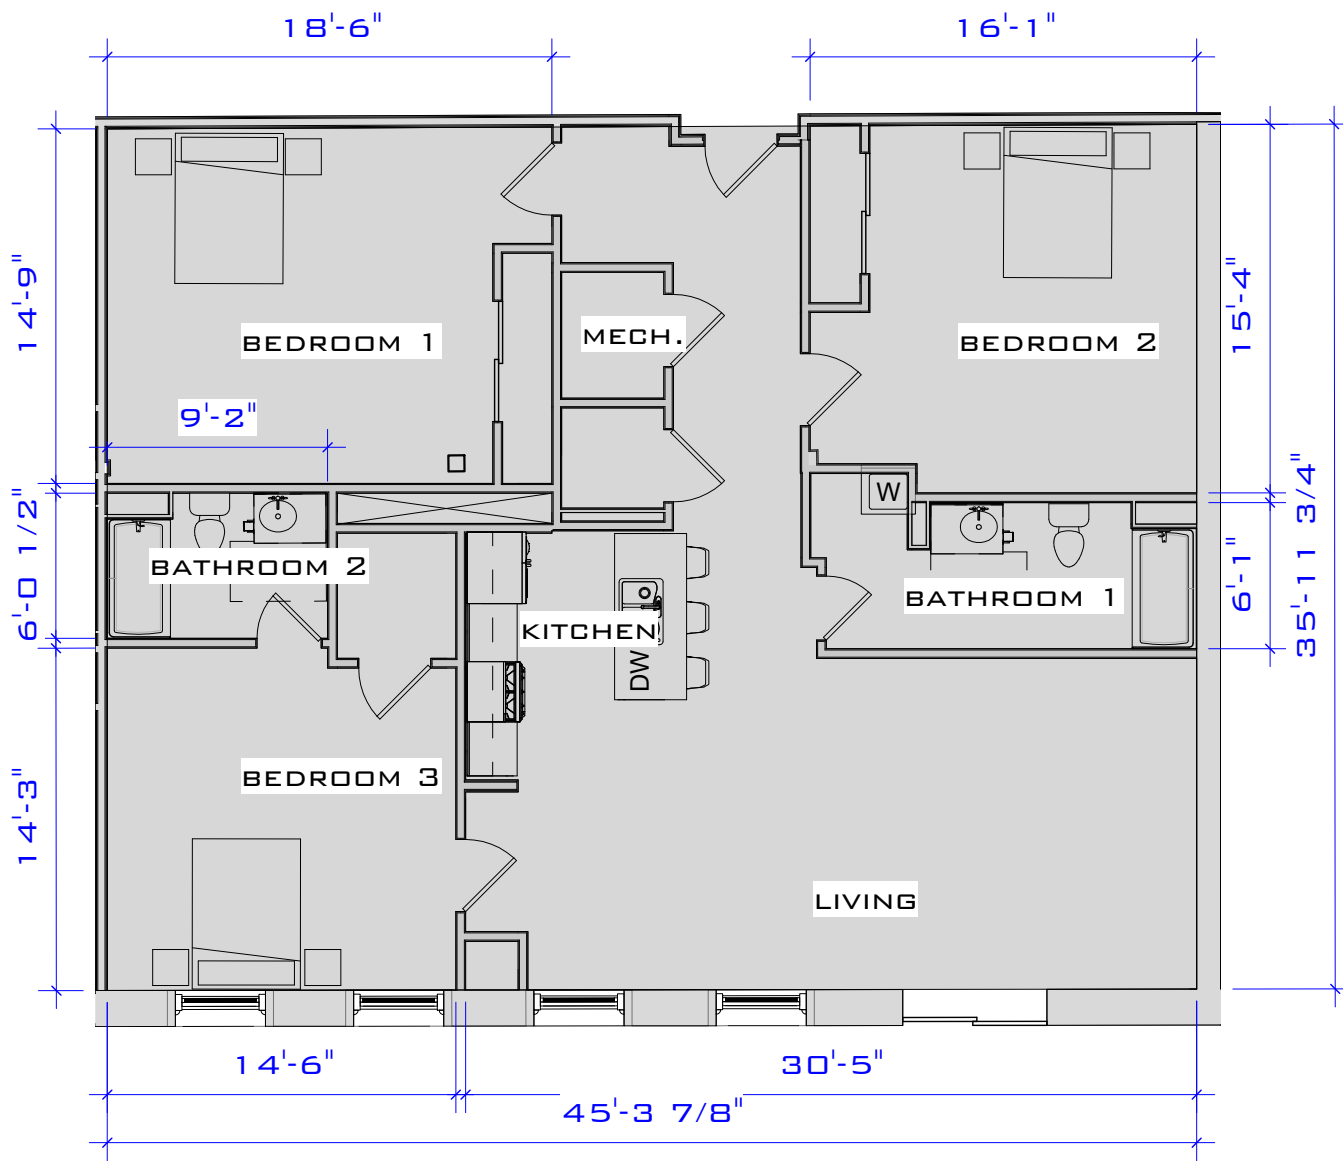

(SIMILAR UNITS: A-106)

ACTUAL SQUARE FOOTAGE MAY VARY




**JUNCTION
SHOP MILLS
JUNCTION SHOPS
MILL**

UNIT A-106 (1,628 S.F.)

Project number	Project Number
Date	Issue Date
Drawn by	Author
Checked by	Checker

SKA-1-6

Scale 1/8" = 1'-0"

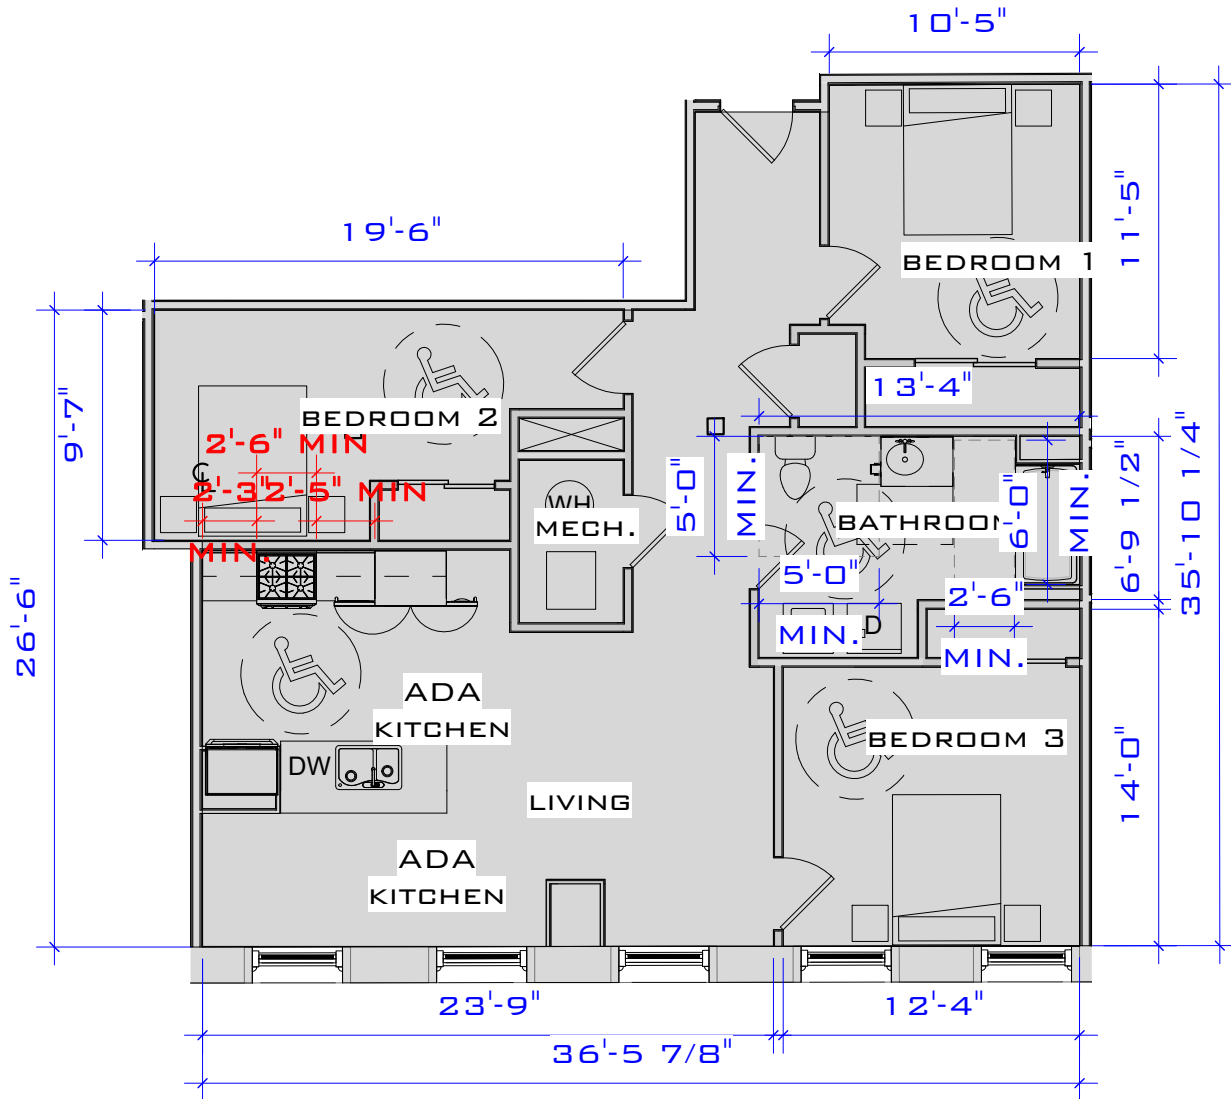

(SIMILAR UNITS: A-107)

ACTUAL SQUARE FOOTAGE MAY VARY




**JUNCTION
 SHOP MILLS**
 JUNCTION SHOPS
 MILL

UNIT A-107 (1,130 S.F.)

Project number	Project Number
Date	Issue Date
Drawn by	Author
Checked by	Checker

SKA-1-7

Scale 1/8" = 1'-0"

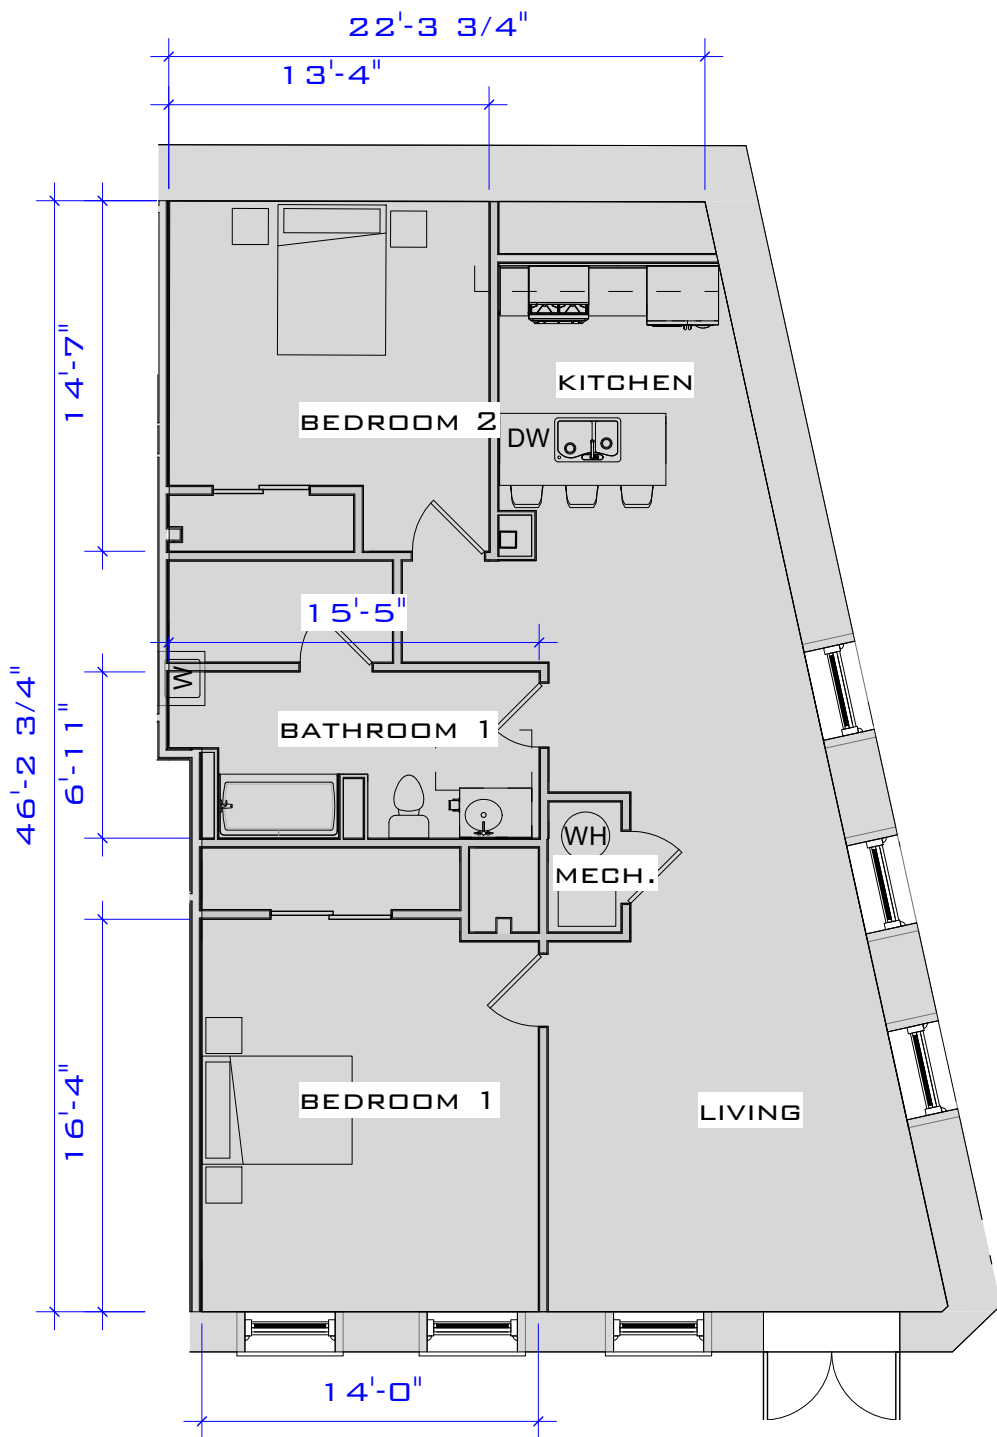

(SIMILAR UNITS: A-108)

ACTUAL SQUARE FOOTAGE MAY VARY




**JUNCTION
SHOP MILLS
JUNCTION SHOPS
MILL**

UNIT A-108 (1,230 S.F.)

Project number	Project Number
Date	Issue Date
Drawn by	Author
Checked by	Checker

SKA-1-8

Scale 1/8" = 1'-0"

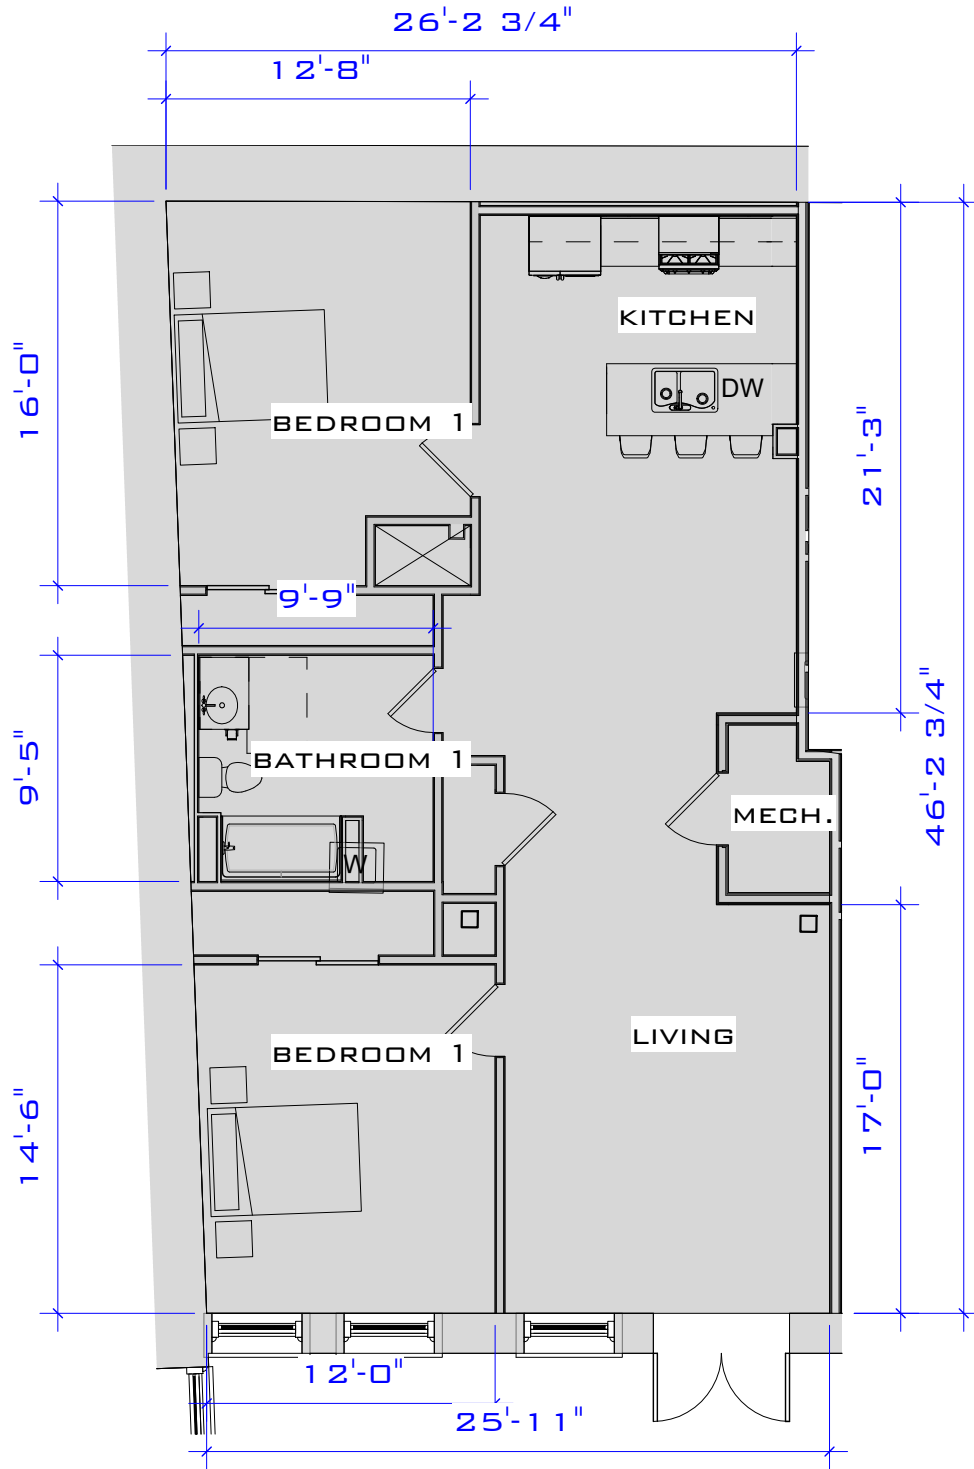

(SIMILAR UNITS: A-109)

ACTUAL SQUARE FOOTAGE MAY VARY




**JUNCTION
SHOP MILLS
JUNCTION SHOPS
MILL**

UNIT A-109 (1,206 S.F.)

Project number	Project Number
Date	Issue Date
Drawn by	Author
Checked by	Checker

SKA-1-9

Scale 1/8" = 1'-0"

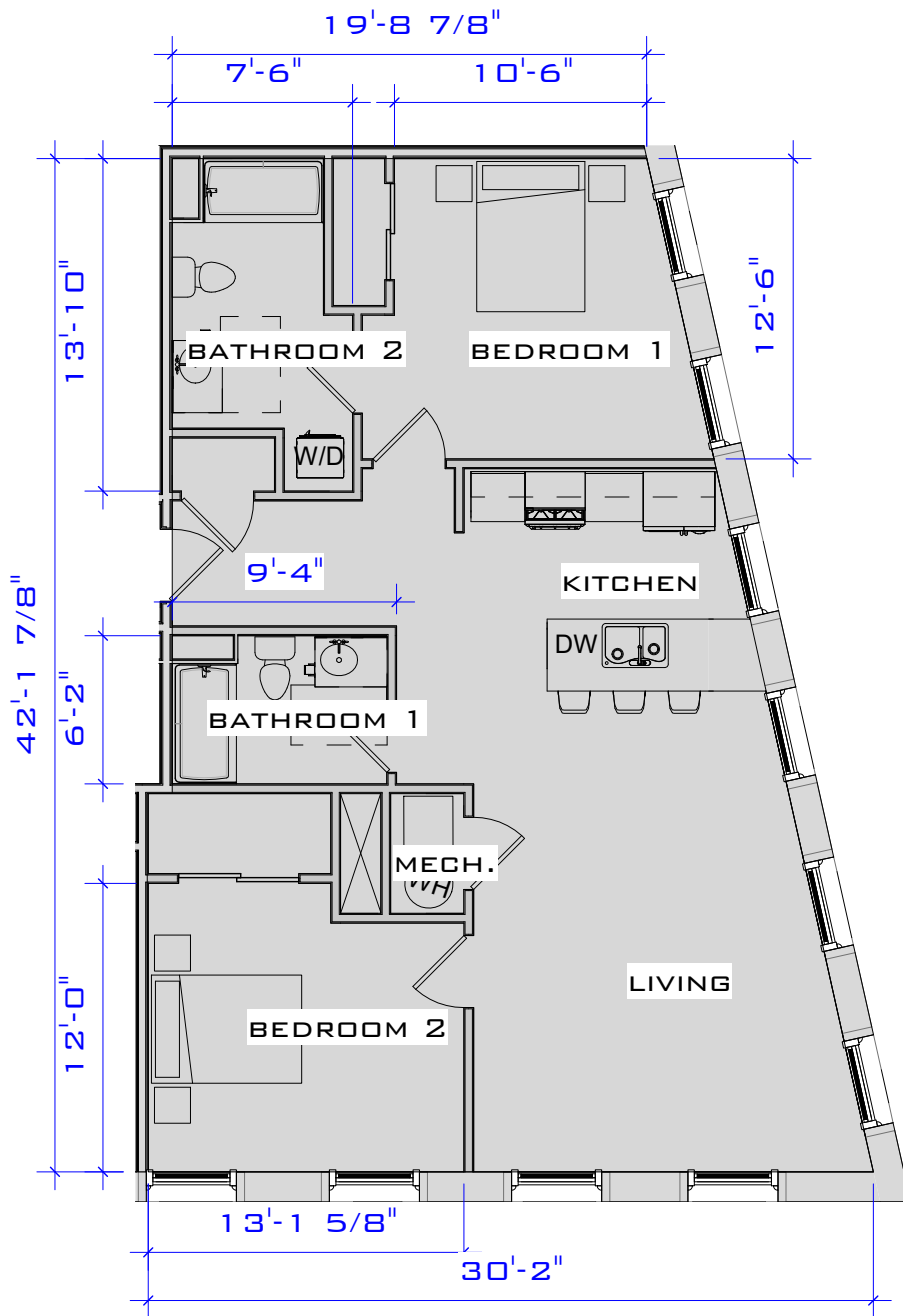


(SIMILAR UNITS: A-201, A-301, A-401)
 ACTUAL SQUARE FOOTAGE MAY VARY



**JUNCTION
 SHOP MILLS**
 JUNCTION SHOPS
 MILL

UNIT A-201 (1,047 S.F.)

Project number	Project Number	SKA-1-10
Date	Issue Date	
Drawn by	Author	Scale 1/8" = 1'-0"
Checked by	Checker	

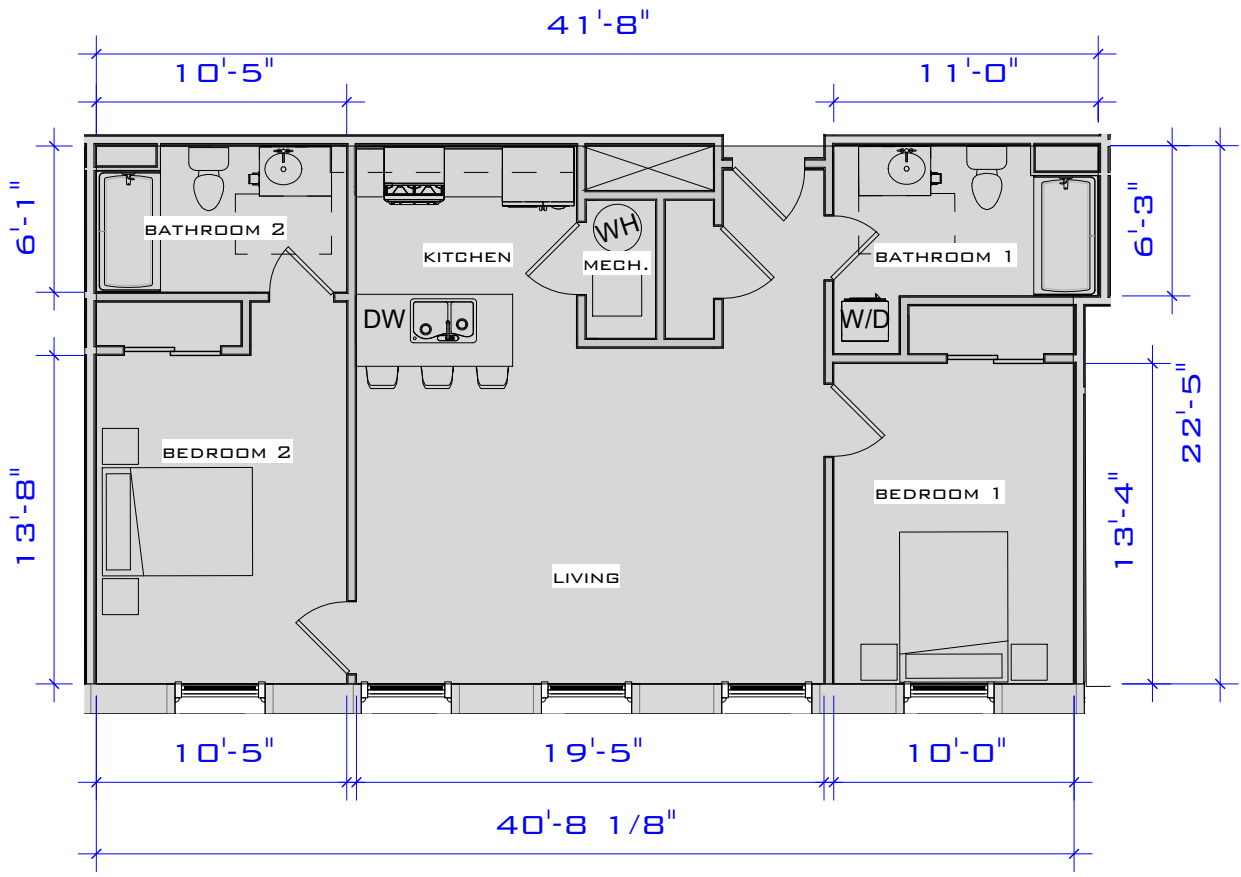

(SIMILAR UNITS: A-202, A-302, A-402)

ACTUAL SQUARE FOOTAGE MAY VARY



**JUNCTION
SHOP MILLS
JUNCTION SHOPS
MILL**

UNIT A-202

(916 S.F.)

Project number Project Number


Date Issue Date

Drawn by Author

Checked by Checker

SKA-1-11

Scale 1/8" = 1'-0"

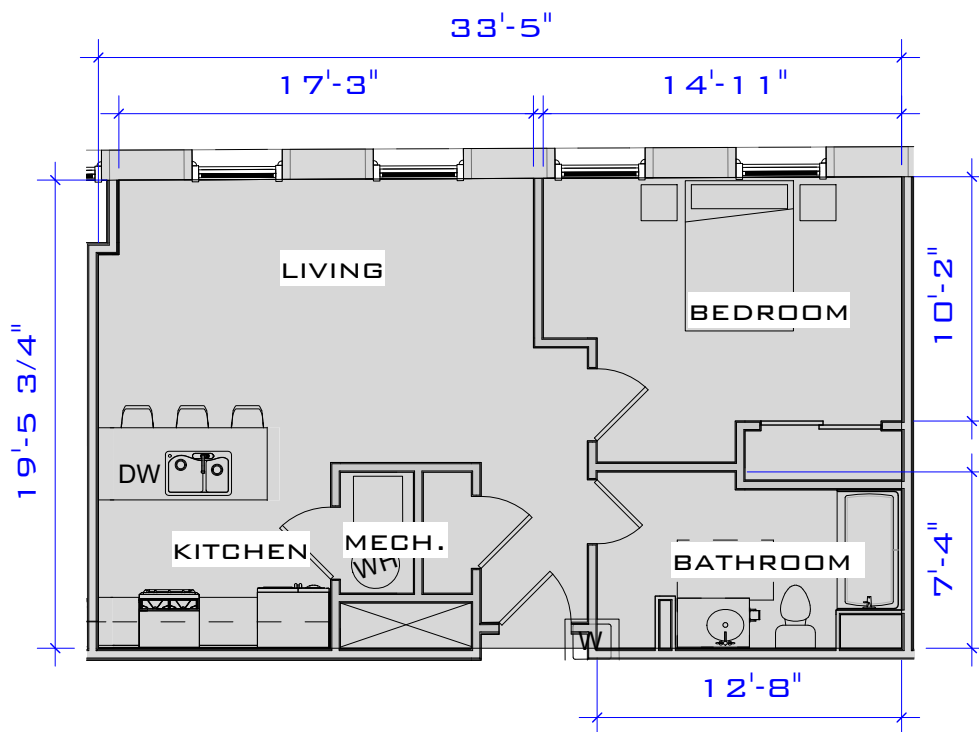

(SIMILAR UNITS: A-203, A-303, A-403
A-205, A-305, A-405)


ACTUAL SQUARE FOOTAGE MAY VARY



**JUNCTION
SHOP MILLS
JUNCTION SHOPS
MILL**

UNIT A-203 (650 S.F.)

Project number	Project Number	SKA-1-12
Date	Issue Date	
Drawn by	Author	
Checked by	Checker	
Scale		1/8" = 1'-0"

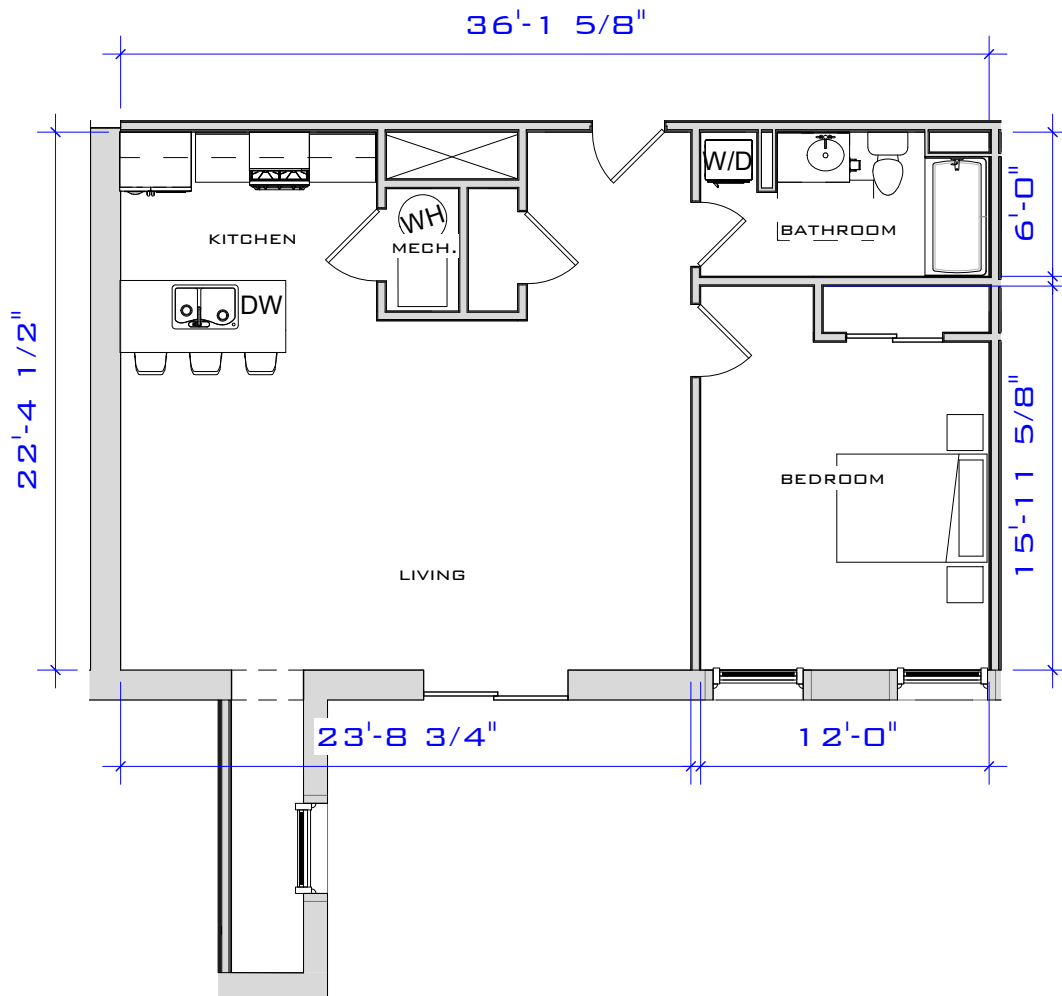


(SIMILAR UNITS: A-204, A-304, A-404)
 ACTUAL SQUARE FOOTAGE MAY VARY



**JUNCTION
 SHOP MILLS
 JUNCTION SHOPS
 MILL**

UNIT A-204 (810 S.F.)

Project number	Project Number	SKA-1-13
Date	Issue Date	
Drawn by	Author	
Checked by	Checker	
Scale		1/8" = 1'-0"

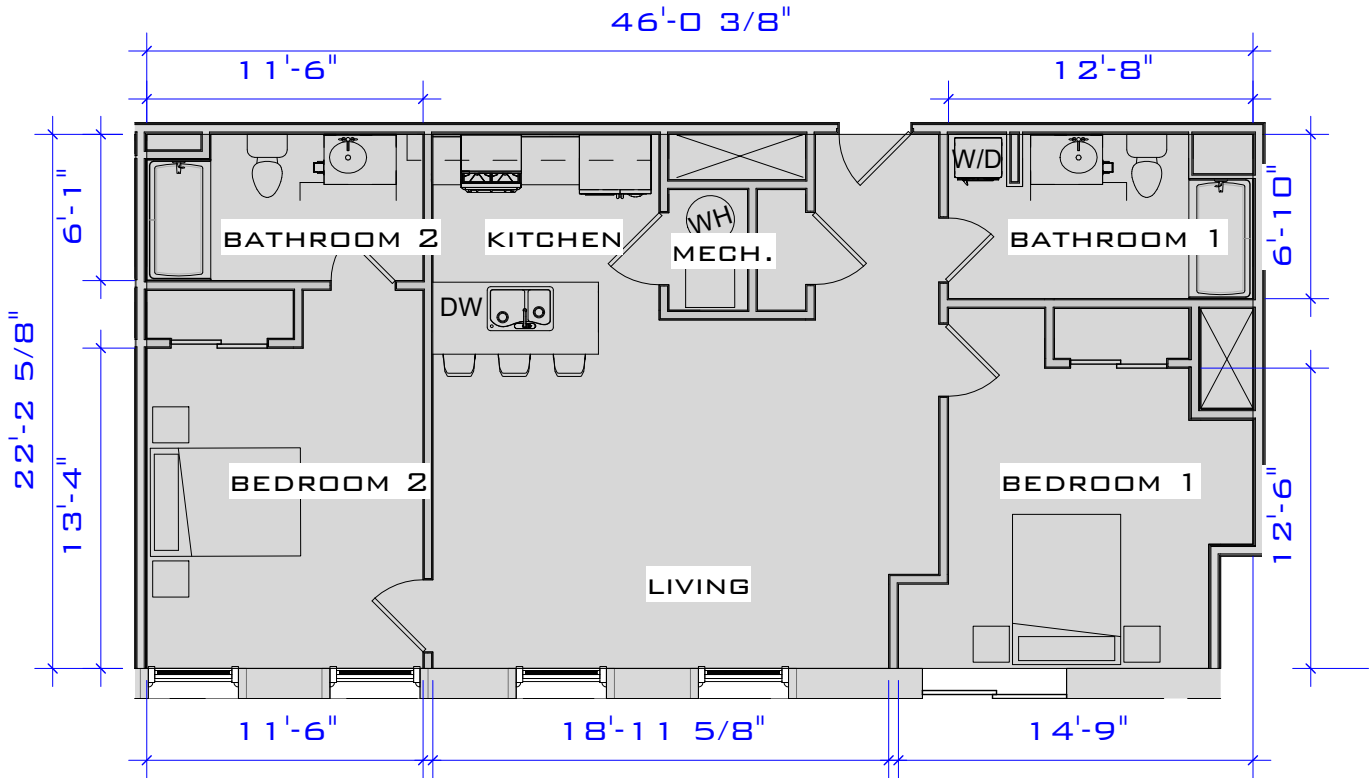

(SIMILAR UNITS: A-206, A-306, A-406)
 ACTUAL SQUARE FOOTAGE MAY VARY



JUNCTION SHOP MILLS
 JUNCTION SHOPS MILL


UNIT A-206

(1,013 S.F.)

Project number	Project Number
Date	Issue Date
Drawn by	Author
Checked by	Checker

SKA-1-14

Scale 1/8" = 1'-0"

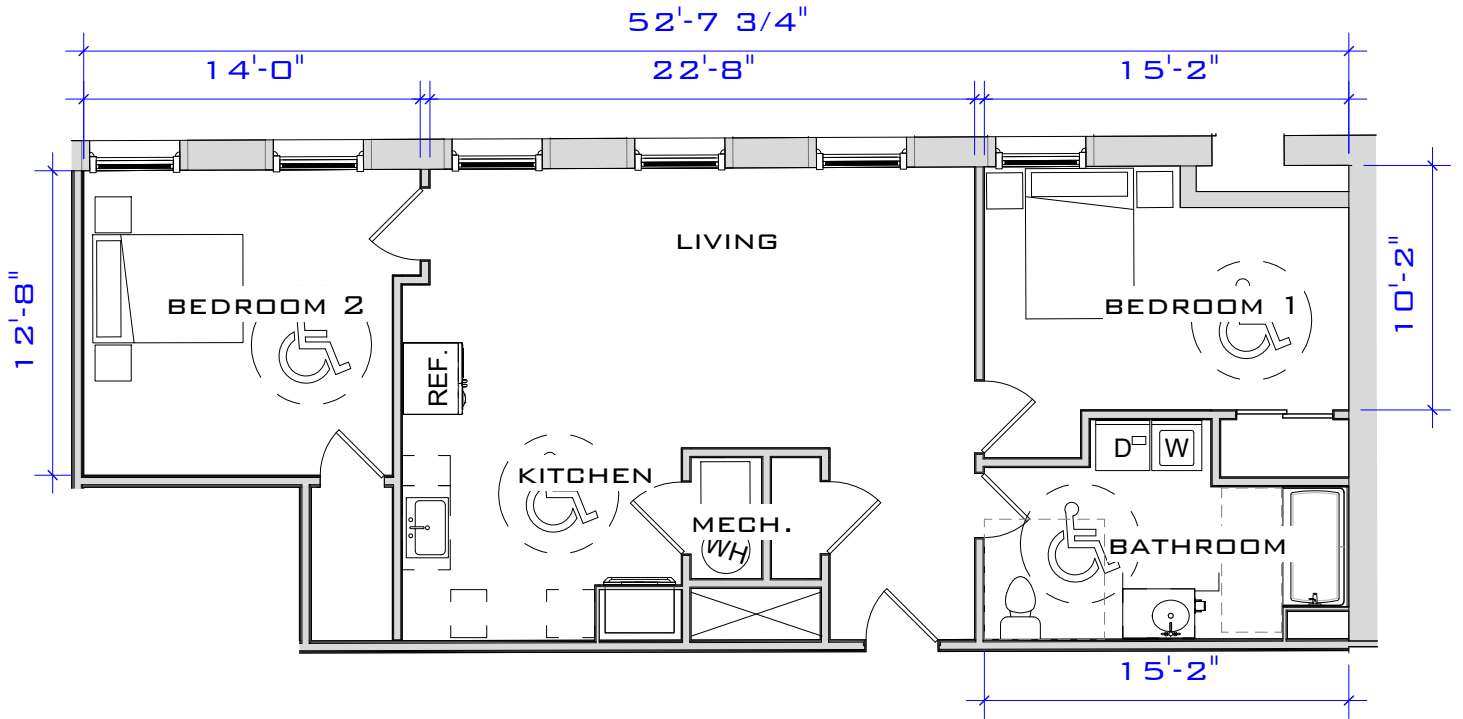

(SIMILAR UNITS: A-207, A-407)

ACTUAL SQUARE FOOTAGE MAY VARY



**JUNCTION
SHOP MILLS
JUNCTION SHOPS
MILL**

UNIT A-207

(950 S.F.)

Project number Project Number


Date Issue Date

Drawn by Author

Checked by Checker

SKA-1-15

Scale 1/8" = 1'-0"

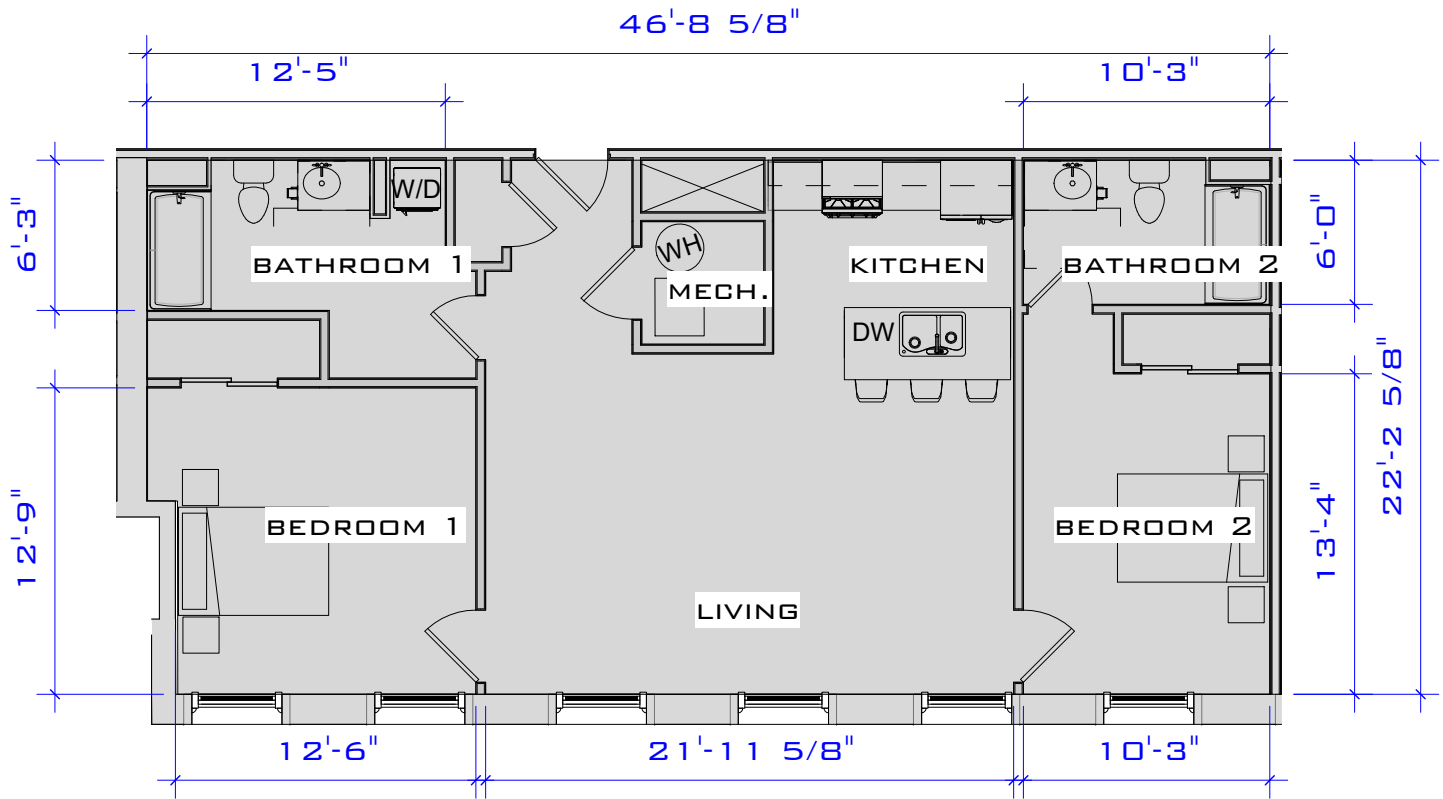


(SIMILAR UNITS: A-208, A-308, A-408)
 ACTUAL SQUARE FOOTAGE MAY VARY



**JUNCTION
 SHOP MILLS
 JUNCTION SHOPS
 MILL**

UNIT A-208 (1028 S.F.)

Project number	Project Number	SKA-1-16
Date	Issue Date	
Drawn by	Author	Scale 1/8" = 1'-0"
Checked by	Checker	

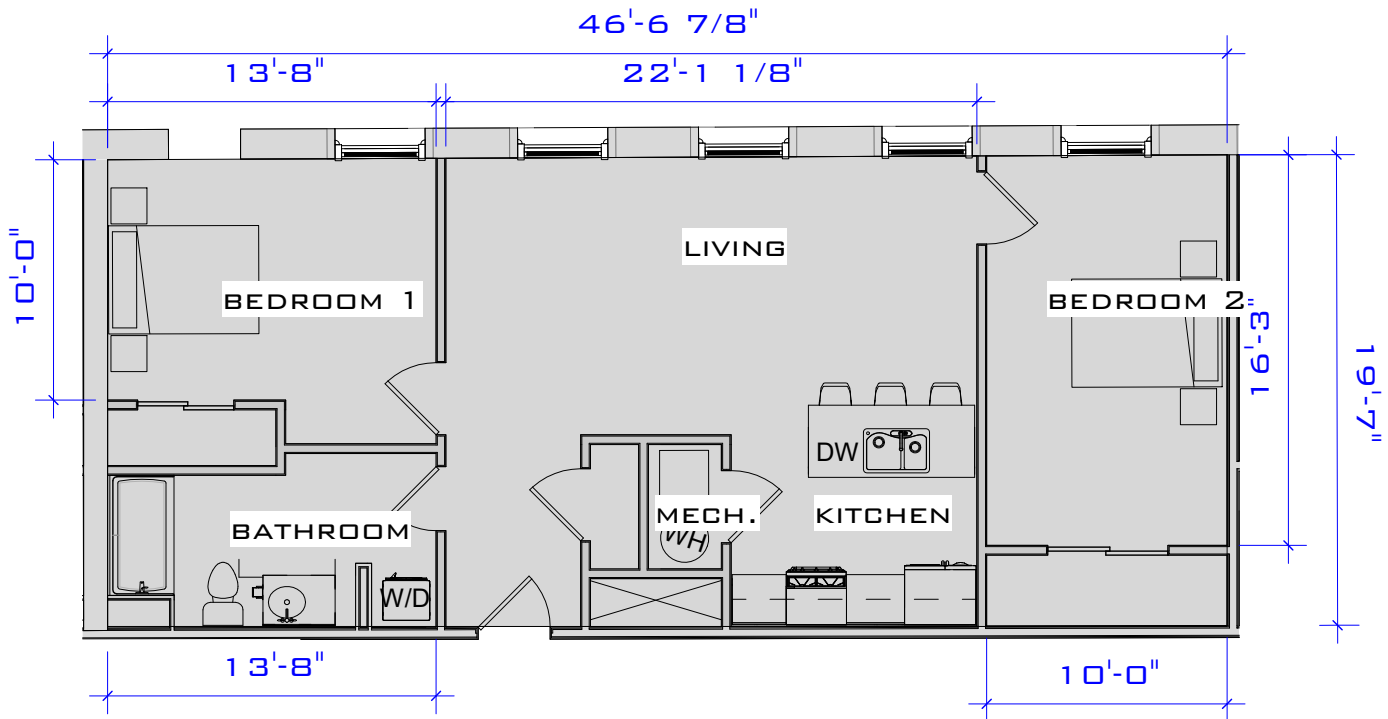


(SIMILAR UNITS: A-209, A-309, A-409)
 ACTUAL SQUARE FOOTAGE MAY VARY



JUNCTION SHOP MILLS
 JUNCTION SHOPS MILL

UNIT A-209 (885 S.F.)

Project number	Project Number	SKA-1-17
Date	Issue Date	
Drawn by	Author	
Checked by	Checker	
Scale		1/8" = 1'-0"

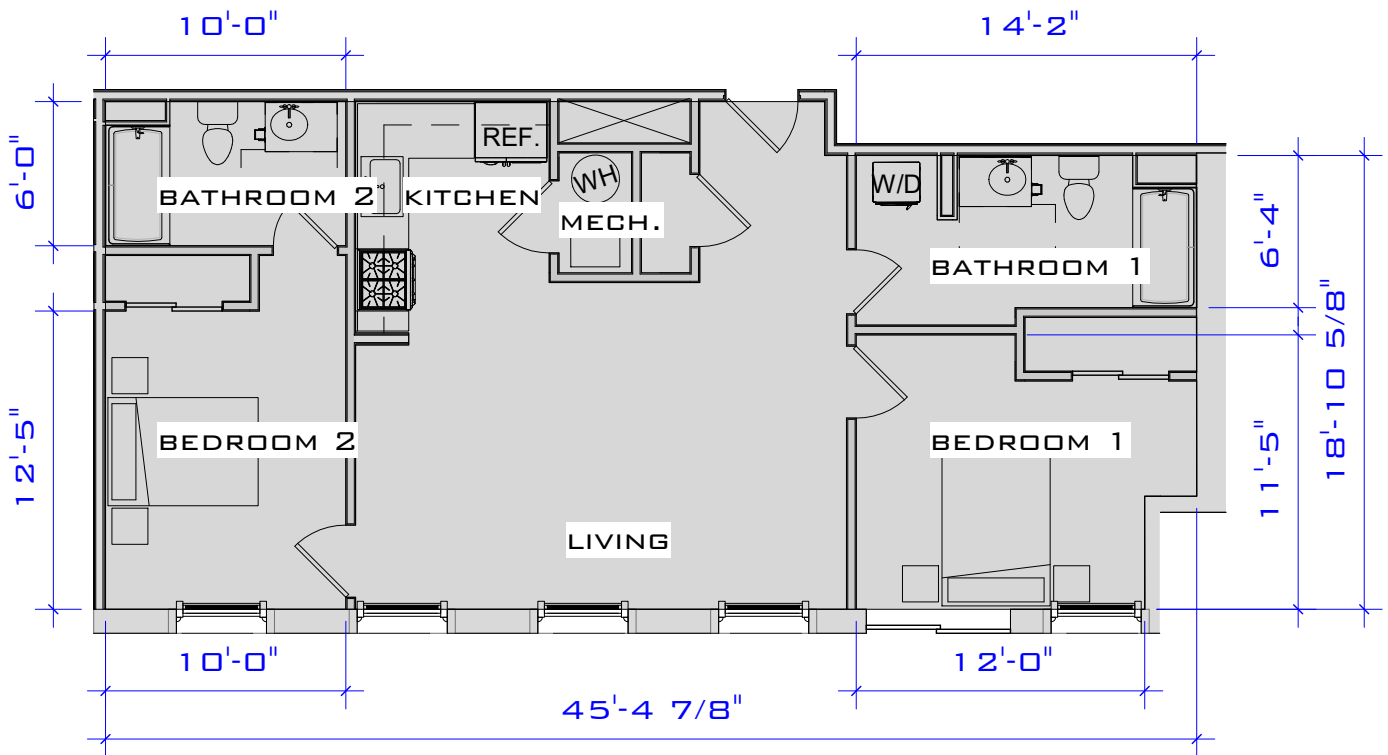


(SIMILAR UNITS: A-210, A-310, A-410)
 ACTUAL SQUARE FOOTAGE MAY VARY



**JUNCTION
 SHOP MILLS
 JUNCTION SHOPS
 MILL**

UNIT A-210 (913 S.F.)

Project number	Project Number	SKA-1-18
Date	Issue Date	
Drawn by	Author	
Checked by	Checker	
Scale		1/8" = 1'-0"

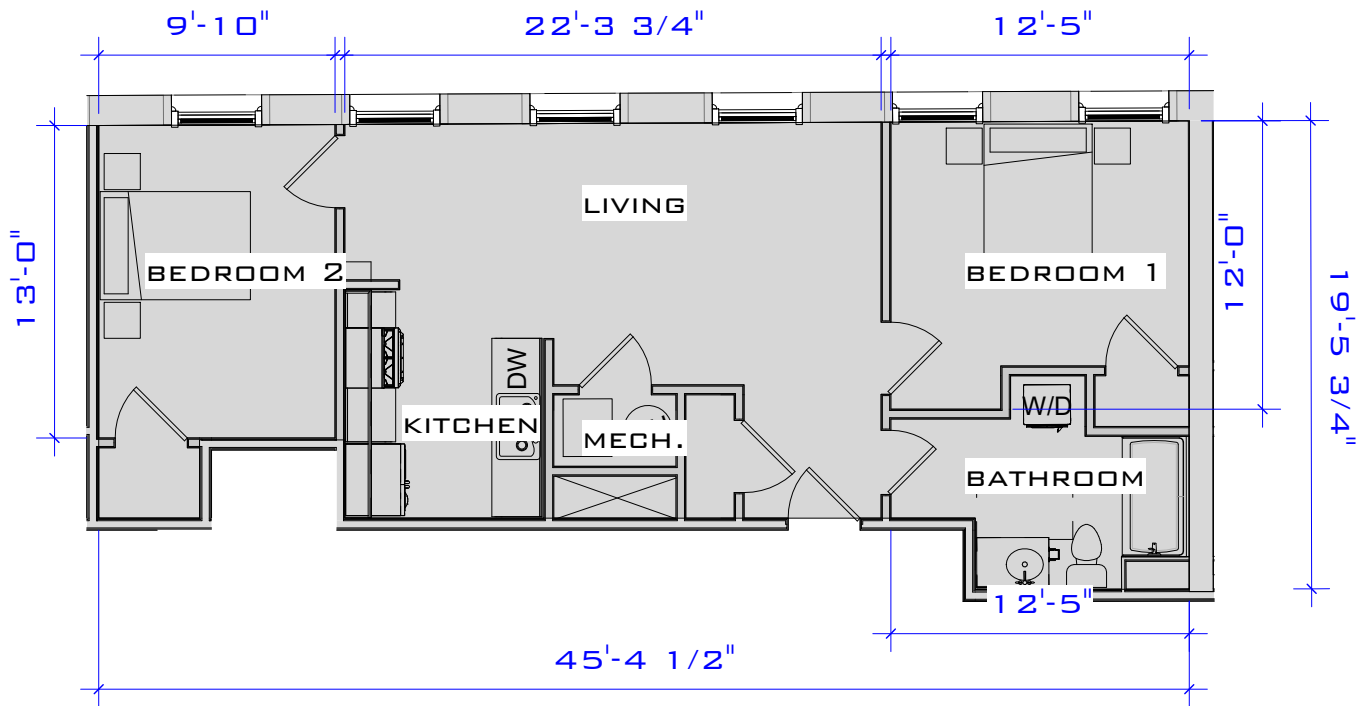

(SIMILAR UNITS: A-211, A-311, A-411)


ACTUAL SQUARE FOOTAGE MAY VARY



**JUNCTION
SHOP MILLS**
JUNCTION SHOPS
MILL

UNIT A-211 (746 S.F.)

Project number	Project Number	SKA-1-19
Date	Issue Date	
Drawn by	Author	
Checked by	Checker	
Scale		1/8" = 1'-0"

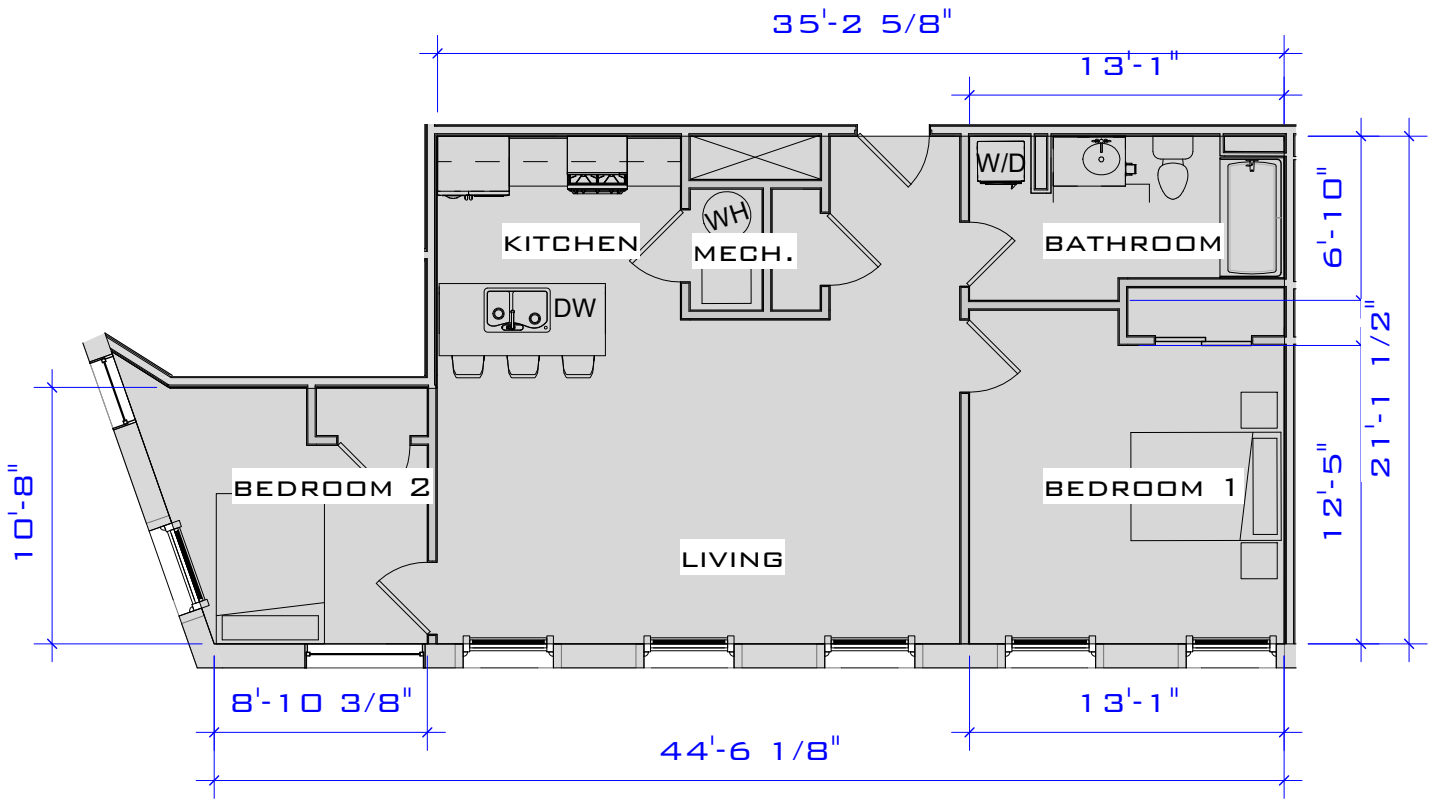


(SIMILAR UNITS: A-212, A-312, A-412)
 ACTUAL SQUARE FOOTAGE MAY VARY



JUNCTION SHOP MILLS
 JUNCTION SHOPS MILL

UNIT A-212 (865 S.F.)

Project number	Project Number	SKA-1-20
Date	Issue Date	
Drawn by	Author	Scale 1/8" = 1'-0"
Checked by	Checker	

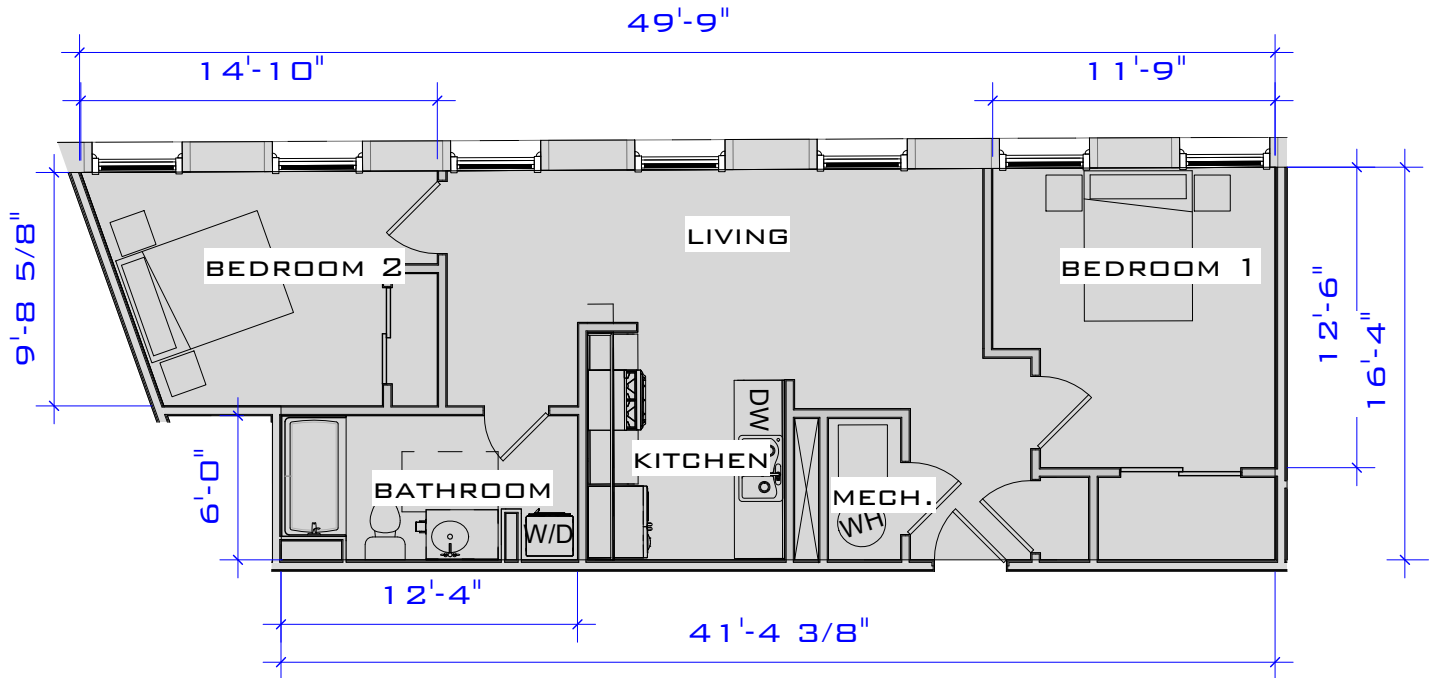


(SIMILAR UNITS: A-213, A-313, A-413)
 ACTUAL SQUARE FOOTAGE MAY VARY



**JUNCTION
 SHOP MILLS
 JUNCTION SHOPS
 MILL**

UNIT A-213 (737 S.F.)

Project number	Project Number	SKA-1-21
Date	Issue Date	
Drawn by	Author	Scale 1/8" = 1'-0"
Checked by	Checker	

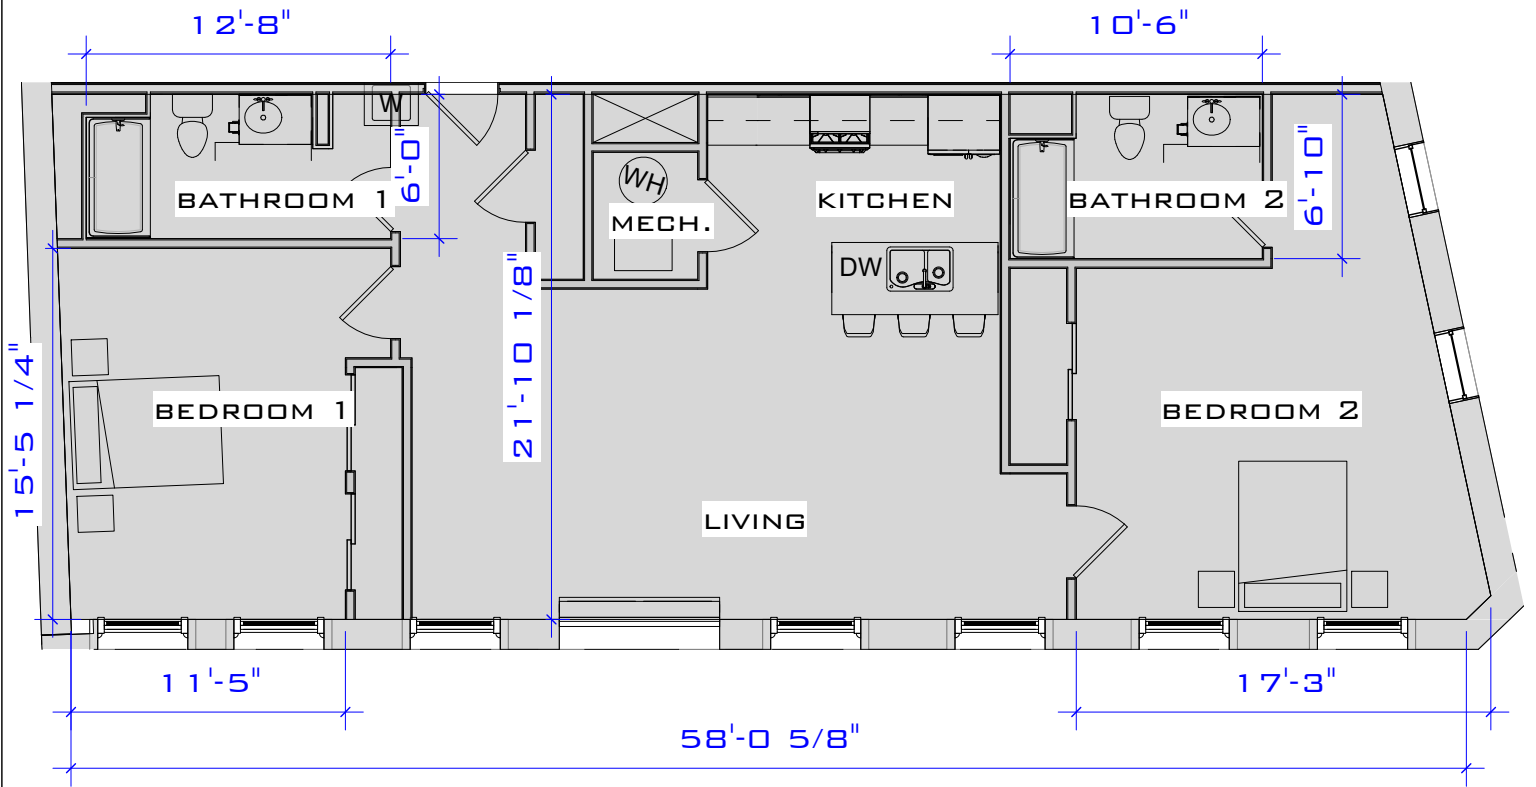

(SIMILAR UNITS: A-214)


ACTUAL SQUARE FOOTAGE MAY VARY



**JUNCTION
SHOP MILLS**
JUNCTION SHOPS
MILL

UNIT A-214 (1,252 S.F.)

Project number	Project Number	SKA-1-22
Date	Issue Date	
Drawn by	Author	
Checked by	Checker	
Scale		1/8" = 1'-0"

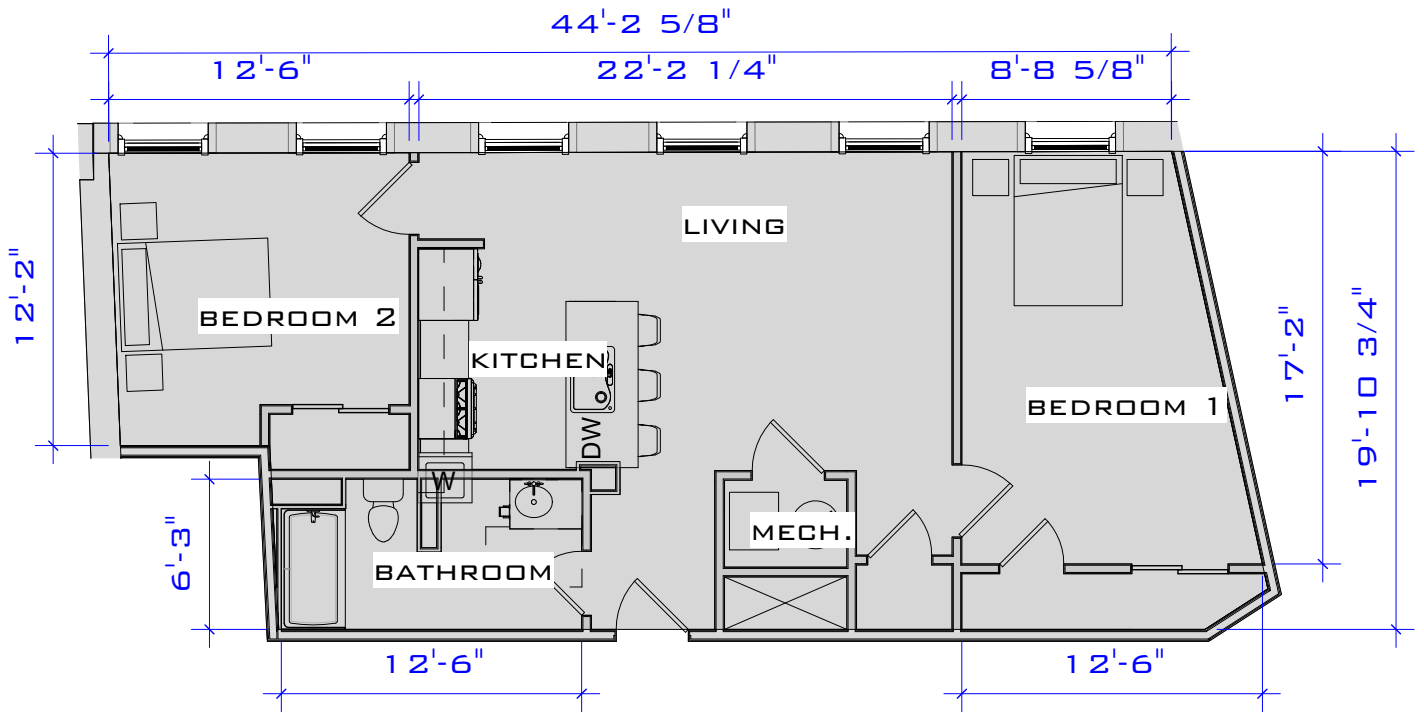

(SIMILAR UNITS: A-215)


ACTUAL SQUARE FOOTAGE MAY VARY



**JUNCTION
SHOP MILLS**
JUNCTION SHOPS
MILL

UNIT A-215 (864 S.F.)

Project number	Project Number	SKA-1-23
Date	Issue Date	
Drawn by	Author	
Checked by	Checker	
Scale		1/8" = 1'-0"

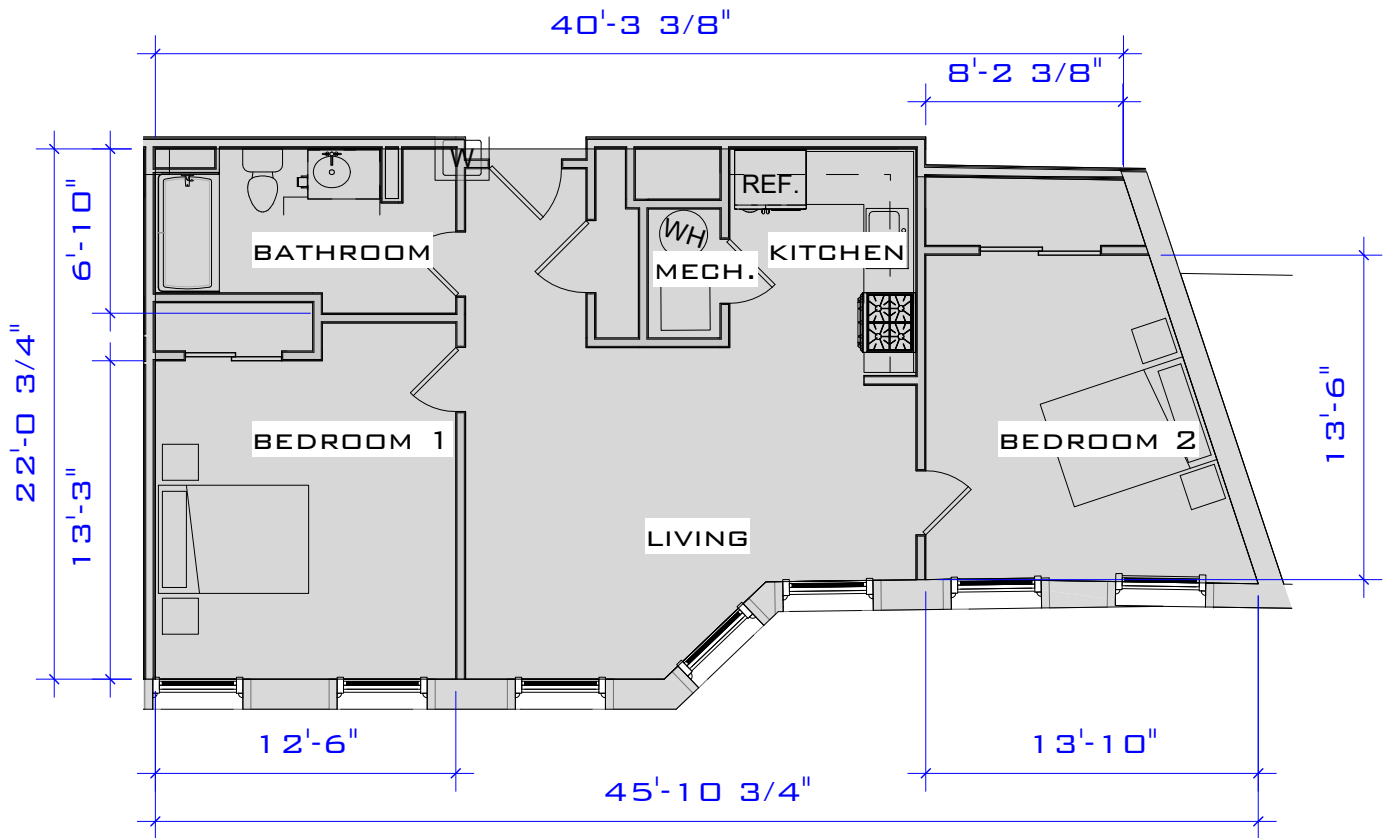

(SIMILAR UNITS: A-314, A-414)


ACTUAL SQUARE FOOTAGE MAY VARY



**JUNCTION
SHOP MILLS**
JUNCTION SHOPS
MILL

UNIT A-314 (856 S.F.)

Project number	Project Number	SKA-1-24
Date	Issue Date	
Drawn by	Author	
Checked by	Checker	
Scale		1/8" = 1'-0"

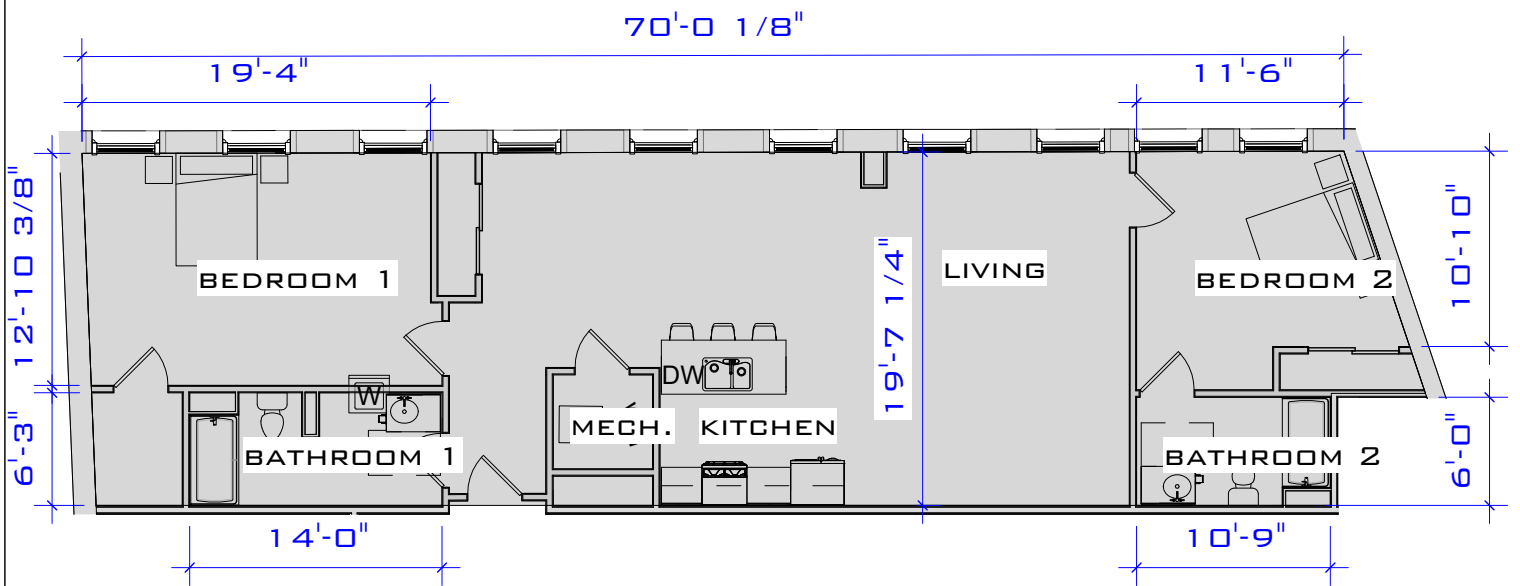

(SIMILAR UNITS: A-315, A-415)


ACTUAL SQUARE FOOTAGE MAY VARY



**JUNCTION
SHOP MILLS**
JUNCTION SHOPS
MILL

UNIT A-315 (1390 S.F.)

Project number	Project Number	SKA-1-25
Date	Issue Date	
Drawn by	Author	
Checked by	Checker	
		Scale 3/32" = 1'-0"

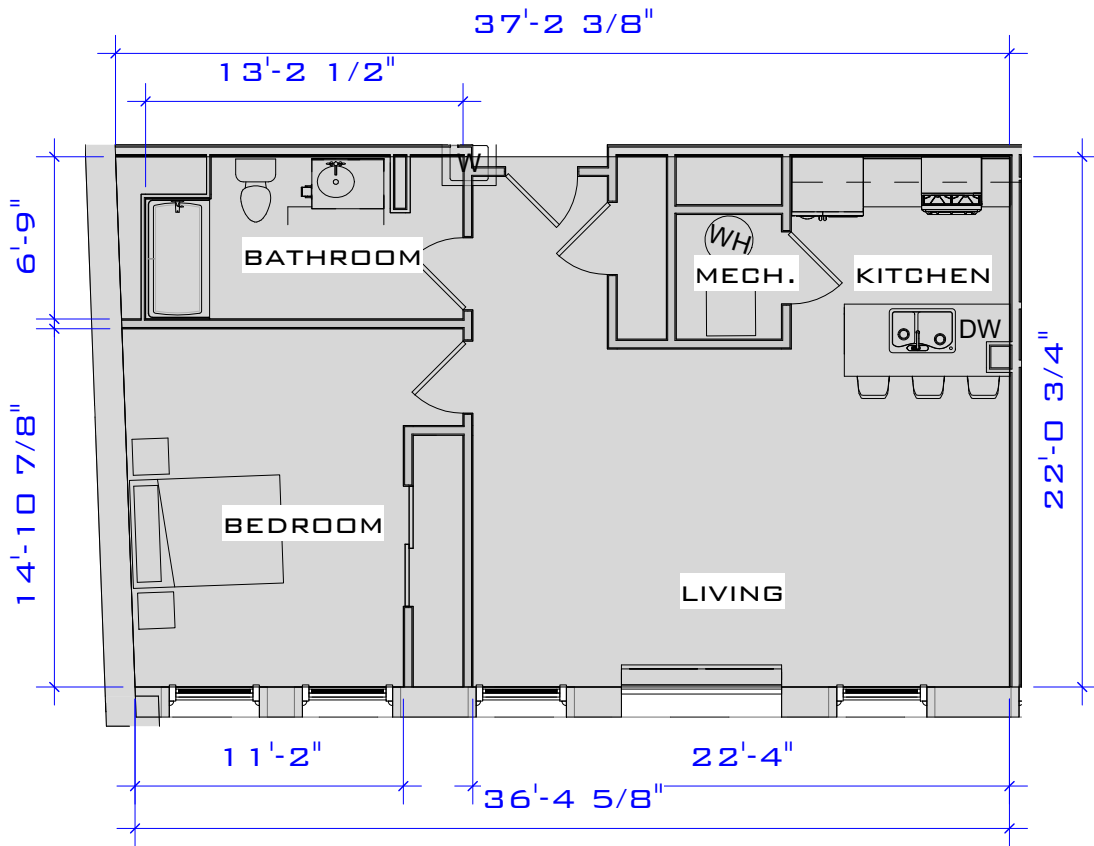

(SIMILAR UNITS: A-316, A-416)


ACTUAL SQUARE FOOTAGE MAY VARY



**JUNCTION
SHOP MILLS
JUNCTION SHOPS
MILL**

UNIT A-316 (812 S.F.)

Project number	Project Number	SKA-1-26
Date	Issue Date	
Drawn by	Author	Scale 1/8" = 1'-0"
Checked by	Checker	

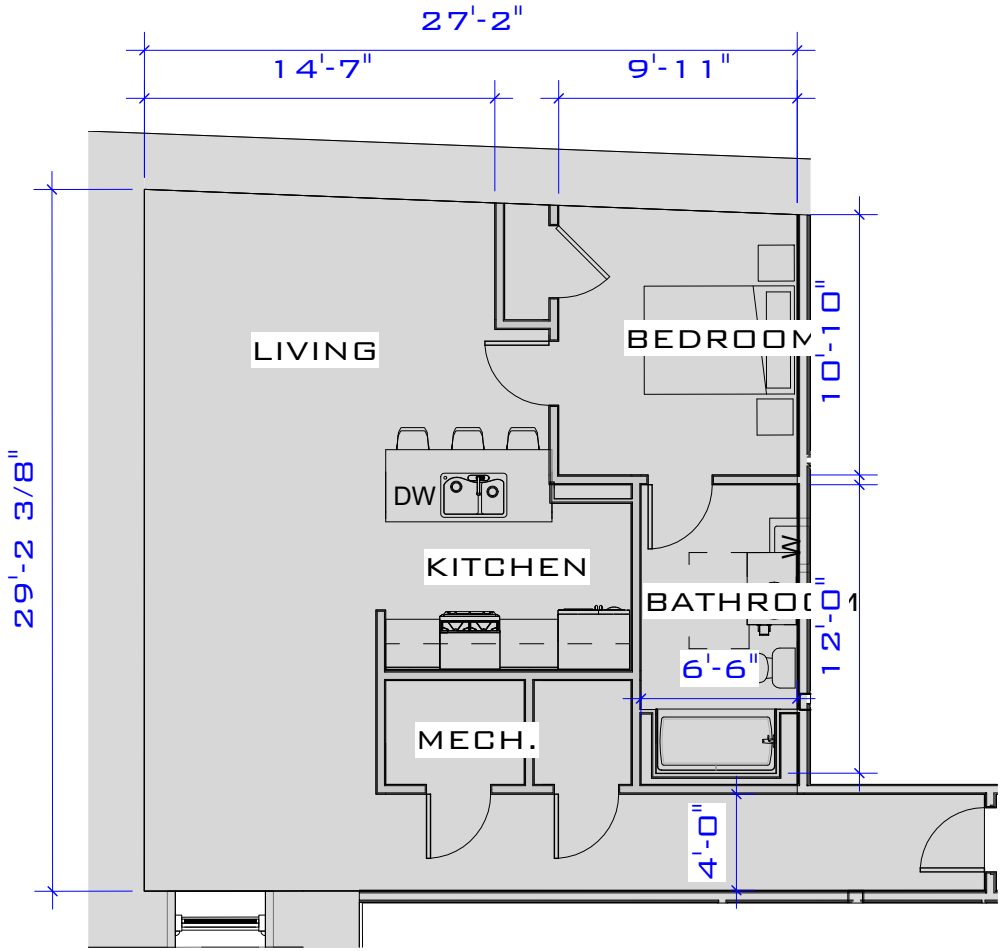

(SIMILAR UNITS: B-101)


ACTUAL SQUARE FOOTAGE MAY VARY



**JUNCTION
SHOP MILLS
JUNCTION SHOPS
MILL**

UNIT B-101 (810 S.F.)

Project number	Project Number	SKA-2-1
Date	Issue Date	
Drawn by	Author	
Checked by	Checker	
Scale		1/8" = 1'-0"

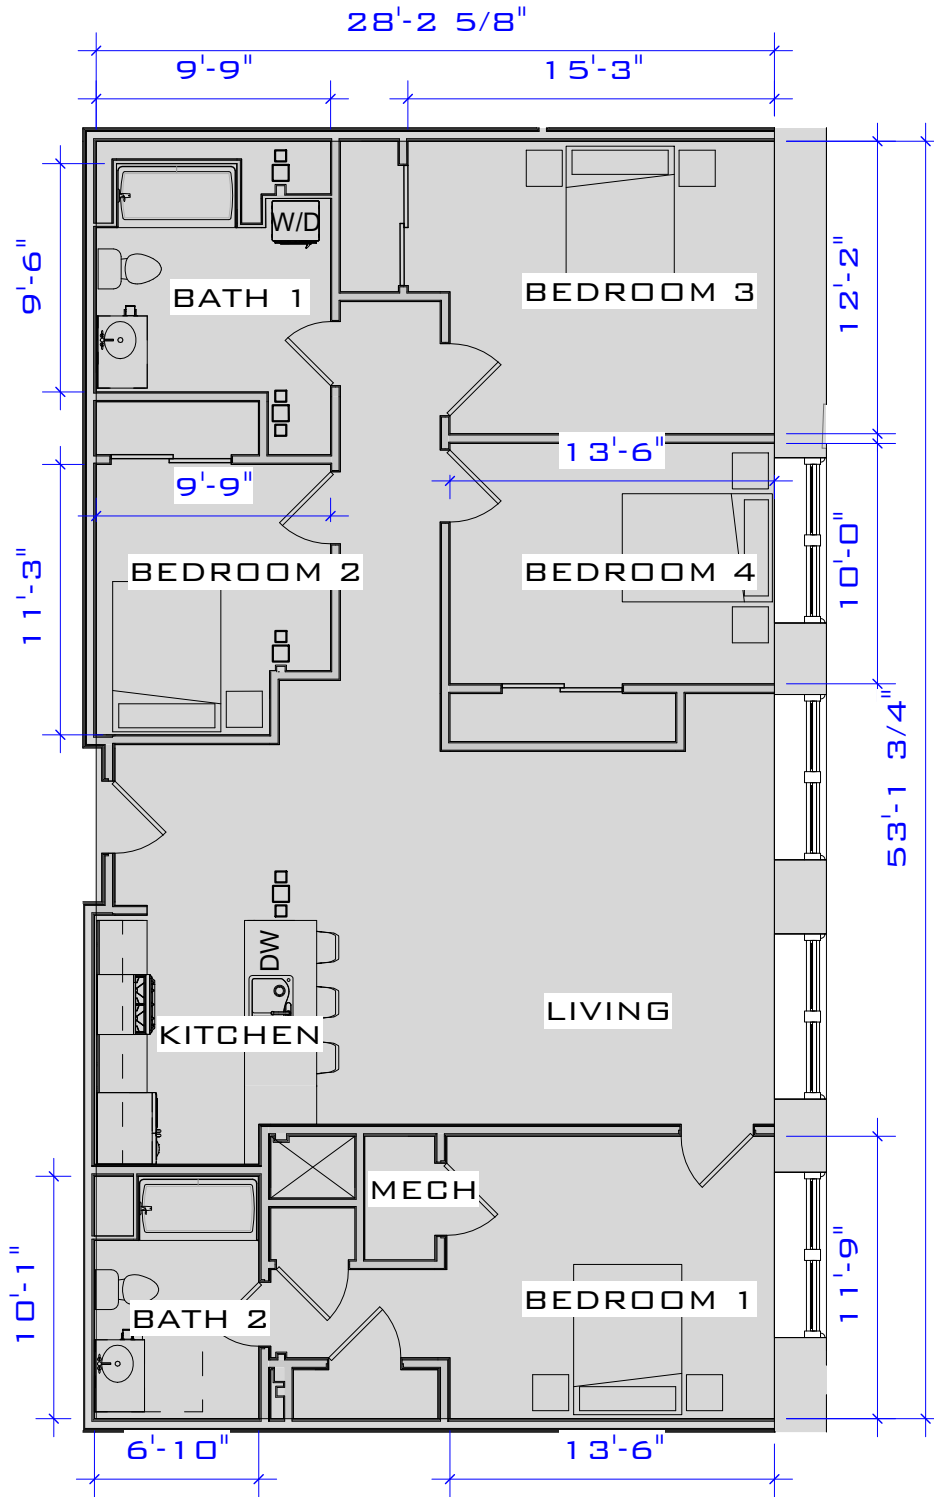

(SIMILAR UNITS: B-102, B-304)

ACTUAL SQUARE FOOTAGE MAY VARY



**JUNCTION
SHOP MILLS
JUNCTION SHOPS
MILL**


UNIT B-102

(1,500 S.F.)

Project number	Project Number
Date	Issue Date
Drawn by	Author
Checked by	Checker

SKA-2-2

Scale 1/8" = 1'-0"

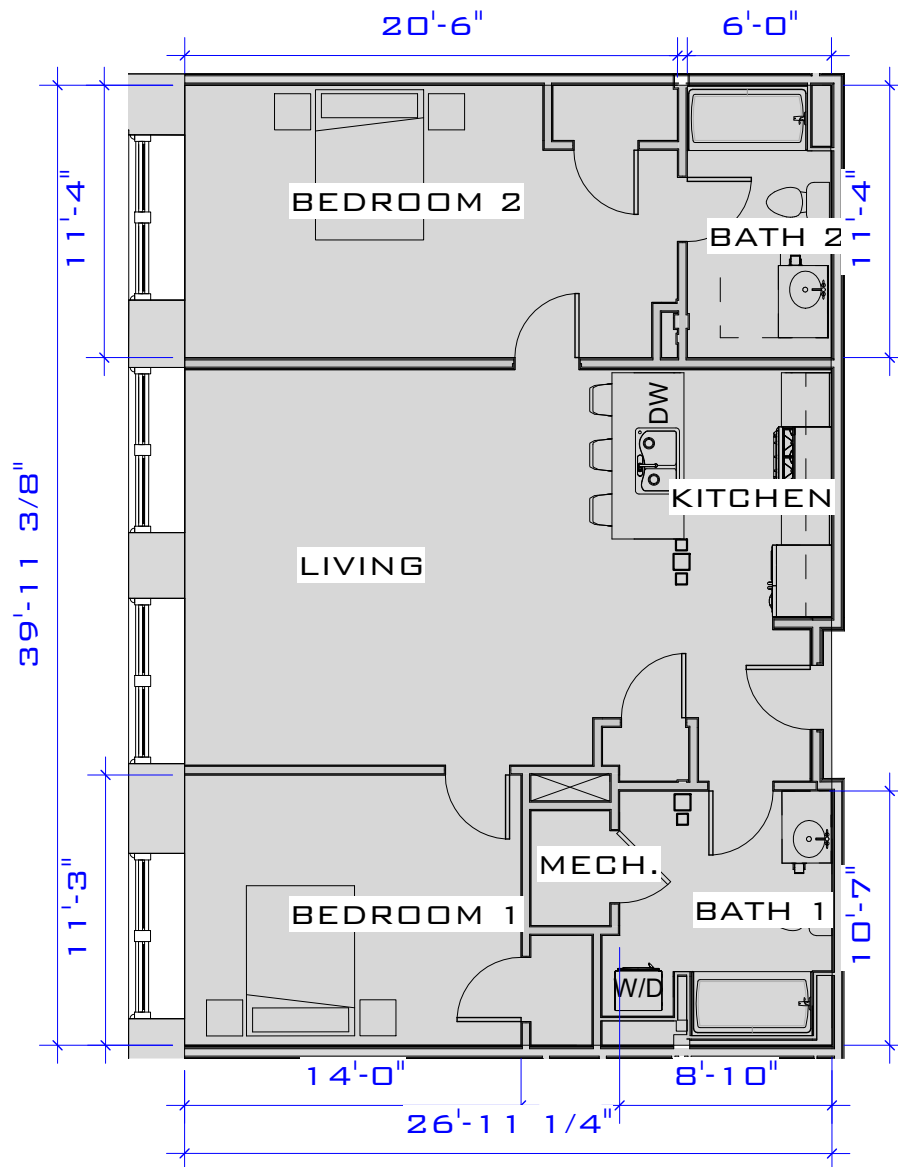

(SIMILAR UNITS: B-103, B-303)

ACTUAL SQUARE FOOTAGE MAY VARY




**JUNCTION
SHOP MILLS
JUNCTION SHOPS
MILL**

UNIT B-103 (1,075 S.F.)

Project number	Project Number
Date	Issue Date
Drawn by	Author
Checked by	Checker

SKA-2-3

Scale 1/8" = 1'-0"

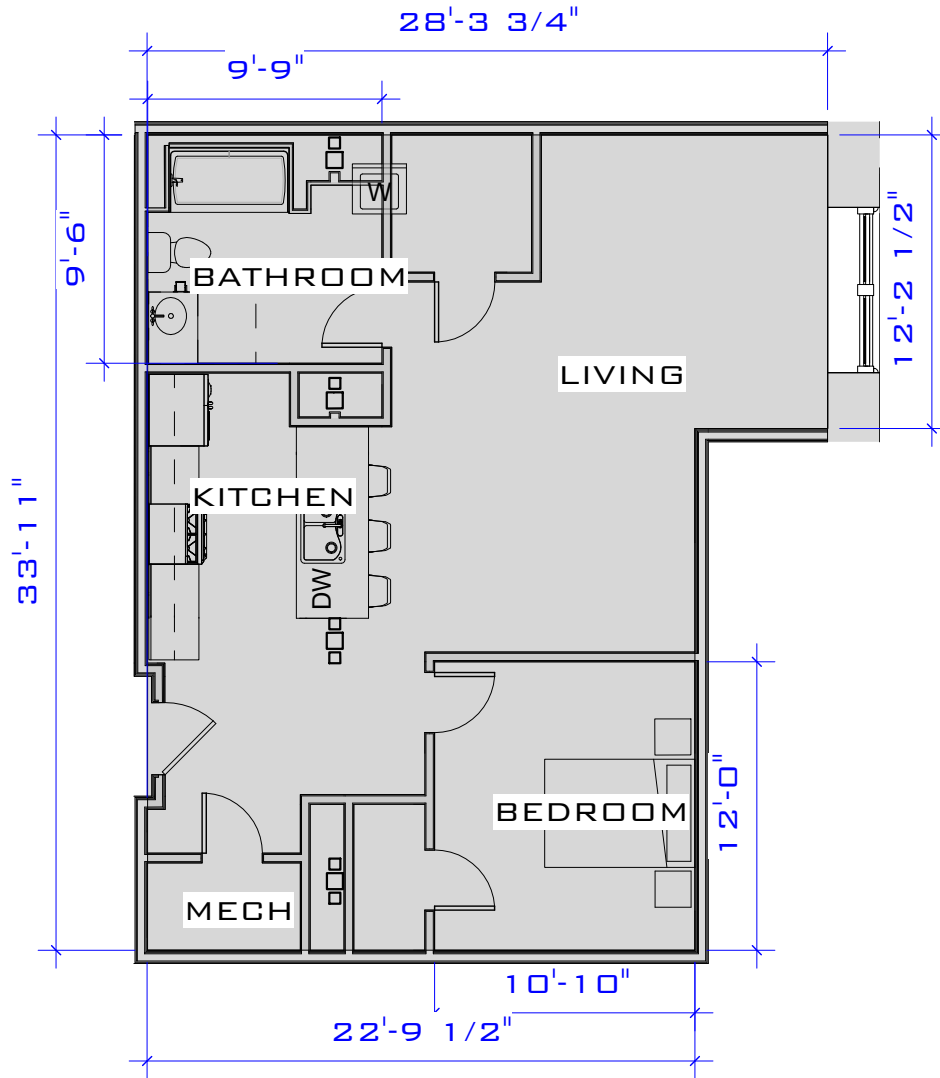

(SIMILAR UNITS: B-104)

ACTUAL SQUARE FOOTAGE MAY VARY




**JUNCTION
 SHOP MILLS**
 JUNCTION SHOPS
 MILL

UNIT B-104 (840 S.F.)

Project number	Project Number
Date	Issue Date
Drawn by	Author
Checked by	Checker

SKA-2-4

Scale 1/8" = 1'-0"

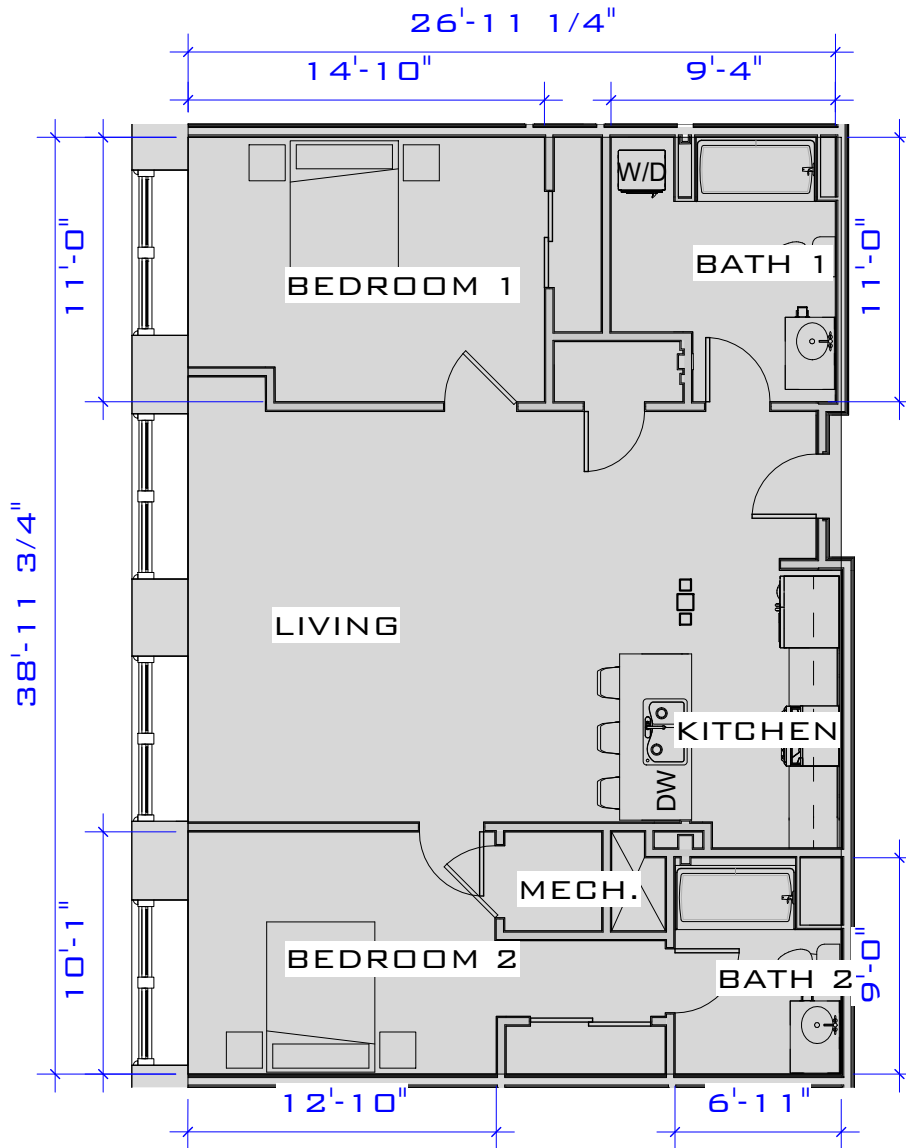

(SIMILAR UNITS: B-105, B-305)

ACTUAL SQUARE FOOTAGE MAY VARY




**JUNCTION
SHOP MILLS
JUNCTION SHOPS
MILL**

UNIT B-105 (1,060 S.F.)

Project number	Project Number
Date	Issue Date
Drawn by	Author
Checked by	Checker

SKA-2-5

Scale 1/8" = 1'-0"

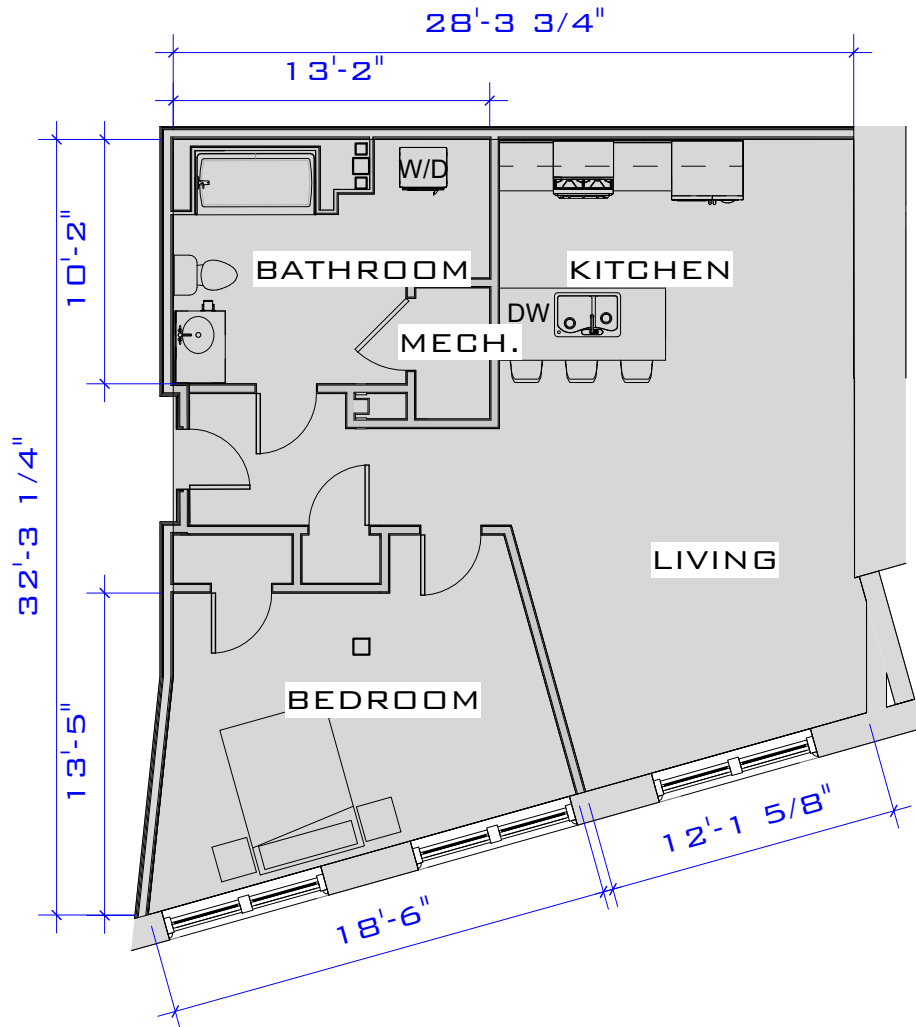

(SIMILAR UNITS: B-106, B-209,
B-308ADA, B-406)

ACTUAL SQUARE FOOTAGE MAY VARY




**JUNCTION
SHOP MILLS**
JUNCTION SHOPS
MILL

UNIT B-106 (800 S.F.)

Project number	Project Number
Date	Issue Date
Drawn by	Author
Checked by	Checker

SKA-2-6

Scale 1/8" = 1'-0"

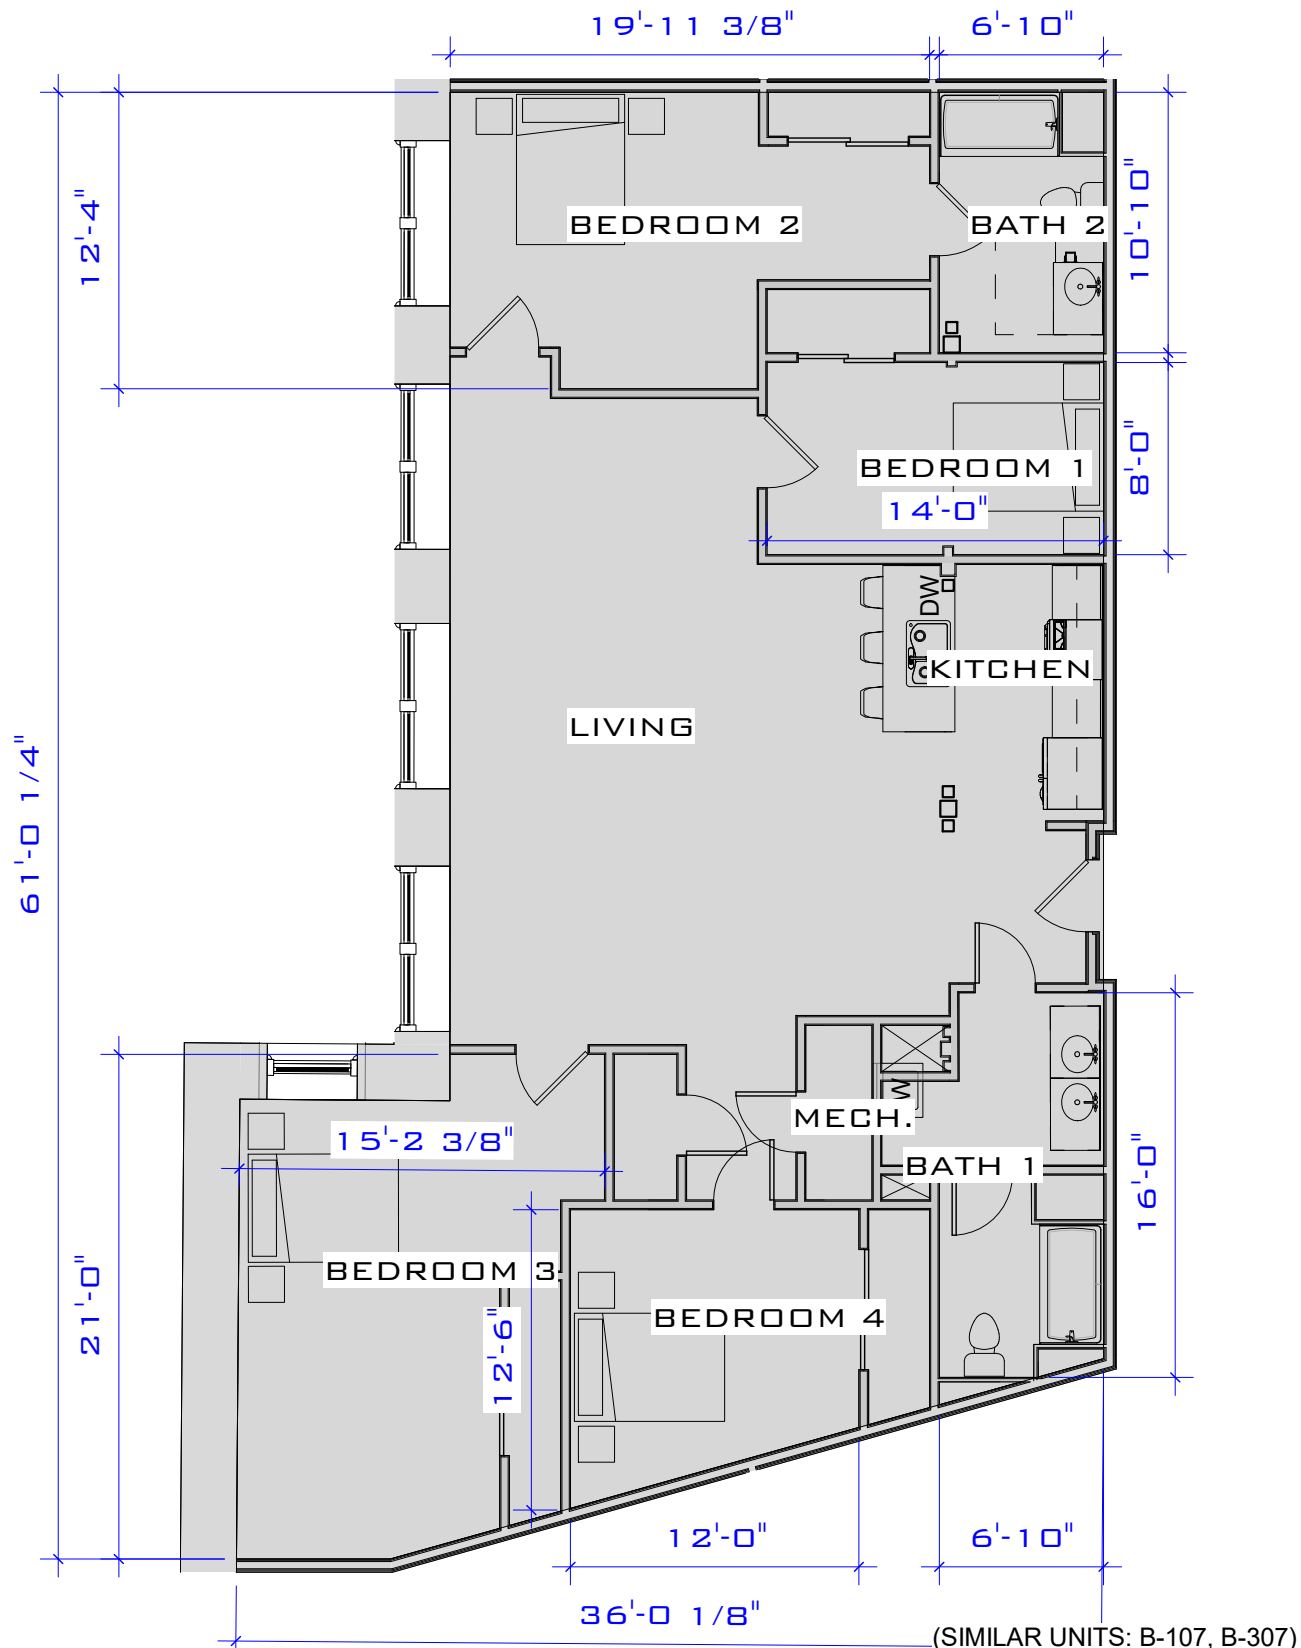

(SIMILAR UNITS: B-107, B-307)

ACTUAL SQUARE FOOTAGE MAY VARY




**JUNCTION
SHOP MILLS**
JUNCTION SHOPS
MILL

UNIT B-107 (1,705 S.F.)

Project number	Project Number
Date	Issue Date
Drawn by	Author
Checked by	Checker

SKA-2-7

Scale 1/8" = 1'-0"

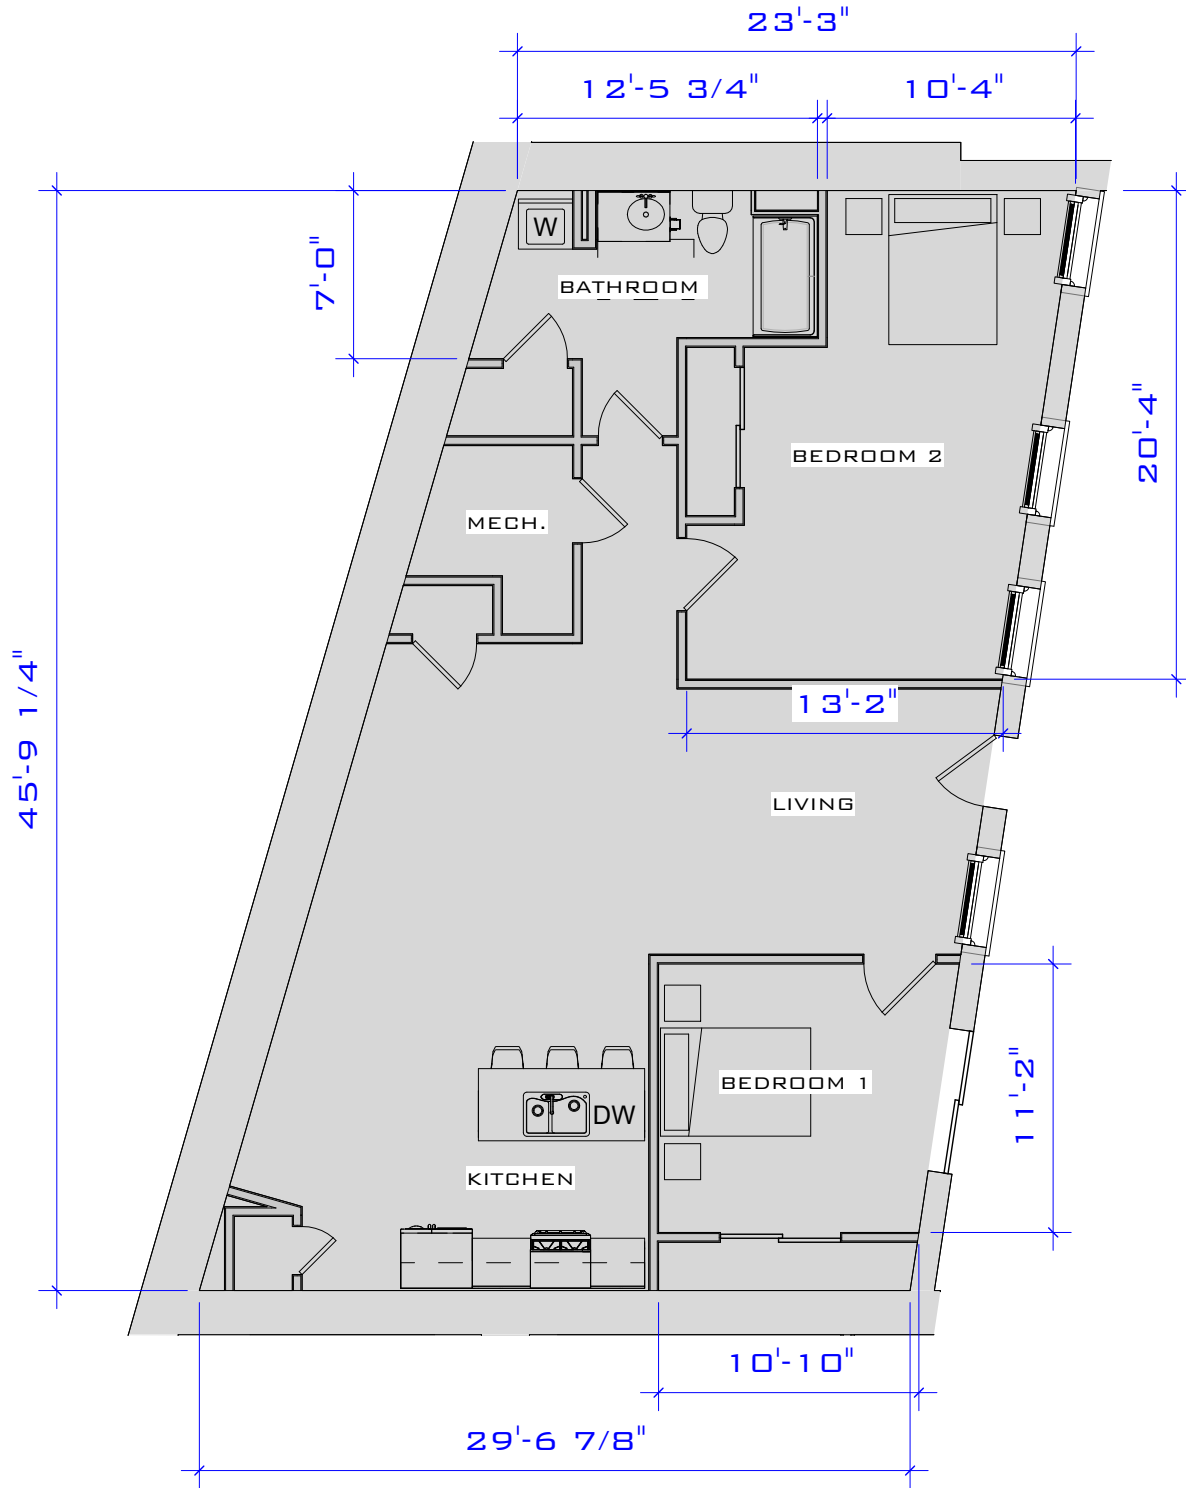

(SIMILAR UNITS: B-109)

ACTUAL SQUARE FOOTAGE MAY VARY



**JUNCTION
SHOP MILLS
JUNCTION SHOPS
MILL**


UNIT B-109

(1,210 S.F.)

Project number	Project Number
Date	Issue Date
Drawn by	Author
Checked by	Checker

SKA-2-8

Scale 1/8" = 1'-0"

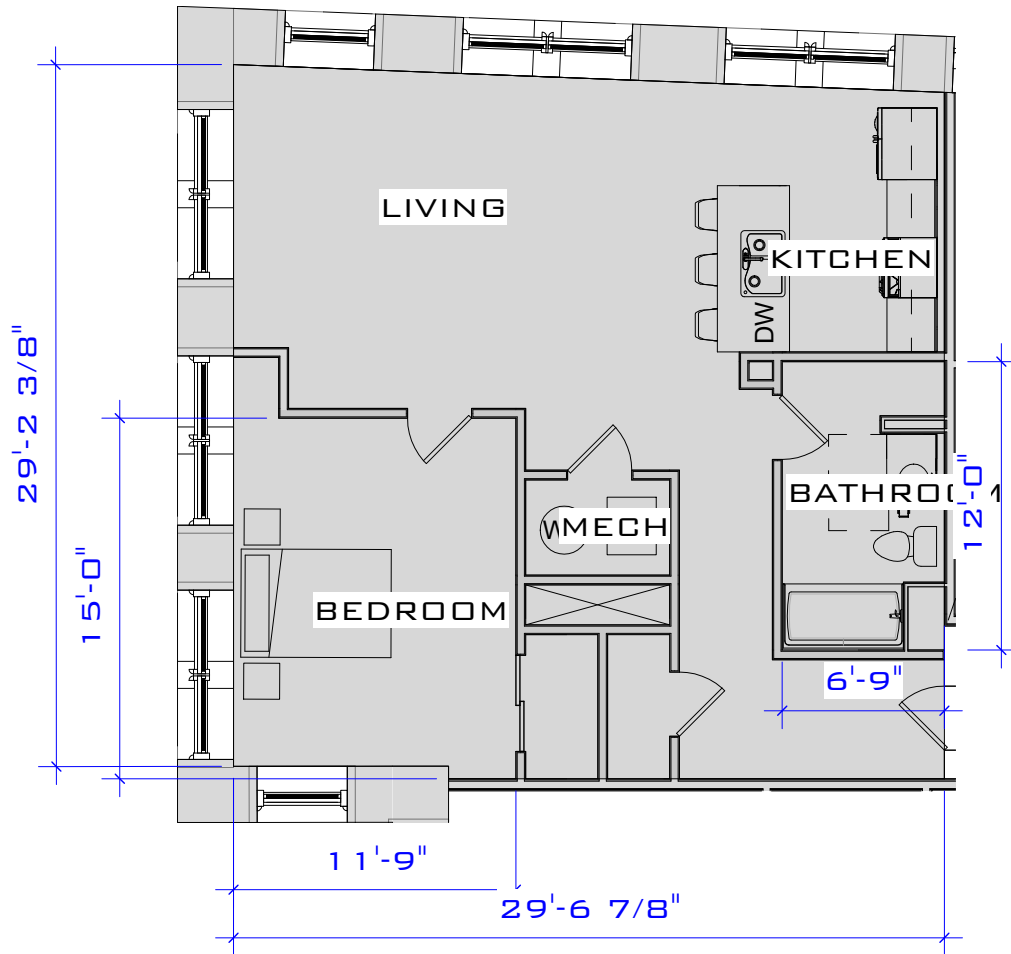

(SIMILAR UNITS: B-201, B-301)

ACTUAL SQUARE FOOTAGE MAY VARY



**JUNCTION
SHOP MILLS
JUNCTION SHOPS
MILL**



UNIT B-201

(860
S.F.)

Project number	Project Number
Date	Issue Date
Drawn by	Author
Checked by	Checker

SKA-2-9

Scale 1/8" = 1'-0"

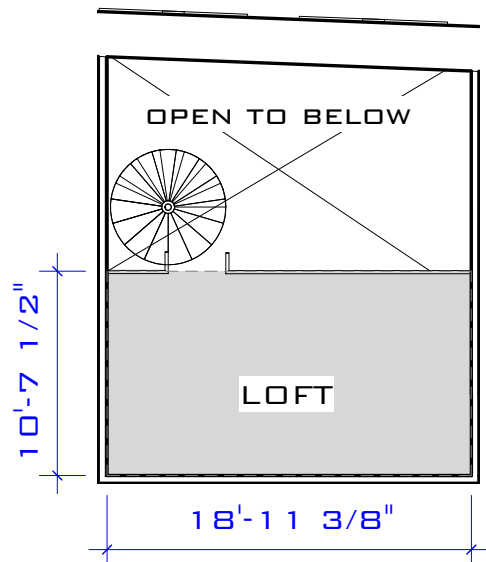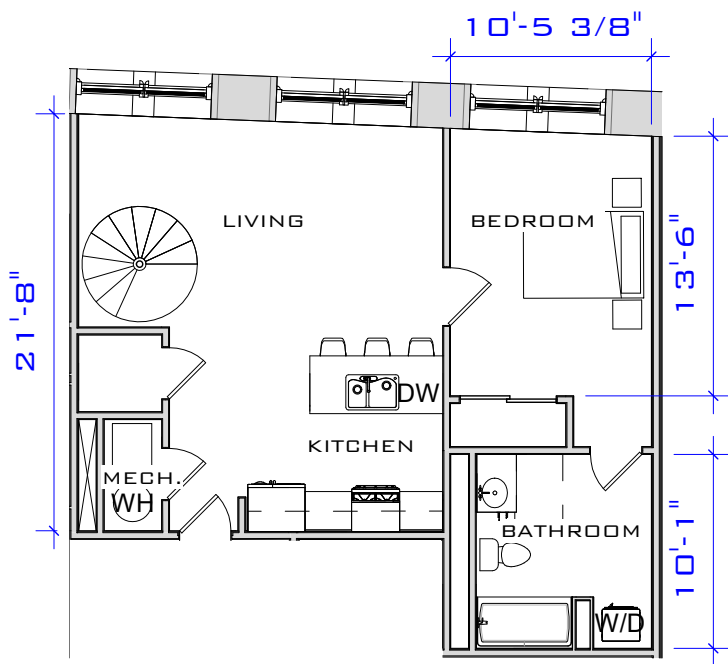


ACTUAL SQUARE FOOTAGE MAY VARY



**JUNCTION
SHOP MILLS
JUNCTION SHOPS
MILL**

UNIT B-202 (+/- 938 S.F.)

Project number	Project Number	SKA-2-10
Date	Issue Date	
Drawn by	Author	Scale 1" = 10'-0"
Checked by	Checker	

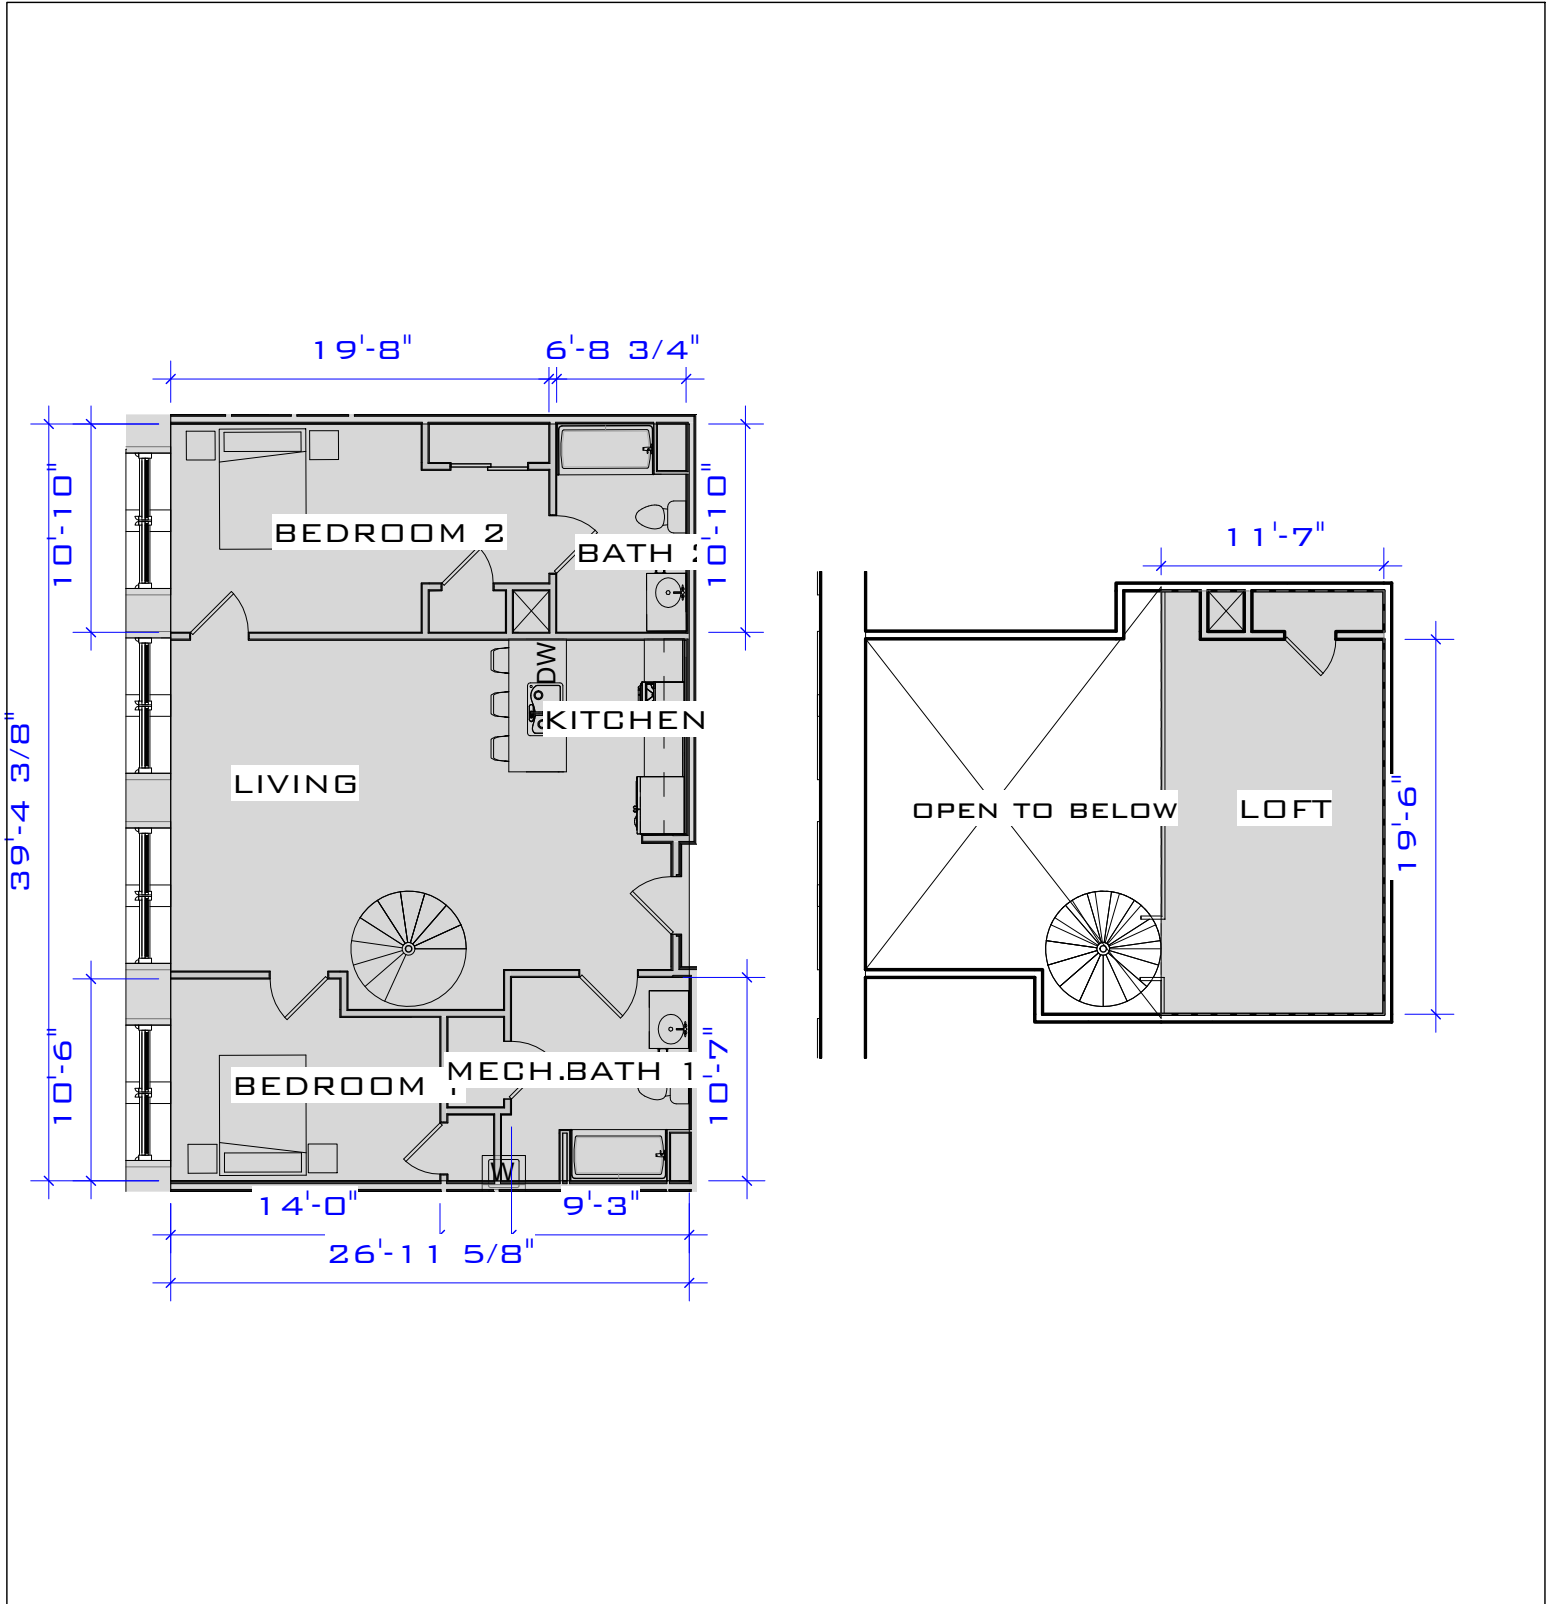

(SIMILAR UNITS: B-203)


ACTUAL SQUARE FOOTAGE MAY VARY



**JUNCTION
SHOP MILLS
JUNCTION SHOPS
MILL**

UNIT B-203 - LOFT (1,316 S.F.)

Project number	Project Number	SKA-2-11
Date	Issue Date	
Drawn by	Author	
Checked by	Checker	
Scale		1" = 10'-0"

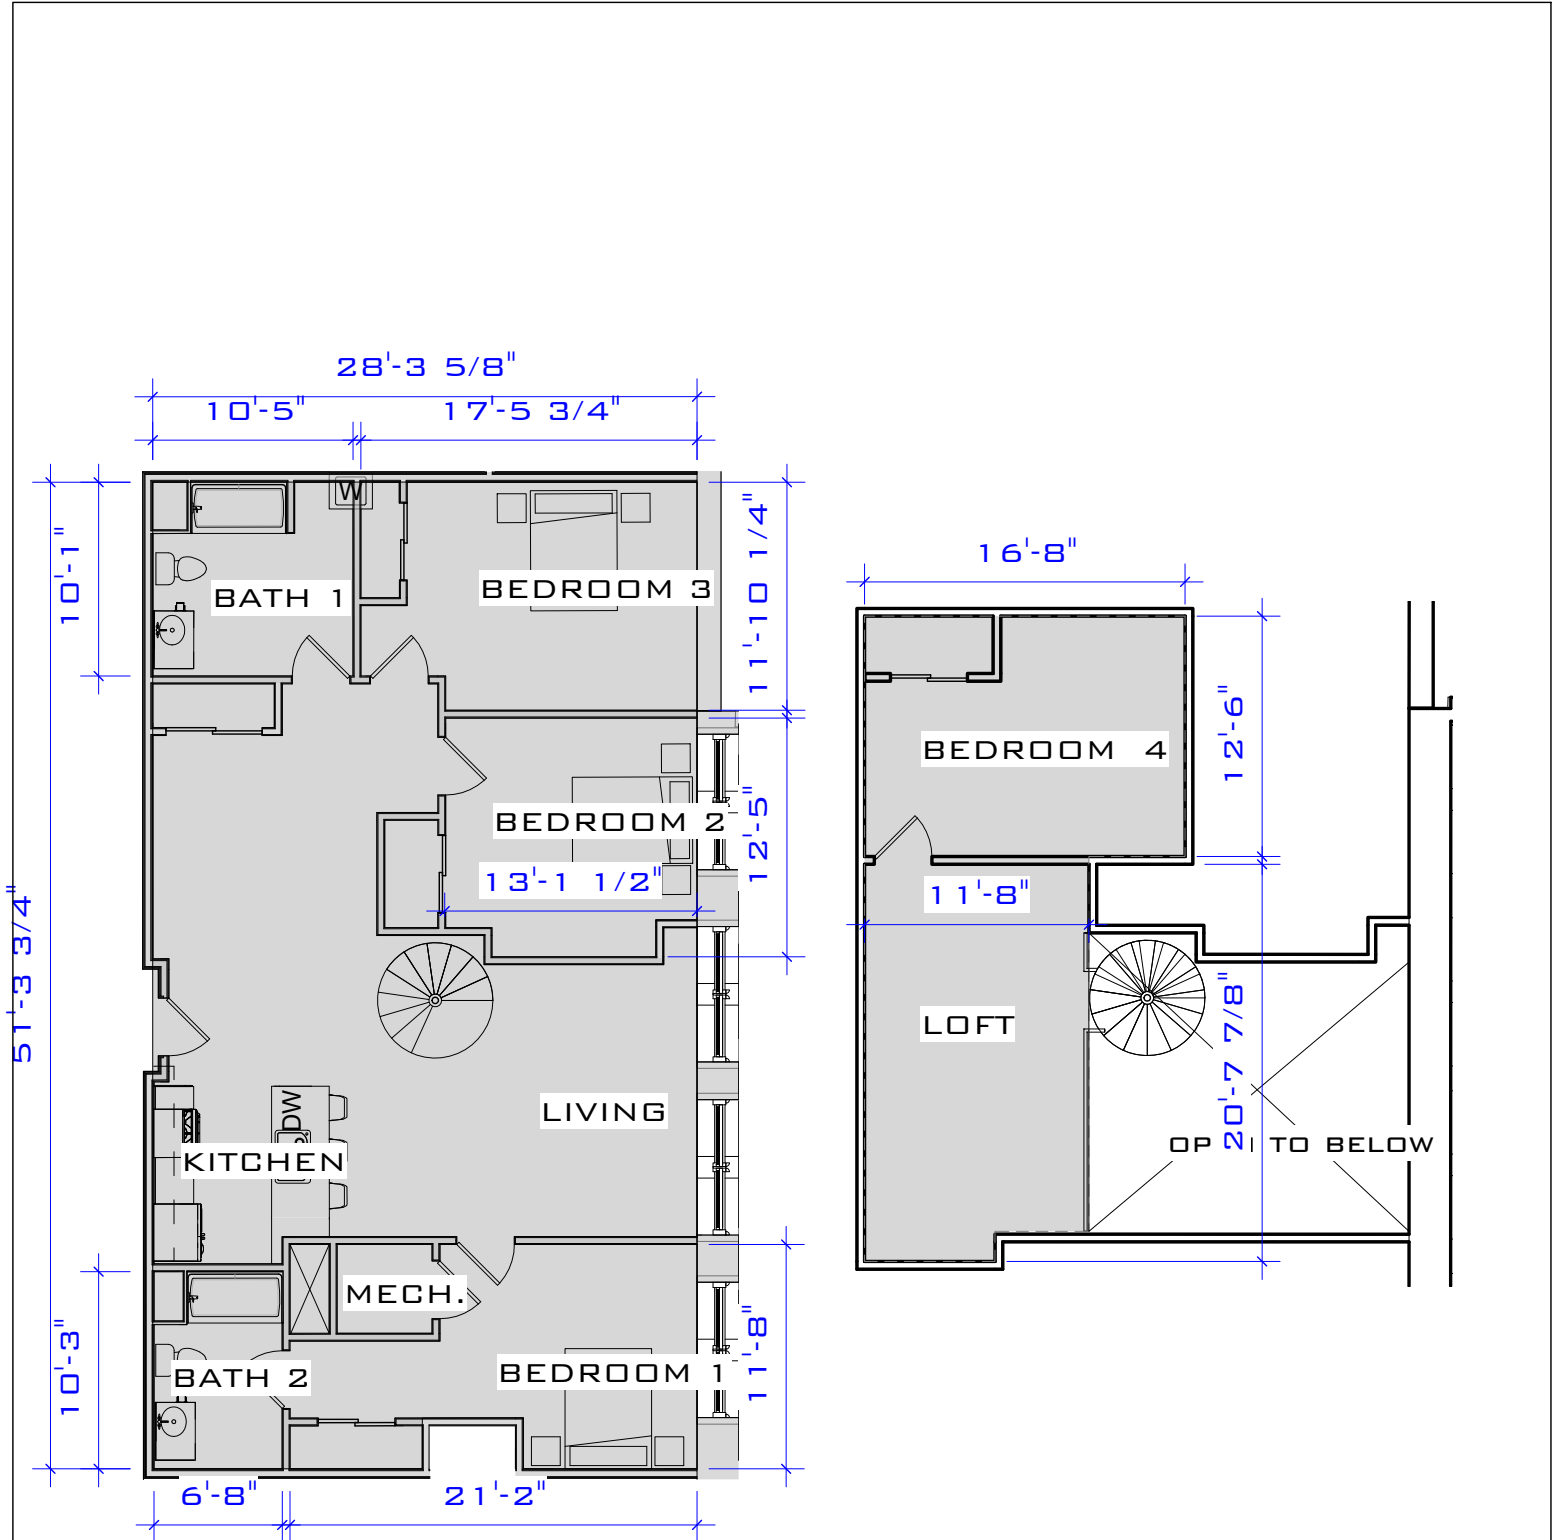

(SIMILAR UNITS: B-204)



ACTUAL SQUARE FOOTAGE MAY VARY



**JUNCTION
SHOP MILLS
JUNCTION SHOPS
MILL**

UNIT B-204 - LOFT (1,884 S.F.)

Project number	Project Number	SKA-2-12
Date	Issue Date	
Drawn by	Author	
Checked by	Checker	
Scale		1" = 10'-0"

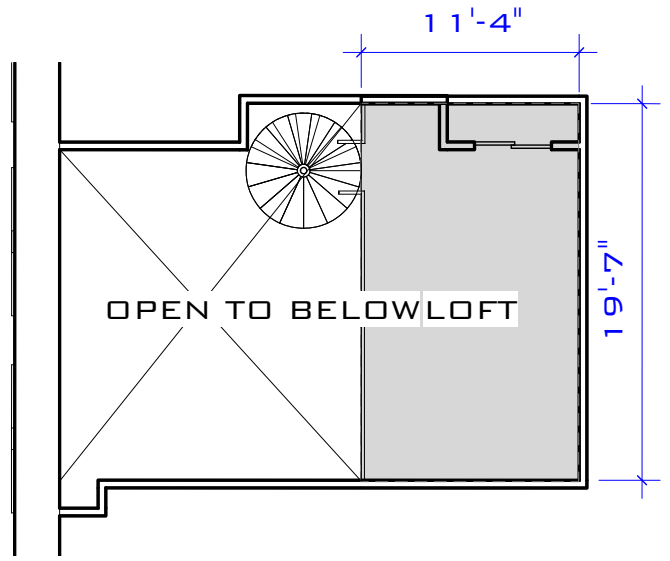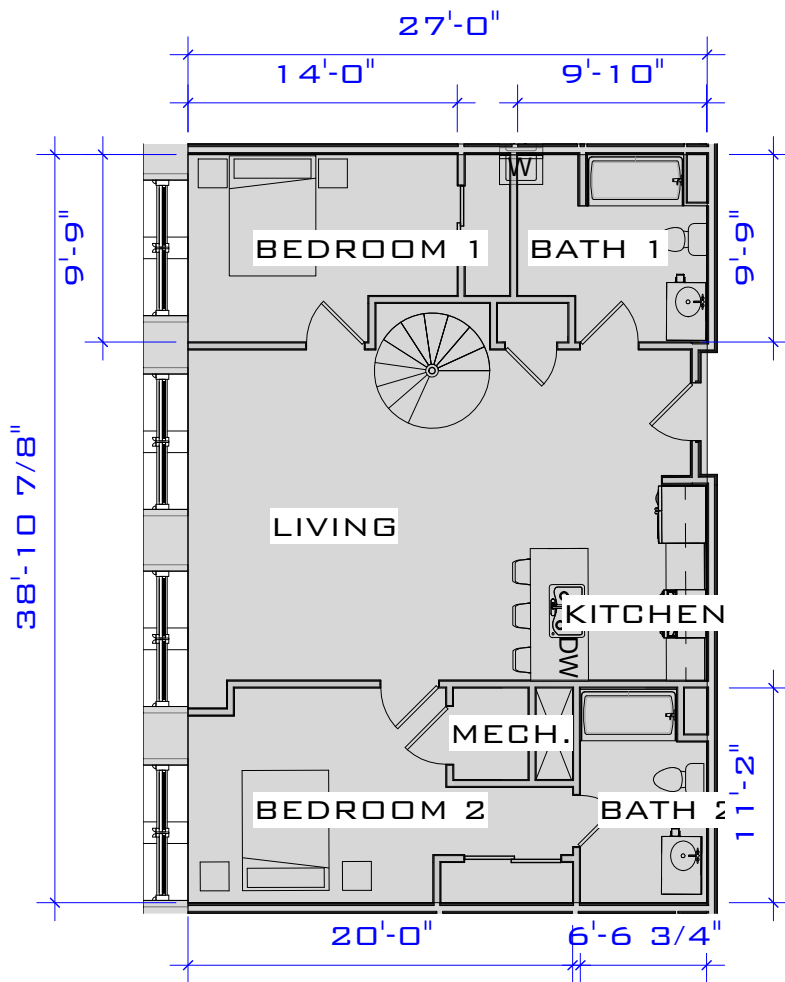

(SIMILAR UNITS: B-205)



ACTUAL SQUARE FOOTAGE MAY VARY



**JUNCTION
SHOP MILLS**
JUNCTION SHOPS
MILL

UNIT B-205 - LOFT (1,274 S.F.)

Project number	Project Number	SKA-2-13
Date	Issue Date	
Drawn by	Author	
Checked by	Checker	
Scale		1" = 10'-0"

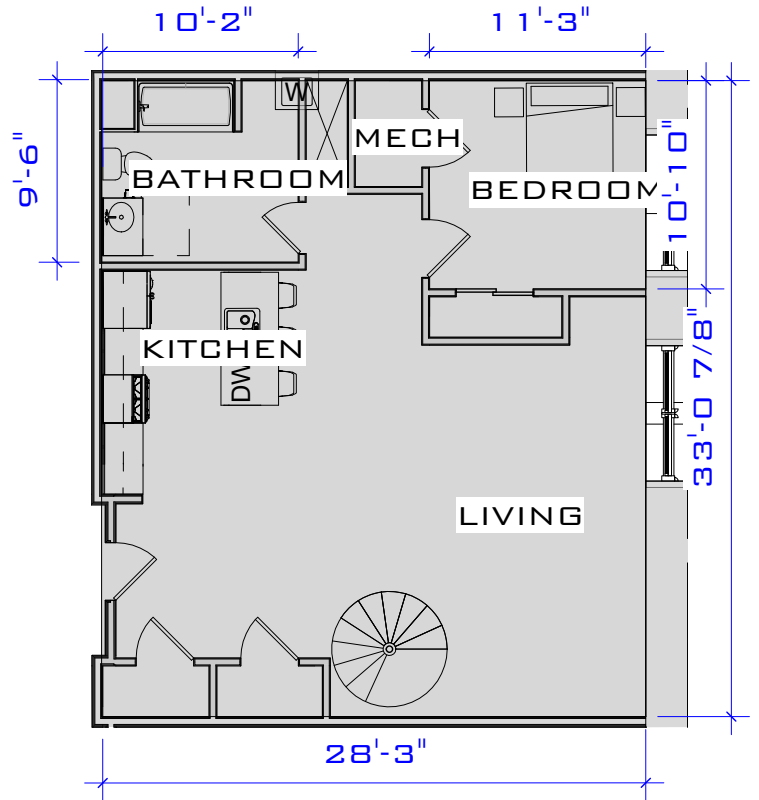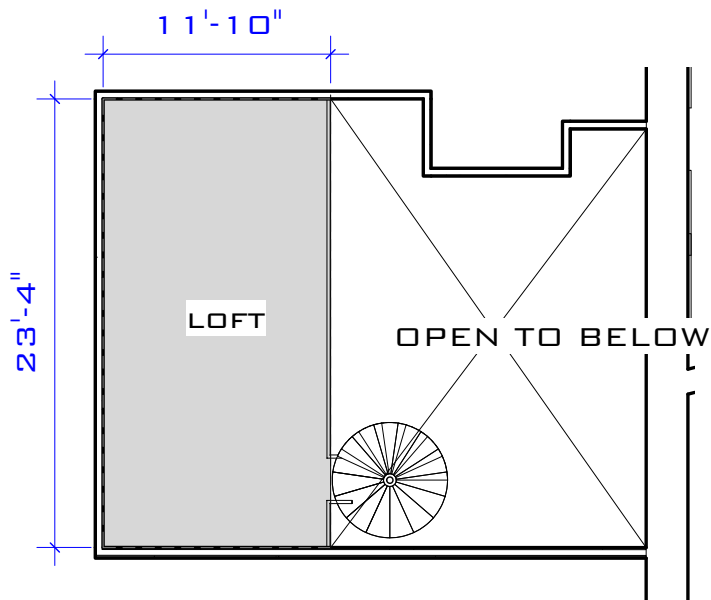

(SIMILAR UNITS: B-206)


ACTUAL SQUARE FOOTAGE MAY VARY



**JUNCTION
SHOP MILLS
JUNCTION SHOPS
MILL**

UNIT B-206 - LOFT (1,211 S.F.)

Project number	Project Number	SKA-2-14
Date	Issue Date	
Drawn by	Author	Scale 1" = 10'-0"
Checked by	Checker	

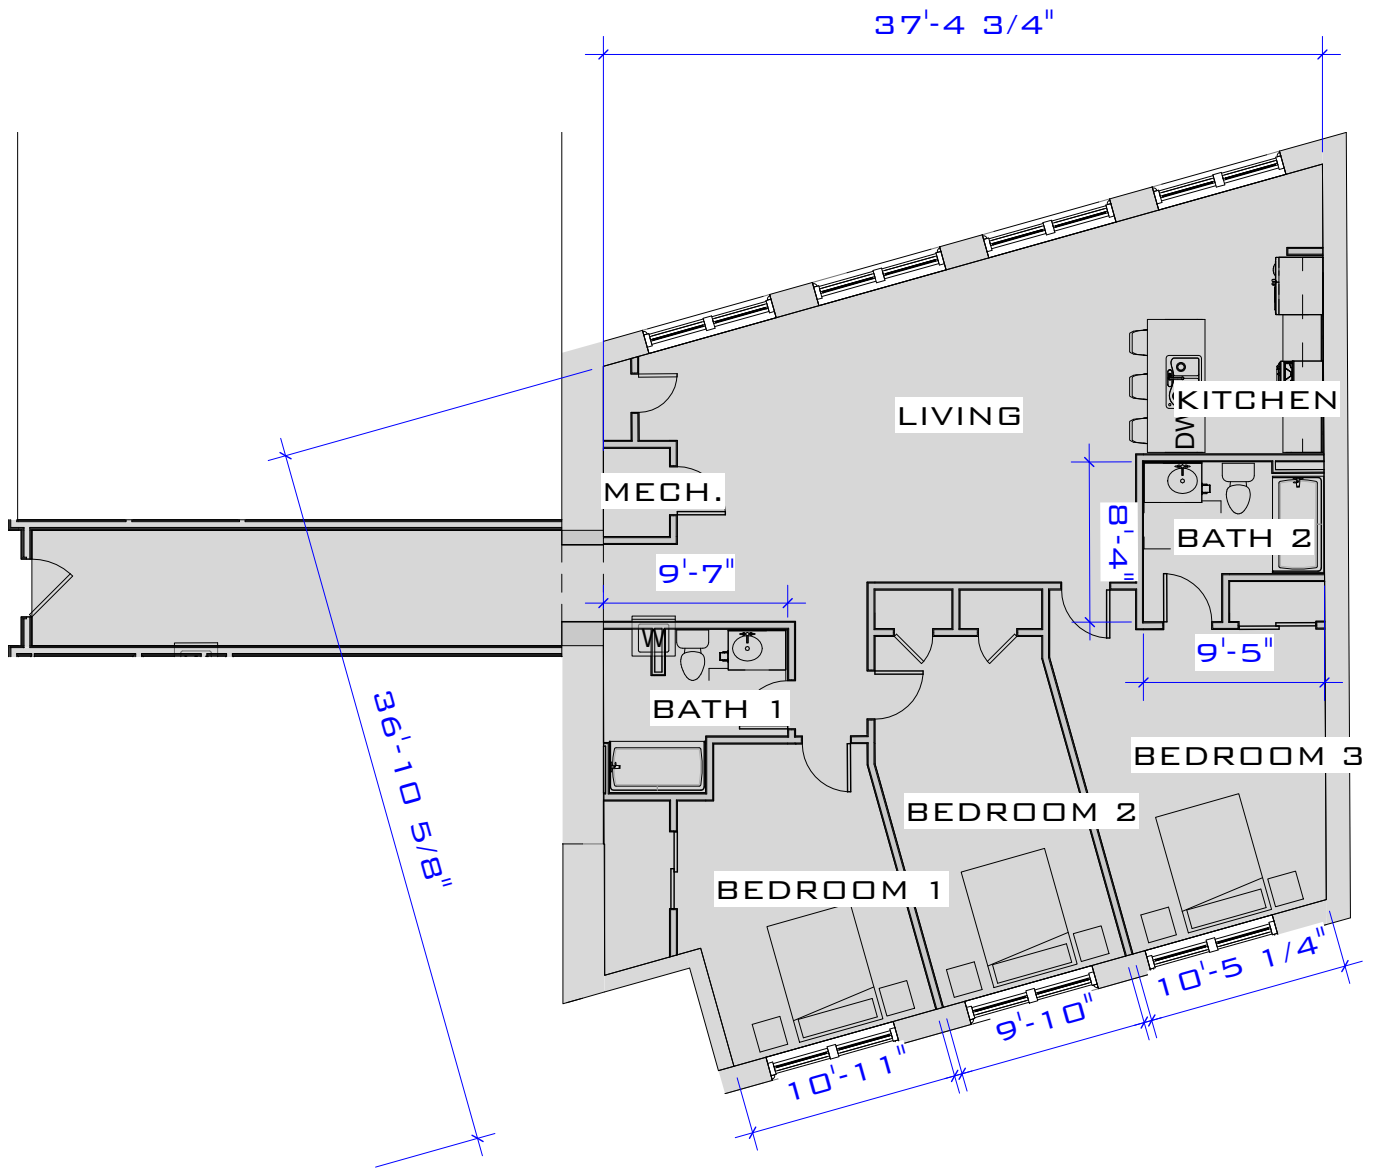

(SIMILAR UNITS: B-207)

ACTUAL SQUARE FOOTAGE MAY VARY





**JUNCTION
SHOP MILLS**
JUNCTION SHOPS
MILL

UNIT B-207 (1,575 S.F.)

Project number	Project Number
Date	Issue Date
Drawn by	Author
Checked by	Checker

SKA-2-15

Scale 1" = 10'-0"

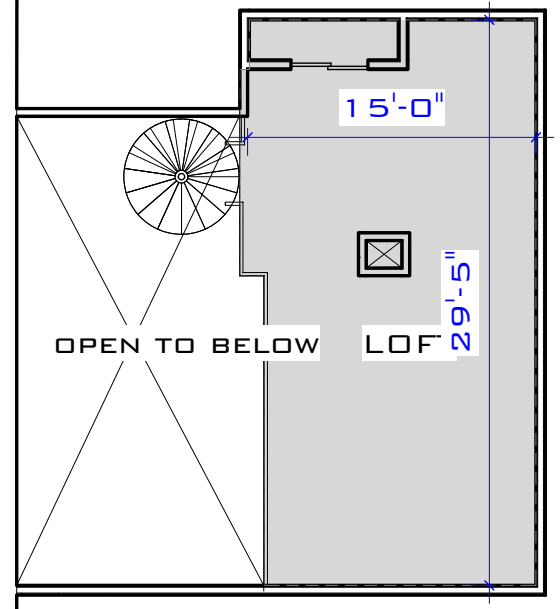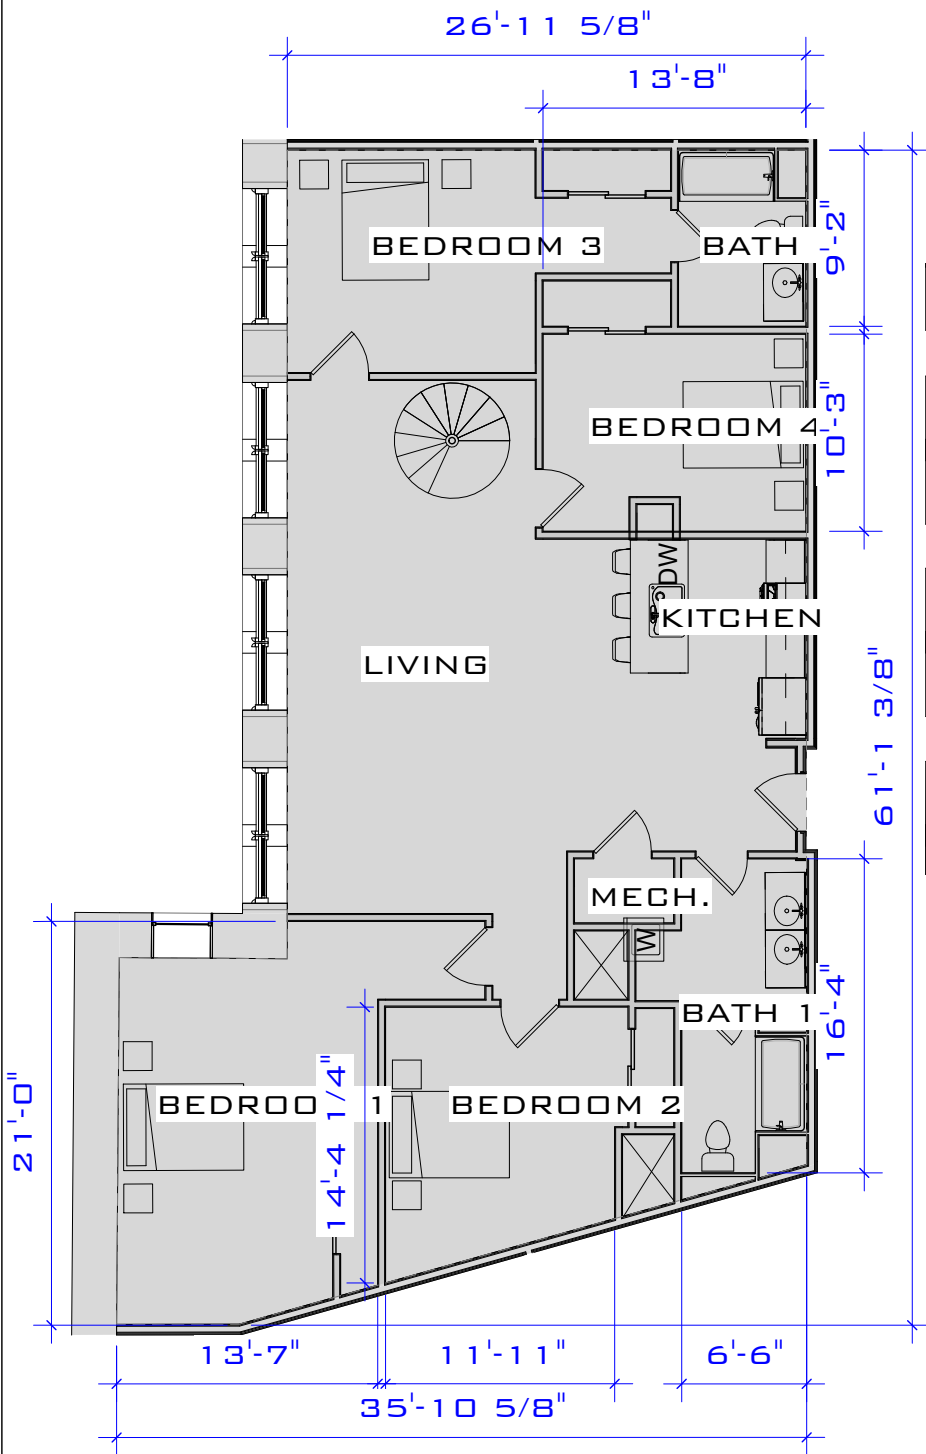

(SIMILAR UNITS: B-208)

ACTUAL SQUARE FOOTAGE MAY VARY




**JUNCTION
SHOP MILLS
JUNCTION SHOPS
MILL**

UNIT B-208 - LOFT (2,125 S.F.)

Project number	Project Number
Date	Issue Date
Drawn by	Author
Checked by	Checker

SKA-2-16

Scale 1" = 10'-0"

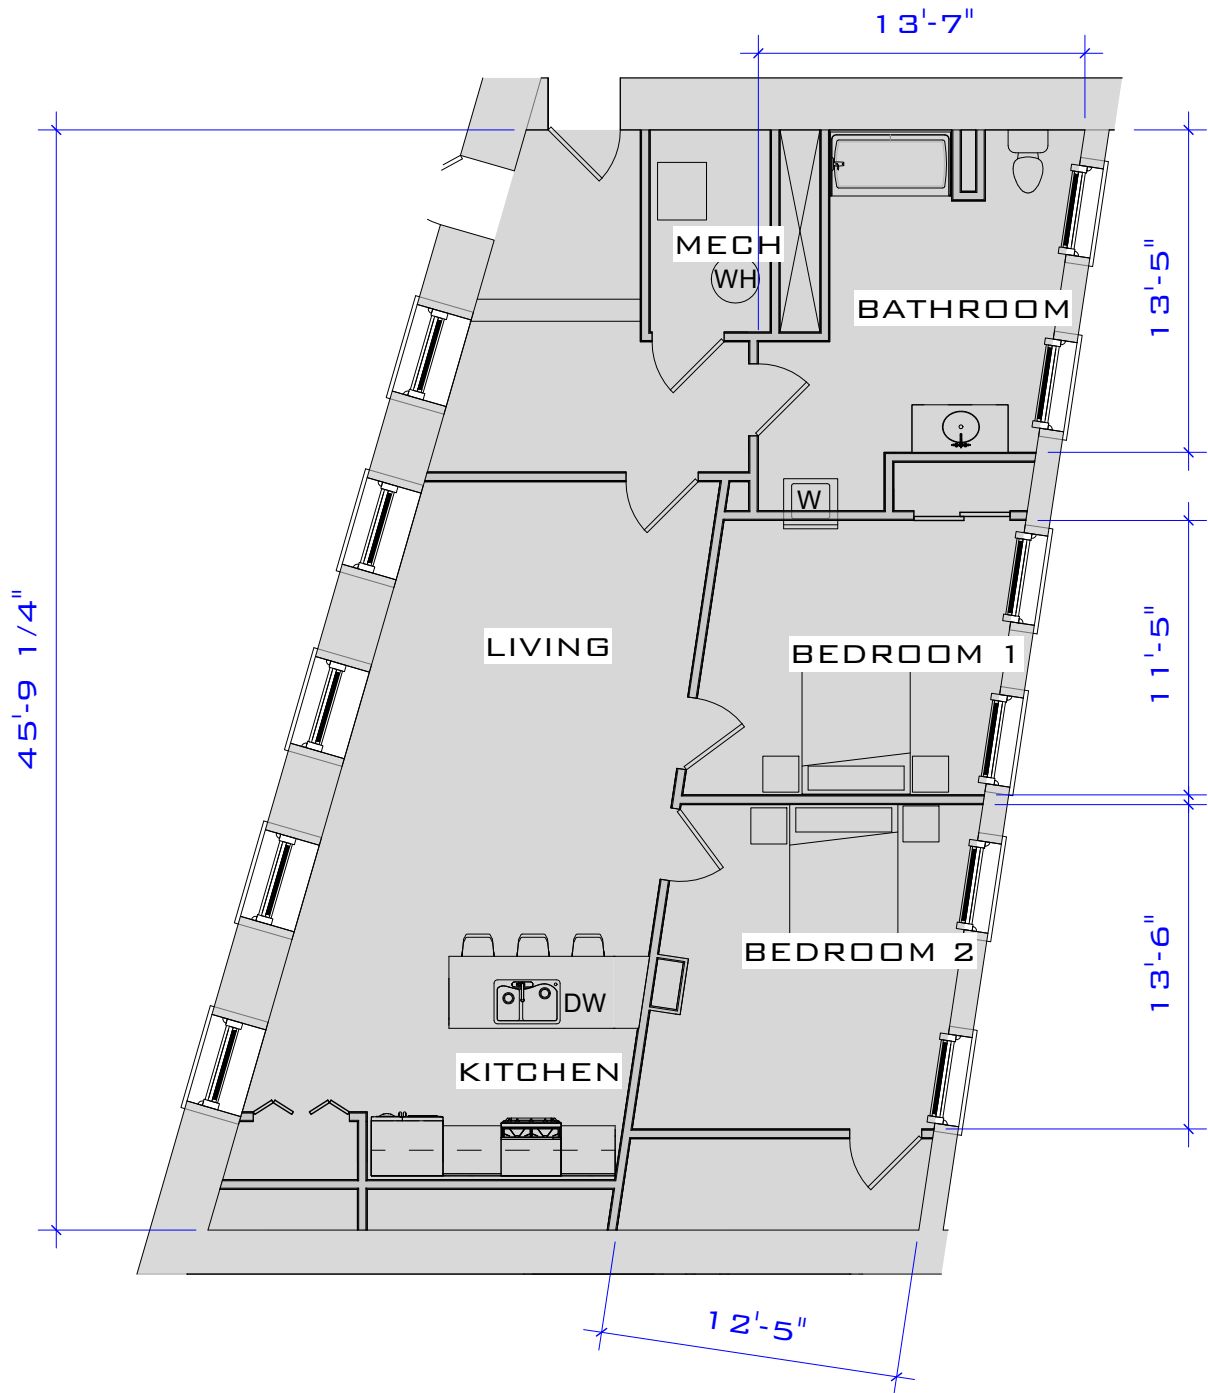

(SIMILAR UNITS: B-108)

ACTUAL SQUARE FOOTAGE MAY VARY




**JUNCTION
SHOP MILLS
JUNCTION SHOPS
MILL**

UNIT B-108 (1,210 S.F.)

Project number	Project Number
Date	Issue Date
Drawn by	Author
Checked by	Checker

SKA-2-17

Scale 1/8" = 1'-0"

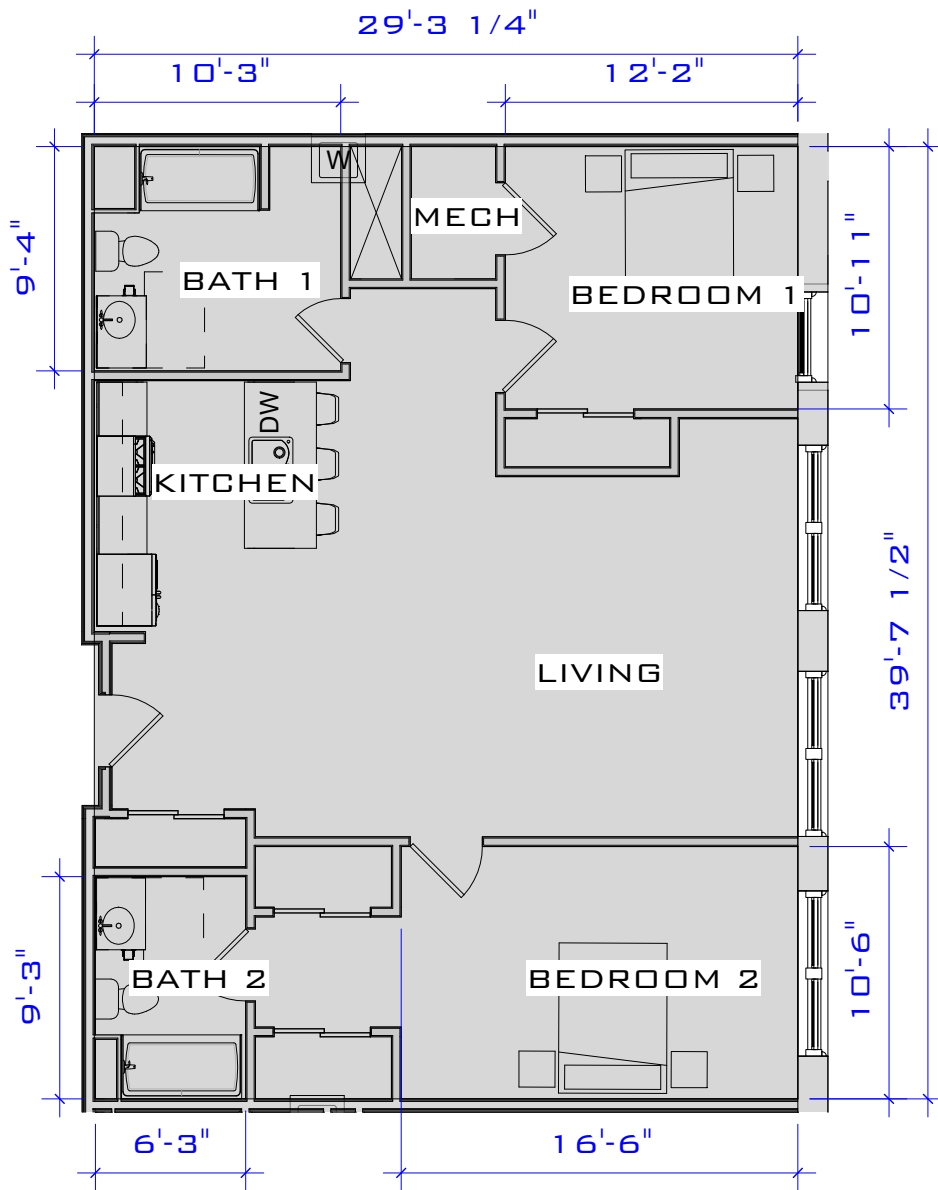

(SIMILAR UNITS: B-306)

ACTUAL SQUARE FOOTAGE MAY VARY



**JUNCTION
SHOP MILLS
JUNCTION SHOPS
MILL**

UNIT B-306

(1,160 S.F.)

Project number Project Number


Date Issue Date

Drawn by Author

Checked by Checker

SKA-2-18

Scale 1/8" = 1'-0"

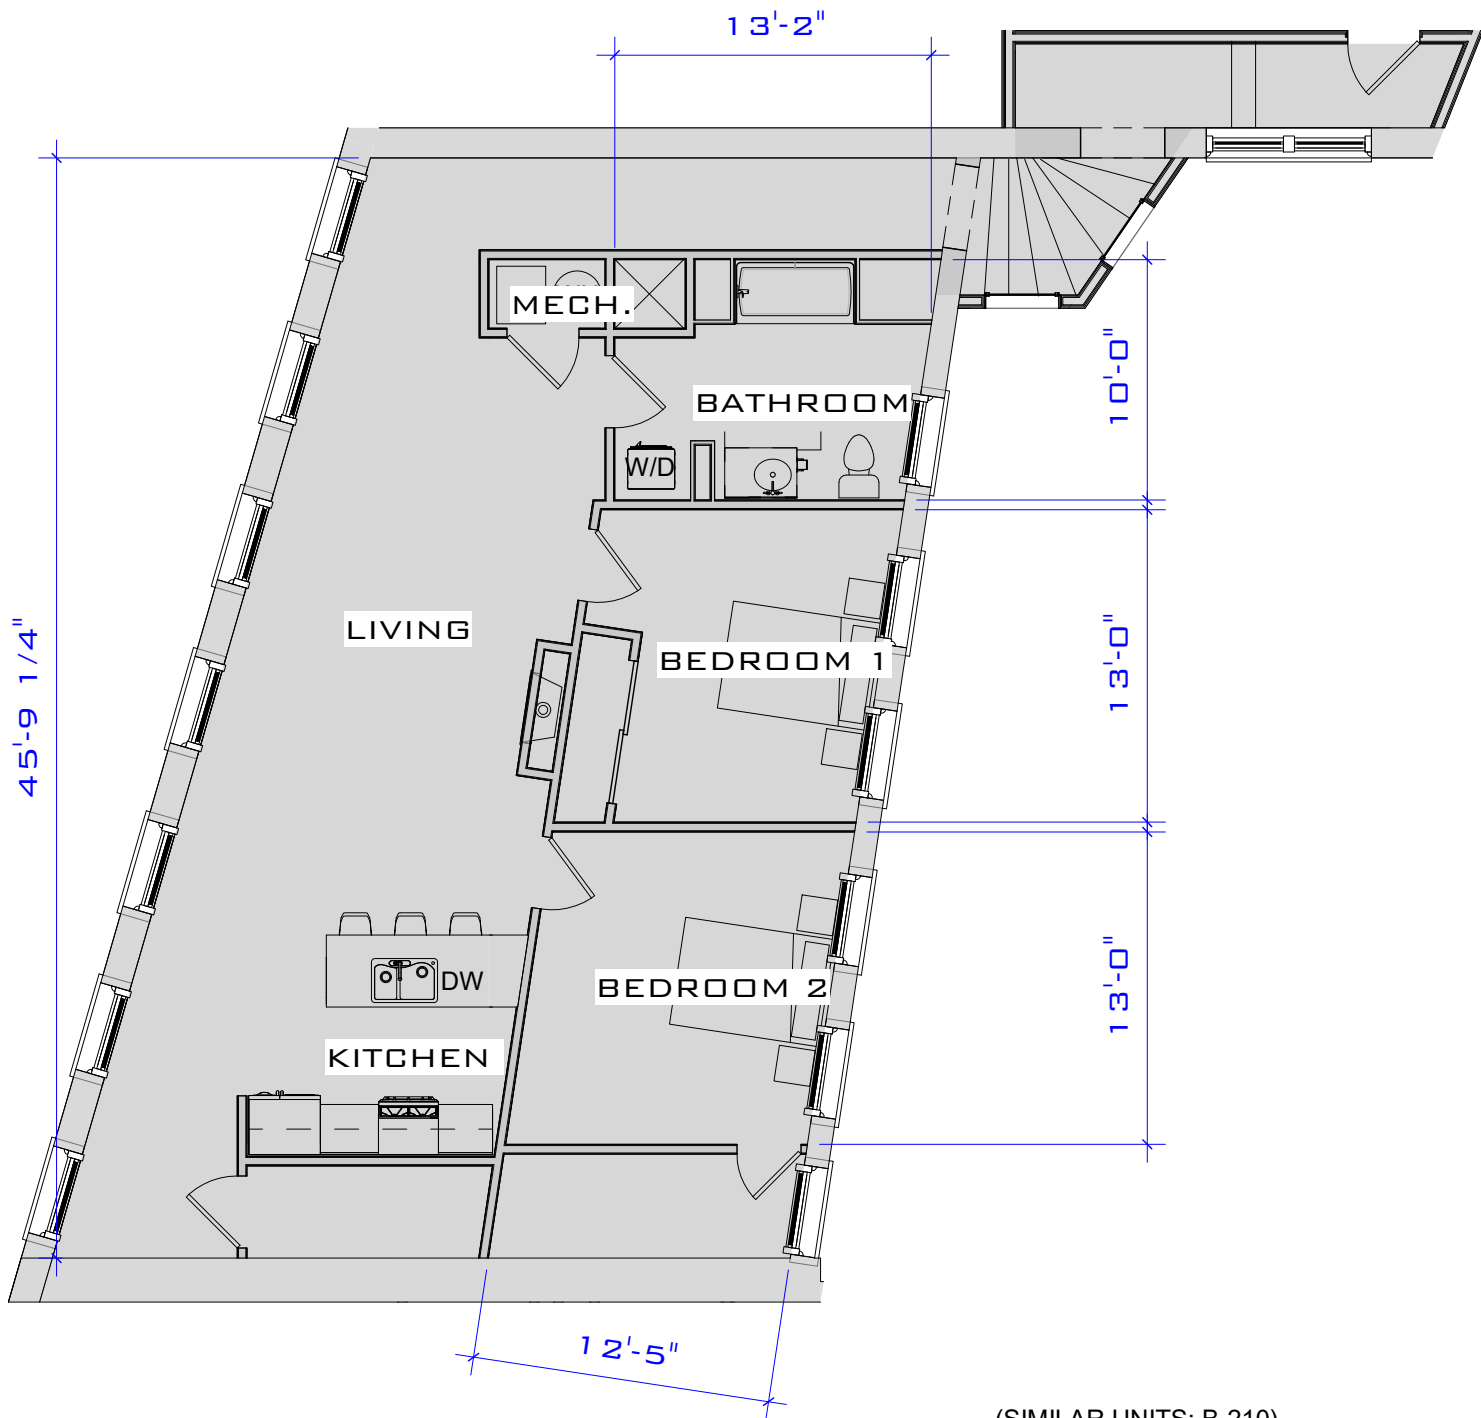

(SIMILAR UNITS: B-210)




ACTUAL SQUARE FOOTAGE MAY VARY



**JUNCTION
SHOP MILLS**
JUNCTION SHOPS
MILL

UNIT B-210 (1,375 S.F.)

Project number	Project Number	SKA-2-19
Date	Issue Date	
Drawn by	Author	
Checked by	Checker	
Scale		1/8" = 1'-0"

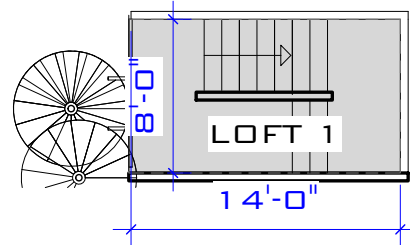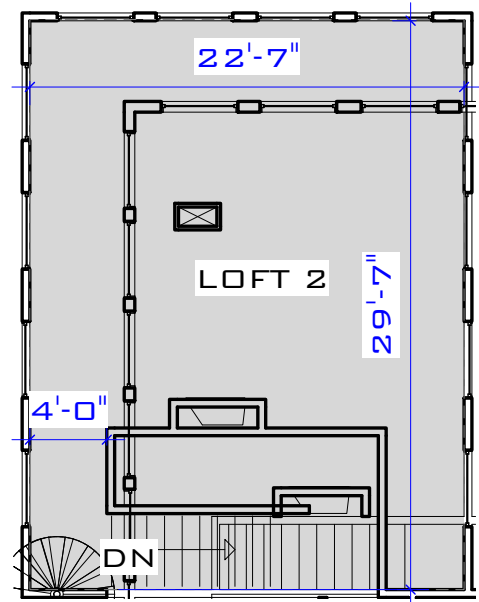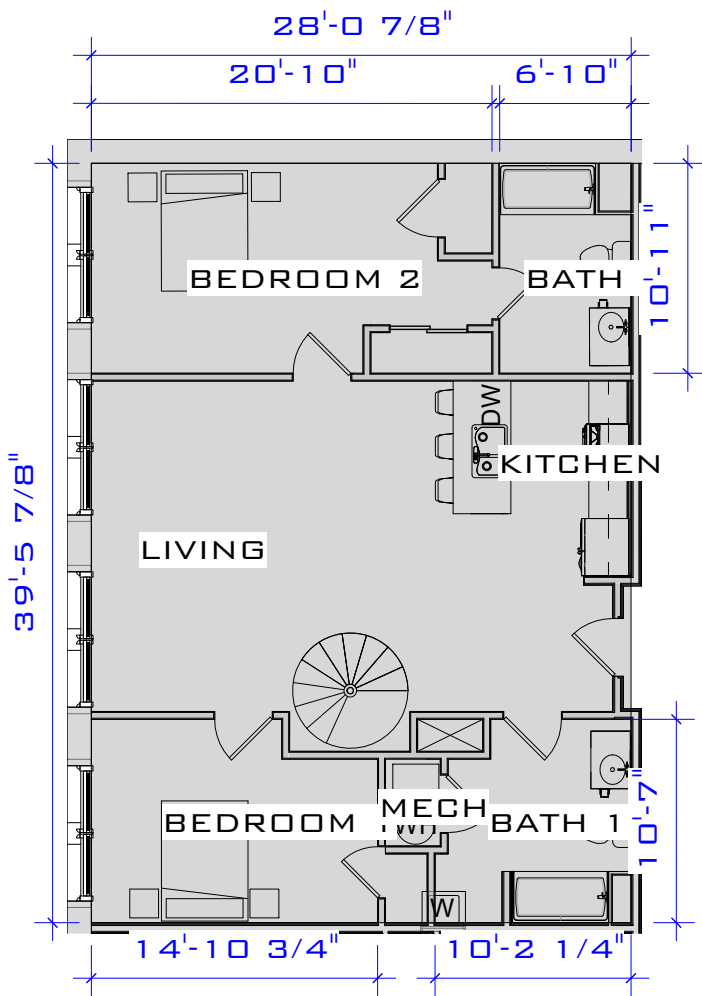

(SIMILAR UNITS: B-401)

ACTUAL SQUARE FOOTAGE MAY VARY




**JUNCTION
SHOP MILLS
JUNCTION SHOPS
MILL**

UNIT B-401 - LOFT (1,919 S.F.)

Project number	Project Number
Date	Issue Date
Drawn by	Author
Checked by	Checker

SKA-2-20

Scale 1" = 10'-0"

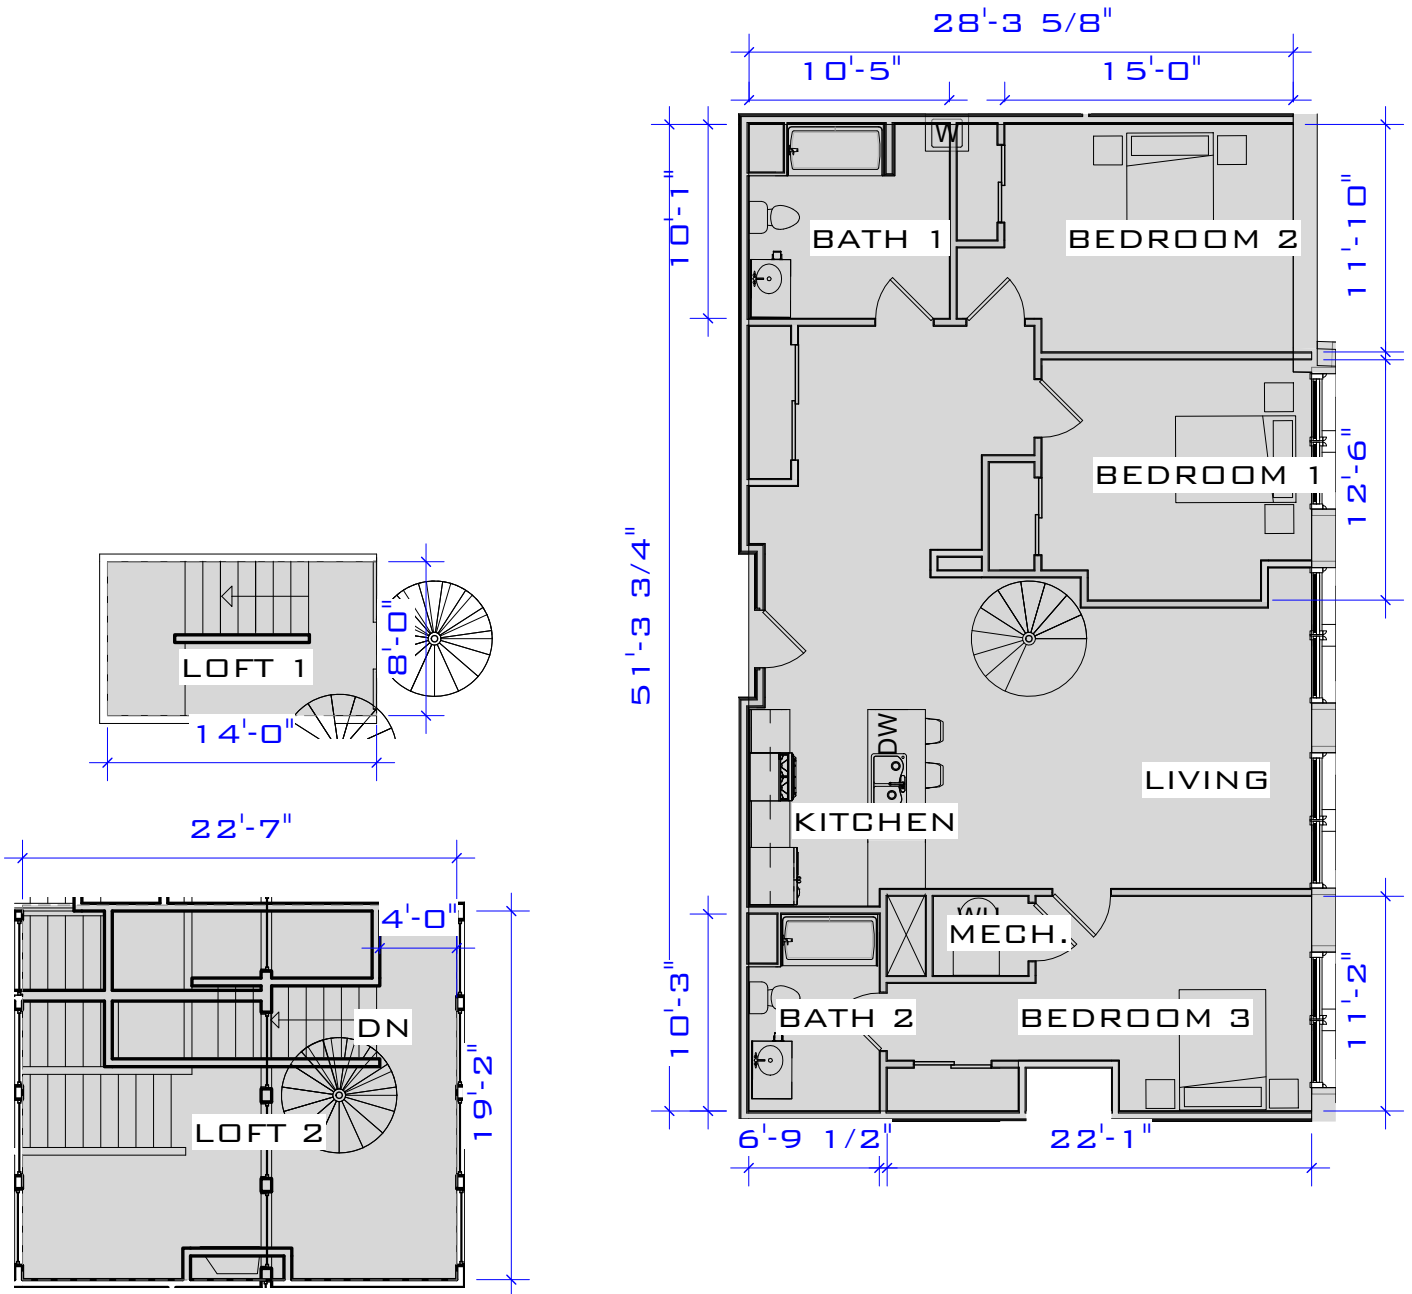

(SIMILAR UNITS: B-402)

ACTUAL SQUARE FOOTAGE MAY VARY



**JUNCTION
SHOP MILLS**
JUNCTION SHOPS
MILL

UNIT B-402 - LOFT (2,027 S.F.)

Project number Project Number




Date Issue Date

Drawn by Author

Checked by Checker

SKA-2-21

Scale 1" = 10'-0"

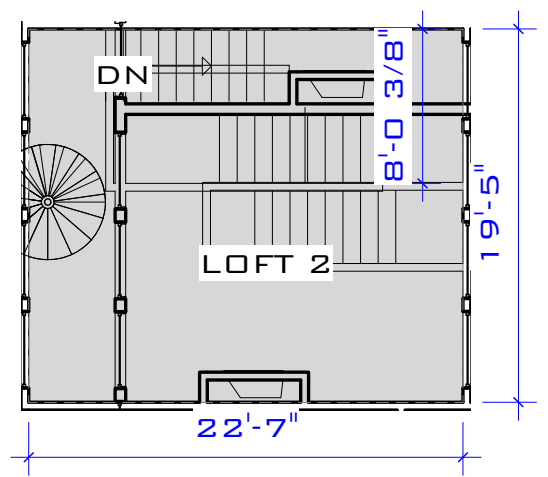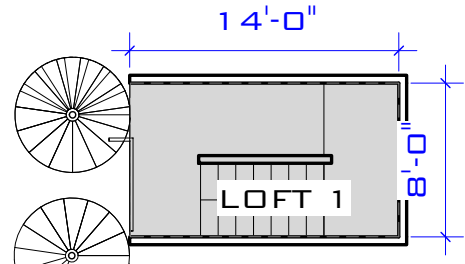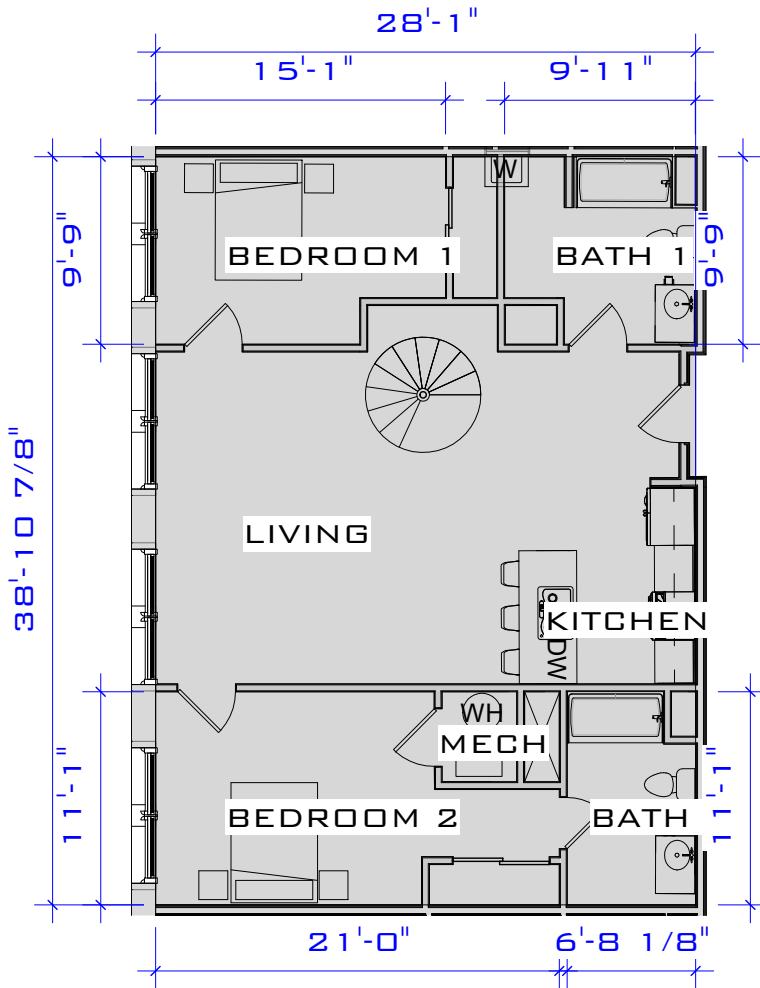

(SIMILAR UNITS: B-403)




ACTUAL SQUARE FOOTAGE MAY VARY



**JUNCTION
SHOP MILLS**
JUNCTION SHOPS
MILL

UNIT B-403 - LOFT (1,641 S.F.)

Project number	Project Number	SKA-2-22
Date	Issue Date	
Drawn by	Author	
Checked by	Checker	
Scale		1" = 10'-0"

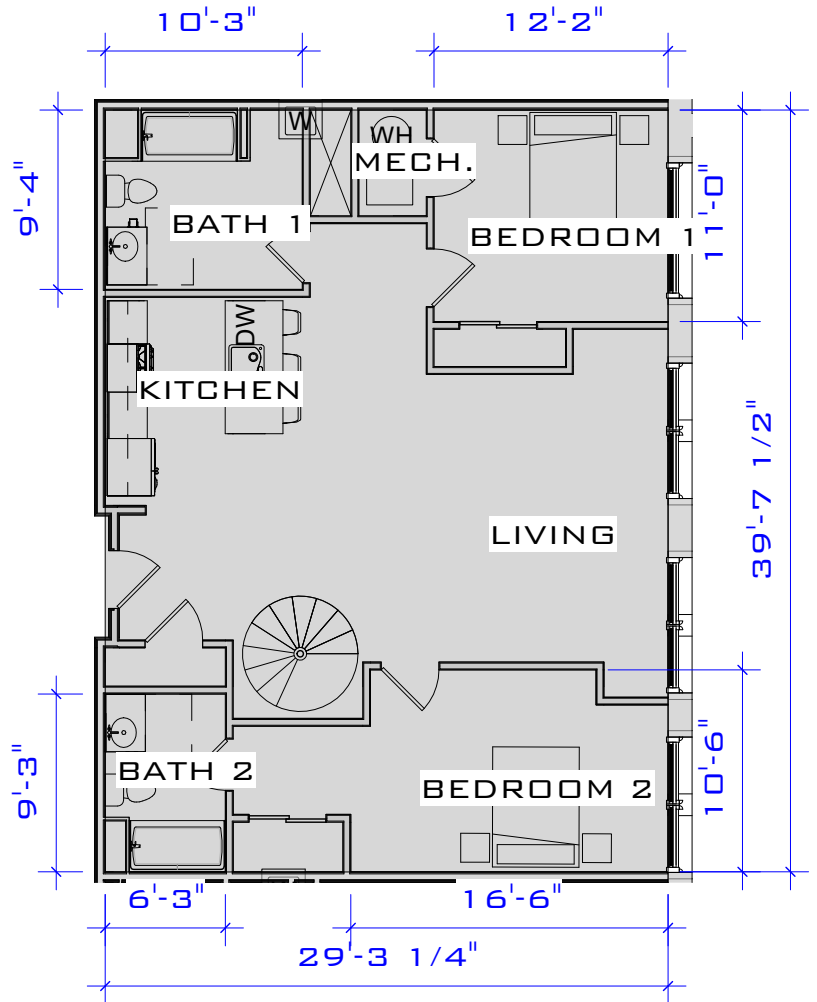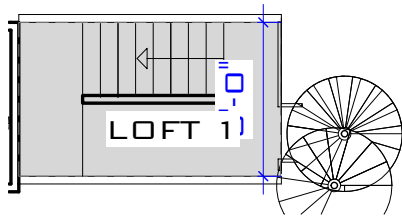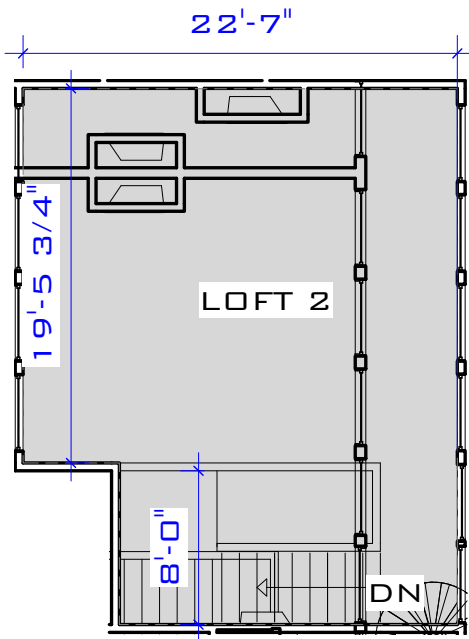

(SIMILAR UNITS: B-404)


ACTUAL SQUARE FOOTAGE MAY VARY



**JUNCTION
SHOP MILLS**
JUNCTION SHOPS
MILL

UNIT B-404 - LOFT (2,256 S.F.)

Project number	Project Number	SKA-2-23
Date	Issue Date	
Drawn by	Author	
Checked by	Checker	
Scale		1" = 10'-0"

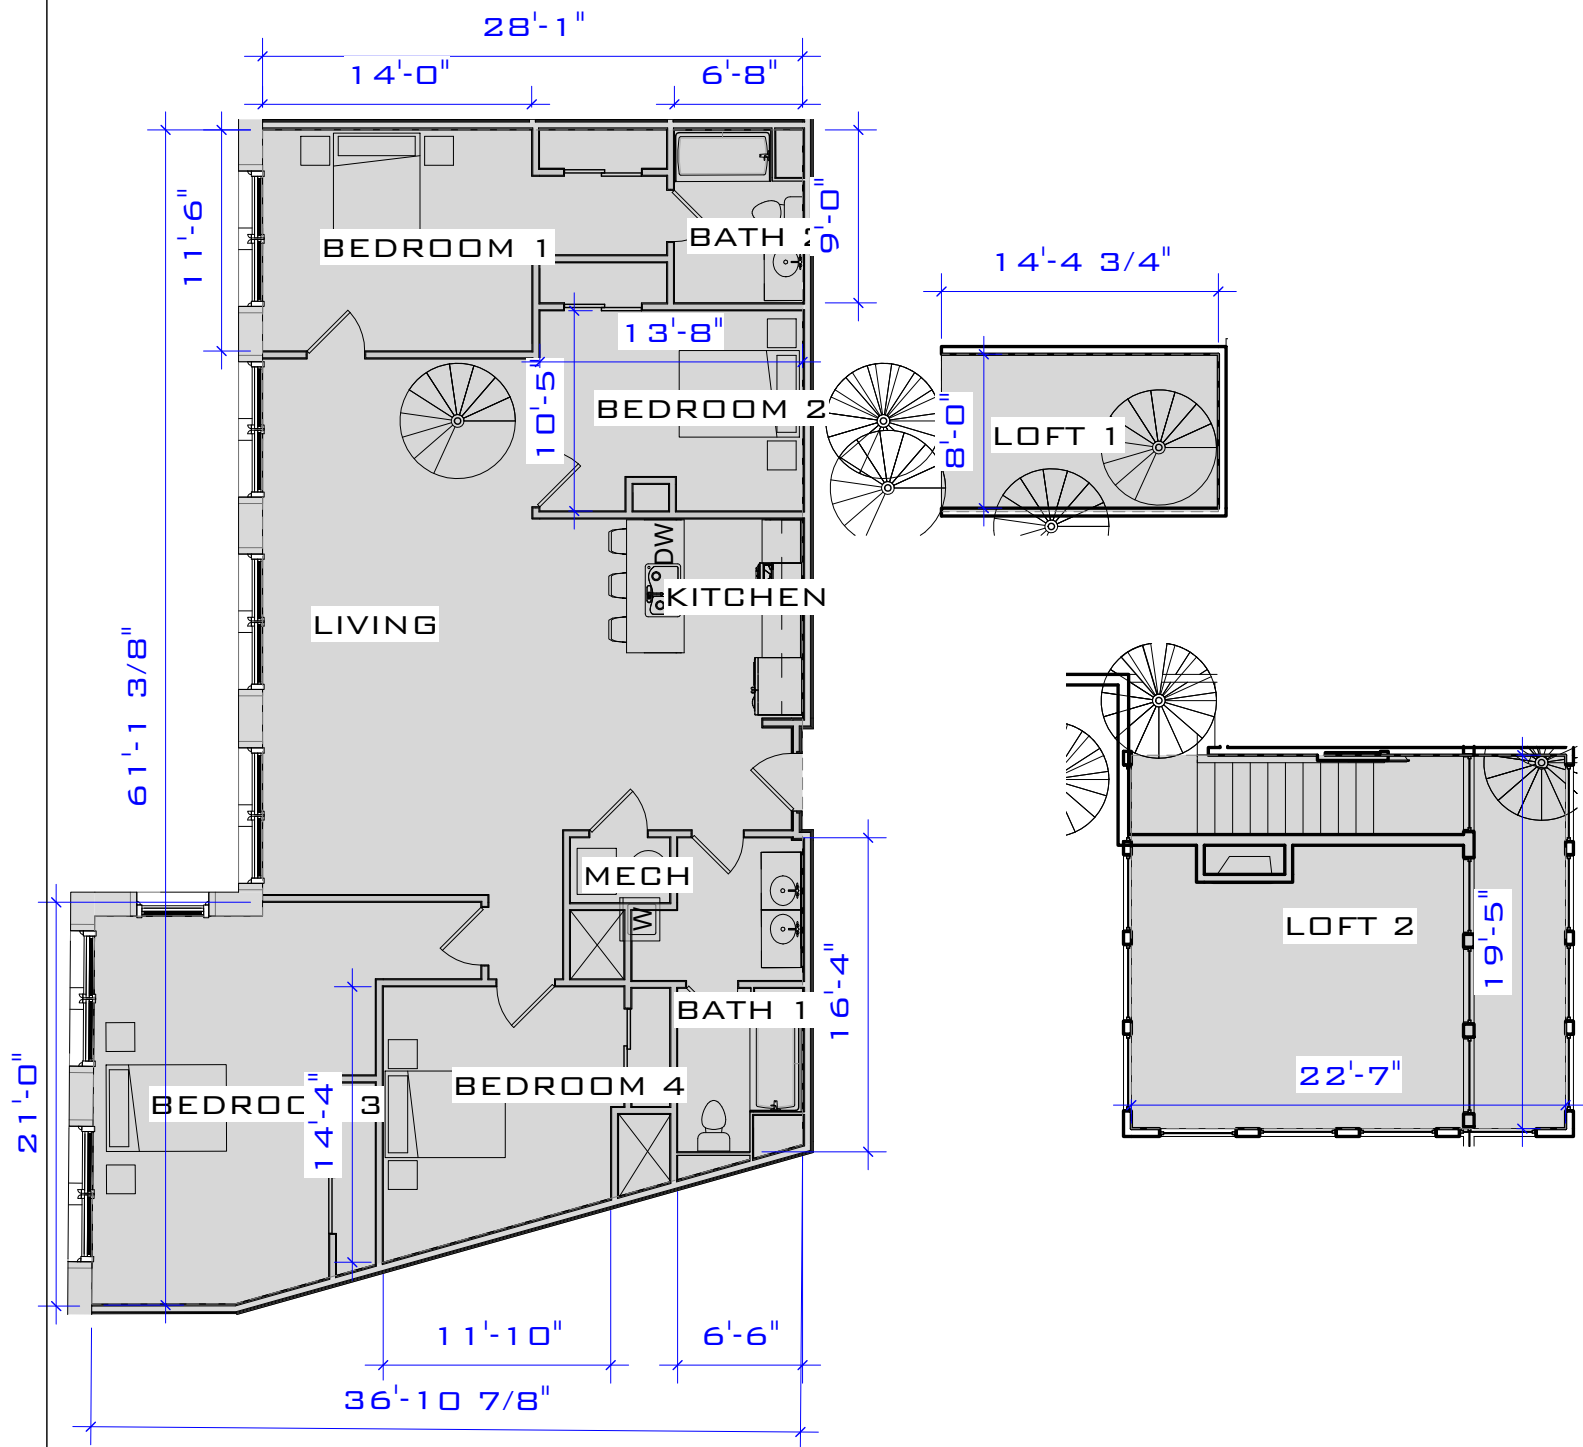


(SIMILAR UNITS: B-405)
 ACTUAL SQUARE FOOTAGE MAY VARY



**JUNCTION
 SHOP MILLS**
 JUNCTION SHOPS
 MILL

UNIT B-405 - LOFT (2,326 S.F.)

Project number	Project Number	SKA-2-24
Date	Issue Date	
Drawn by	Author	
Checked by	Checker	
Scale		1" = 10'-0"

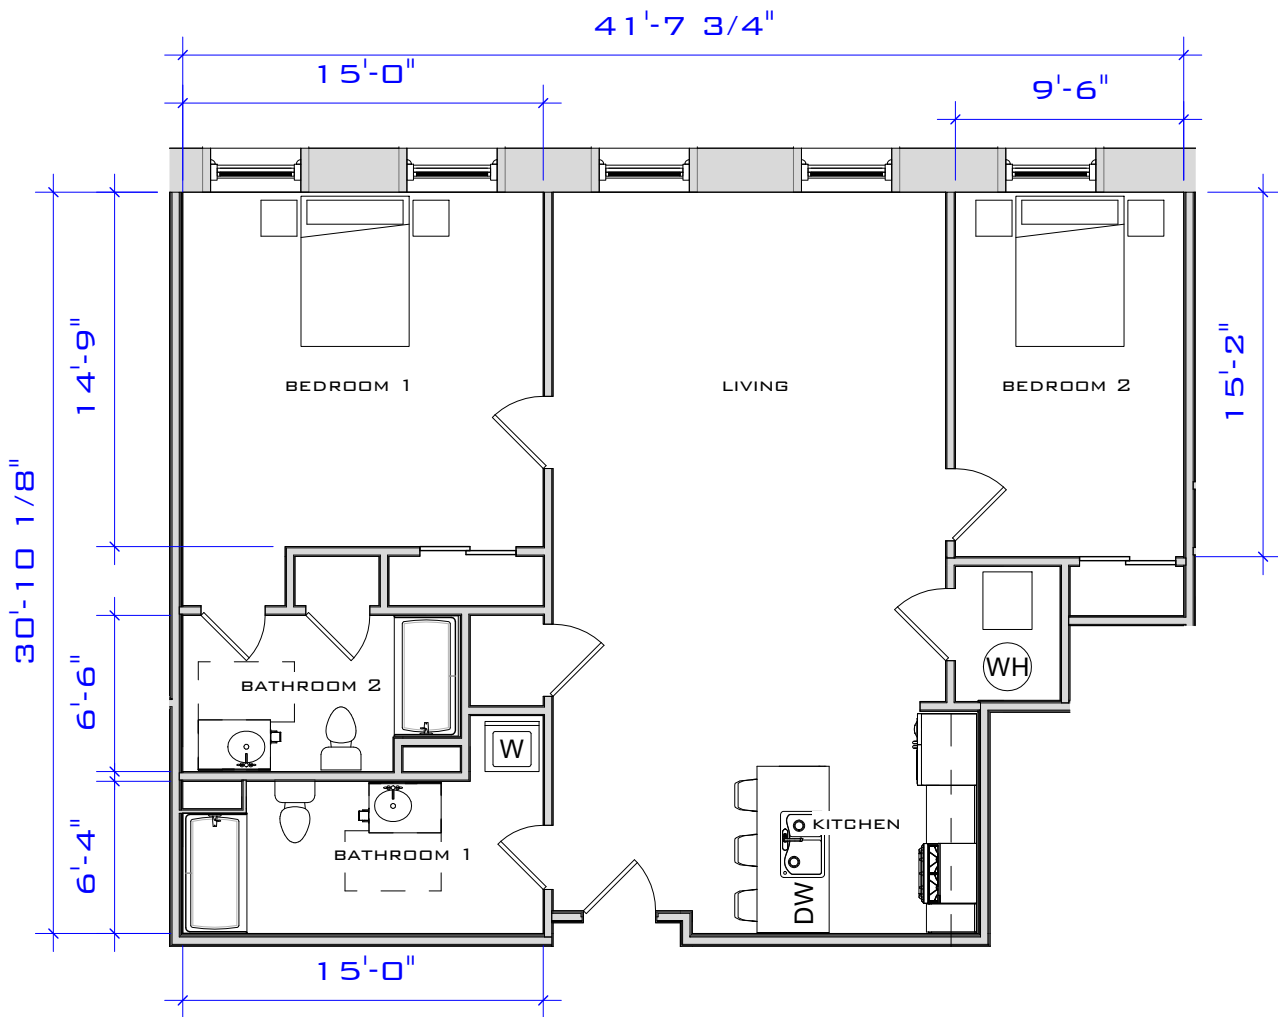

(SIMILAR UNITS: C-101, C-205)

ACTUAL SQUARE FOOTAGE MAY VARY




**JUNCTION
SHOP MILLS
JUNCTION SHOPS
MILL**

UNIT C-101 (1,184 S.F.)

Project number	Project Number
Date	Issue Date
Drawn by	Author
Checked by	Checker

SKA-3-1

Scale 1/8" = 1'-0"

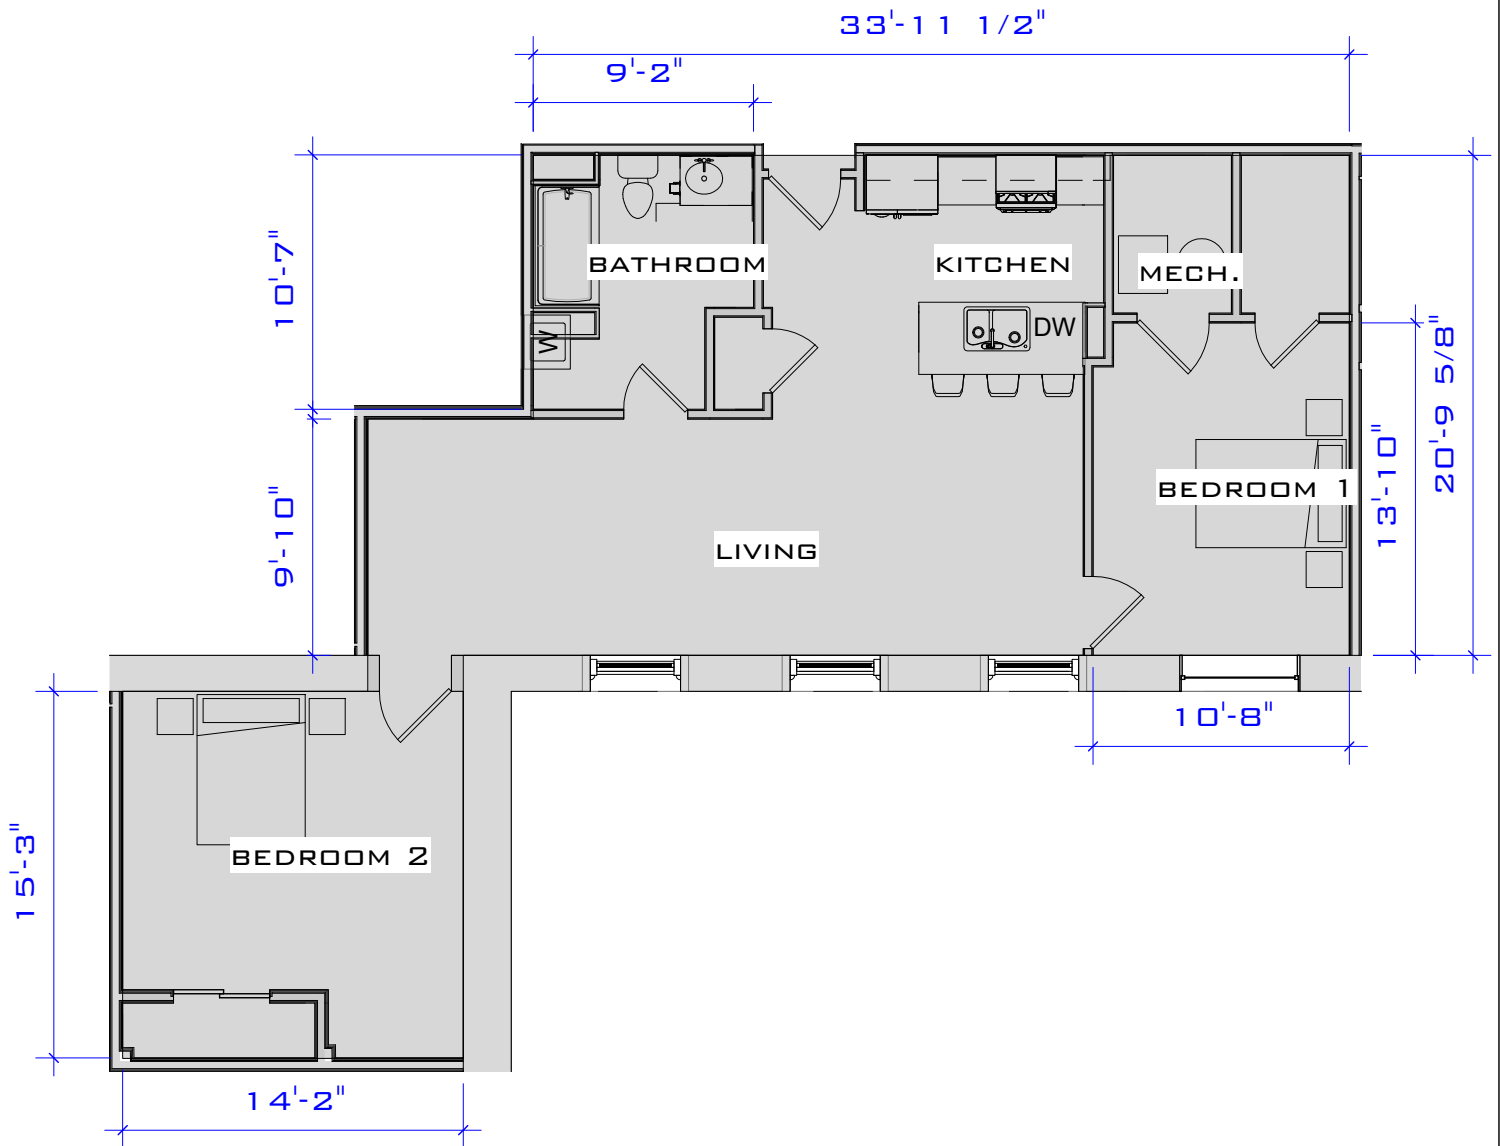

(SIMILAR UNITS: C-102)

THIRD FLOOR UNITS HAVE ELECTRIC FIRE PLACES---CTUAL SQUARE FOOTAGE MAY VARY




**JUNCTION
SHOP MILLS
JUNCTION SHOPS
MILL**

UNIT C-102 (996 S.F.)

Project number	Project Number
Date	Issue Date
Drawn by	Author
Checked by	Checker

SKA-3-2

Scale 1/8" = 1'-0"

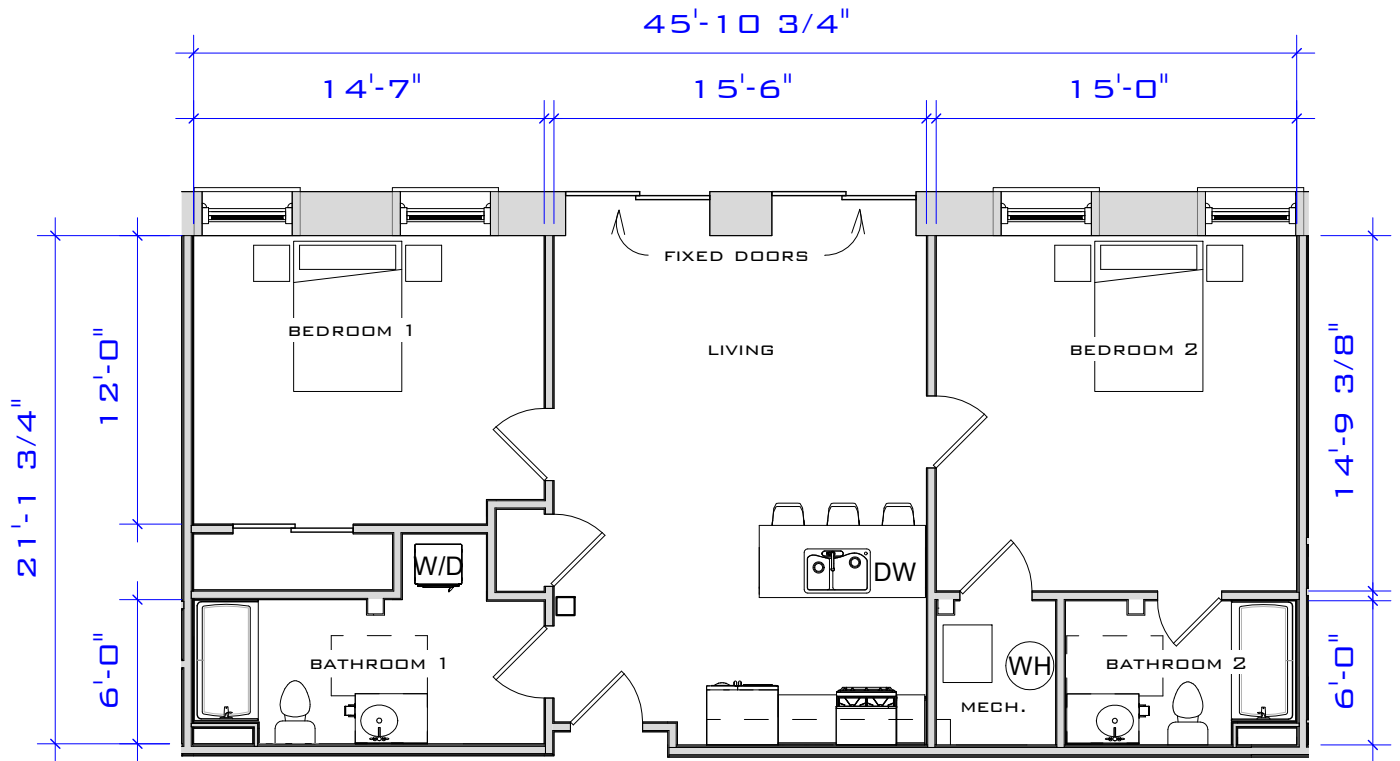

ACTUAL SQUARE FOOTAGE MAY VARY



**JUNCTION
SHOP MILLS
JUNCTION SHOPS
MILL**


UNIT C-103

(972 S.F.)

Project number	Project Number
Date	Issue Date
Drawn by	Author
Checked by	Checker

SKA-3-3

Scale 1/8" = 1'-0"

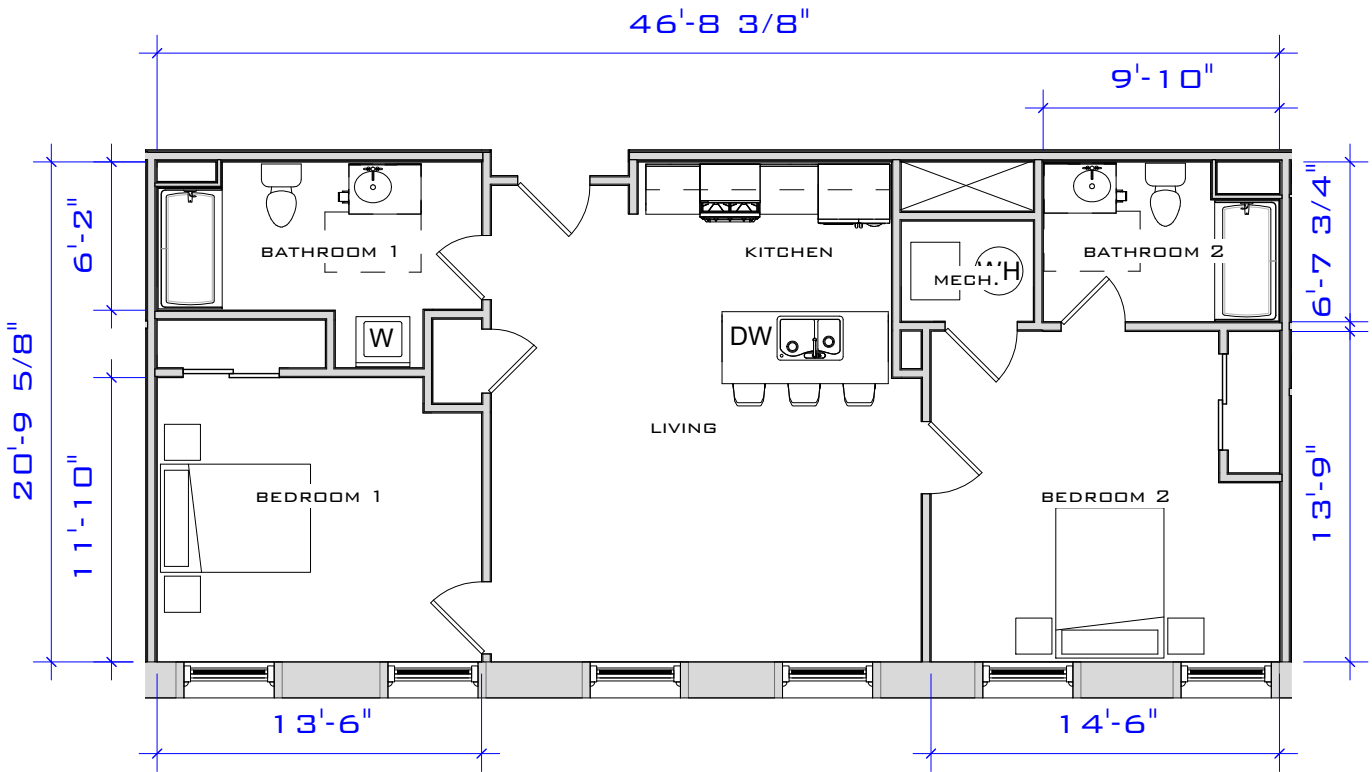

(SIMILAR UNITS: C-104, C-118, C-210, C-220, C-228, C-310, C-318, C-320, C-326, C-327)

THIRD FLOOR UNITS HAVE ELECTRIC FIRE PLACES--- ACTUAL SQUARE FOOTAGE MAY VARY




**JUNCTION
SHOP MILLS
JUNCTION SHOPS
MILL**

UNIT C-104 (972 S.F.)

Project number	Project Number
Date	Issue Date
Drawn by	Author
Checked by	Checker

SKA-3-4

Scale 1/8" = 1'-0"

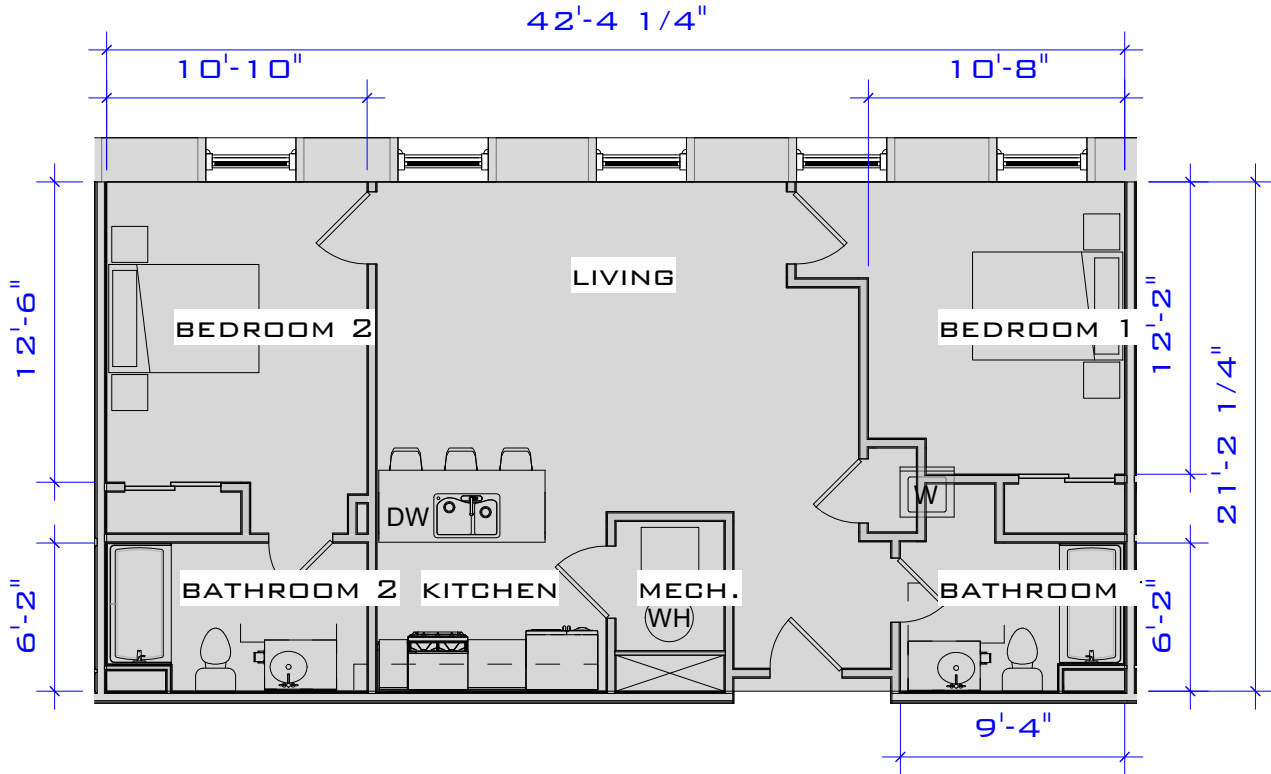

(SIMILAR UNITS: C-105, C-106, C-116, C-117, C-209, C-212, C-225, C-226, C-309, C-312, C-324, C-325)

THIRD FLOOR UNITS HAVE ELECTRIC FIRE PLACES---CTUAL SQUARE FOOTAGE MAY VARY




JUNCTION SHOP MILLS
JUNCTION SHOPS MILL

UNIT C-105 (900 S.F.)

Project number	Project Number
Date	Issue Date
Drawn by	Author
Checked by	Checker

SKA-3-5

Scale 1/8" = 1'-0"

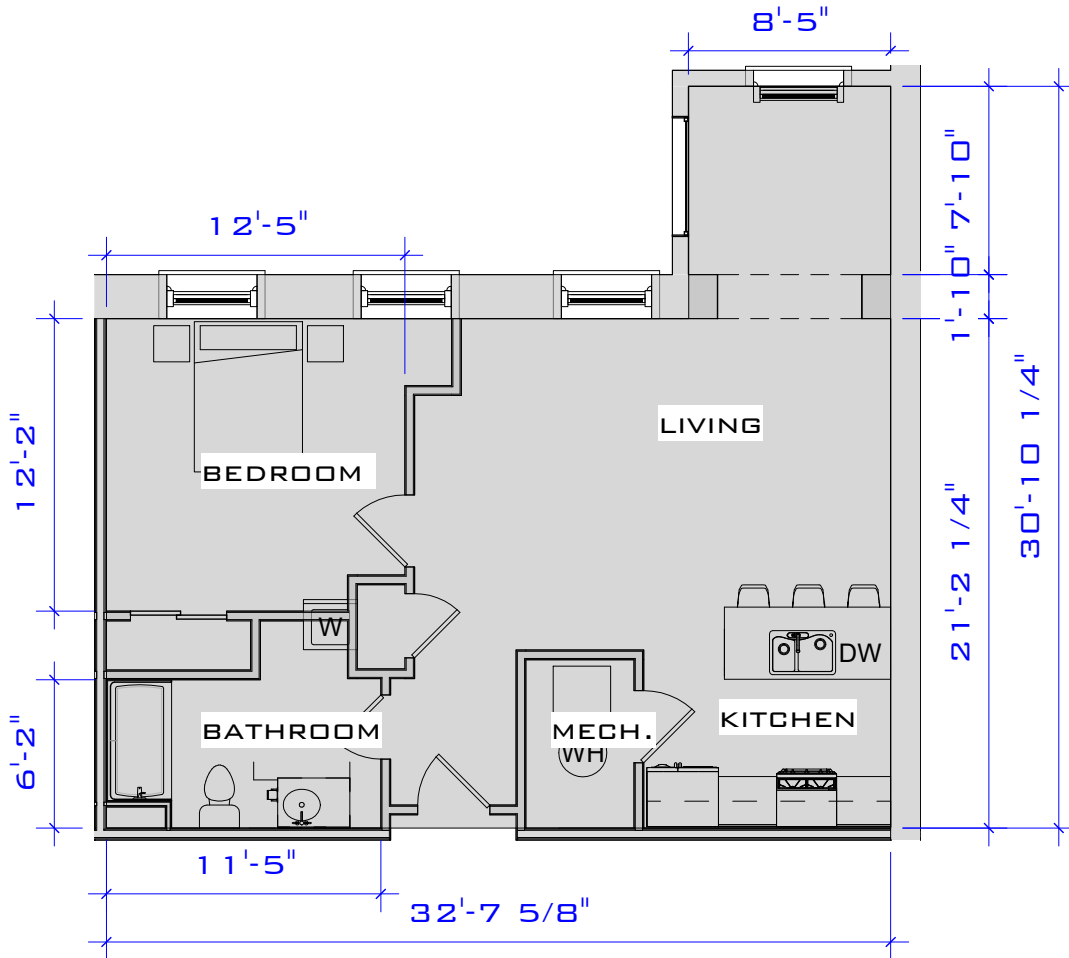

(SIMILAR UNITS: C-107, C-211, C-311)
 THIRD FLOOR UNITS HAVE ELECTRIC FIRE PLACES---~~C~~UAL SQUARE FOOTAGE MAY VARY




JUNCTION SHOP MILLS
 JUNCTION SHOPS MILL

UNIT C-107 (772 S.F.)

Project number	Project Number
Date	Issue Date
Drawn by	Author
Checked by	Checker

SKA-3-6

Scale 1/8" = 1'-0"

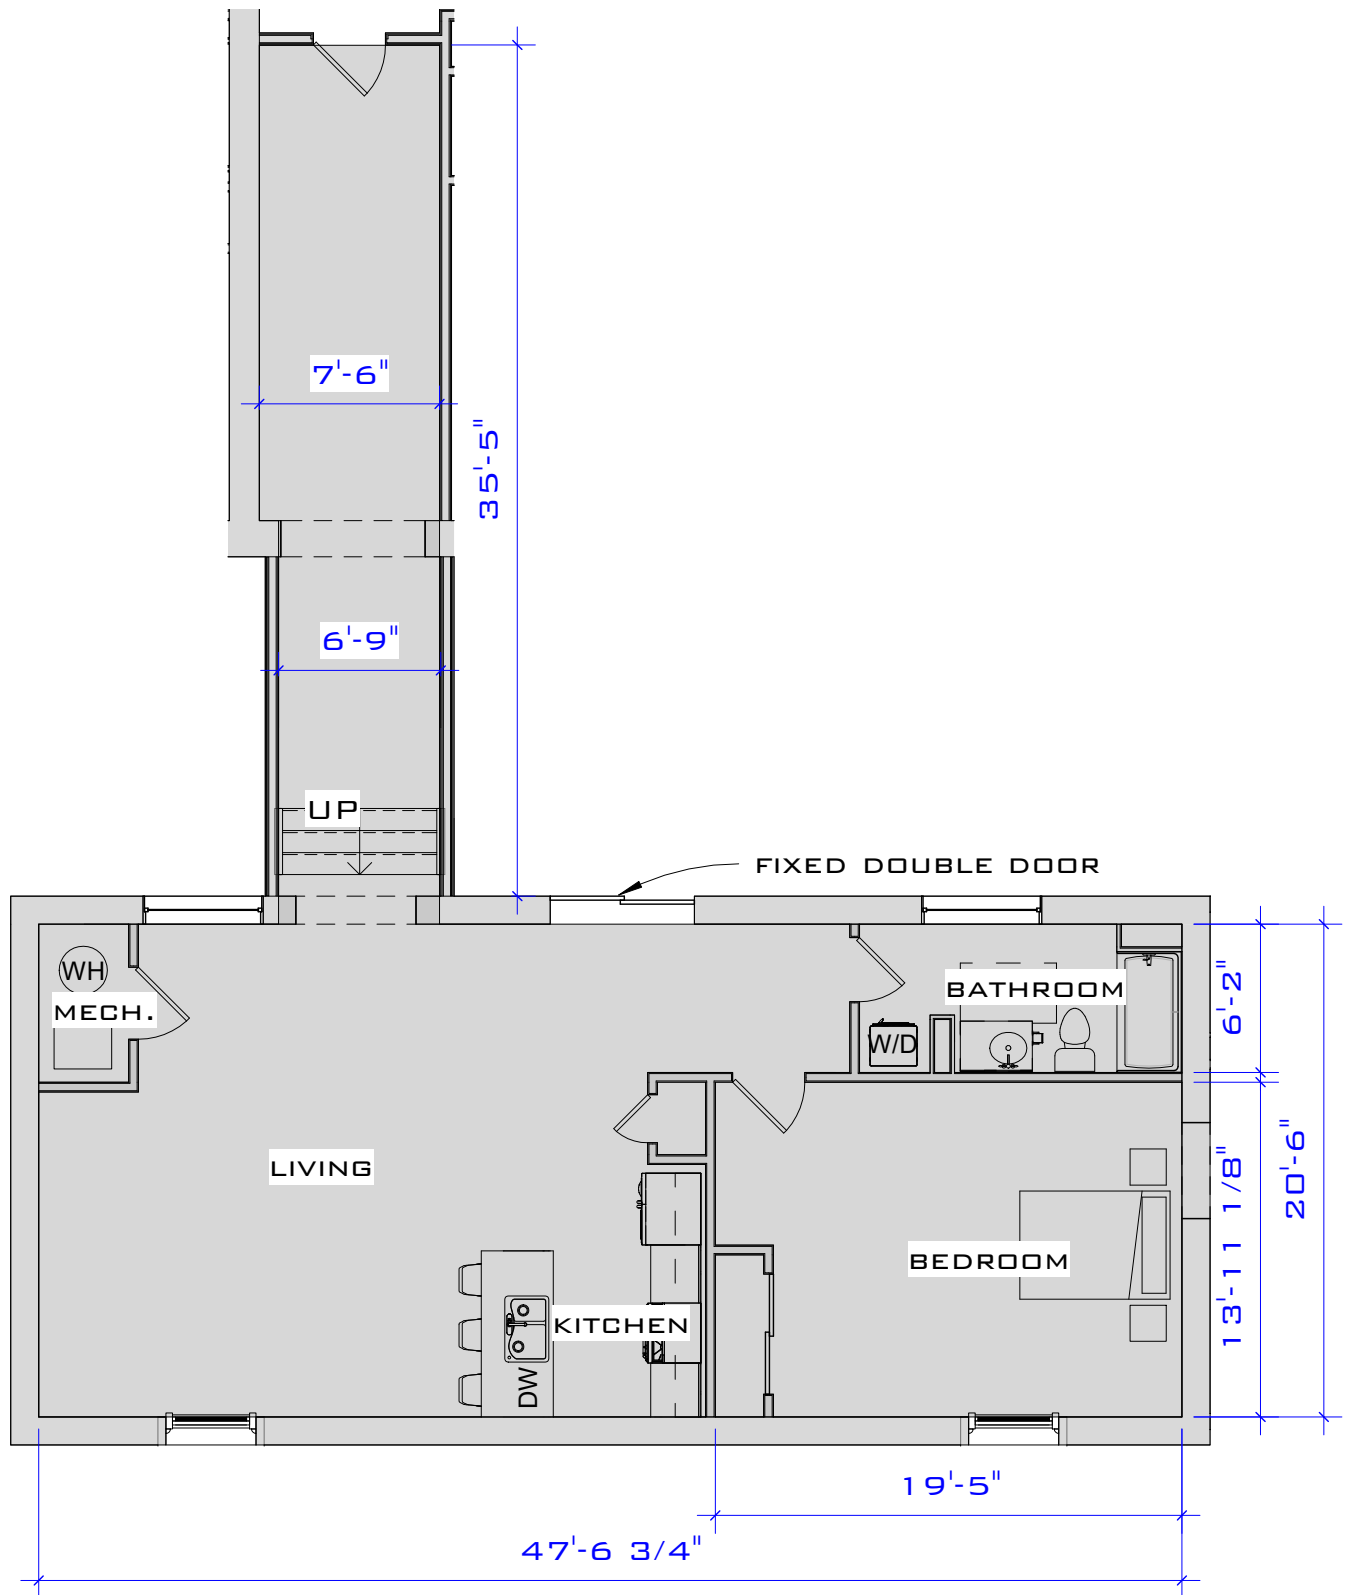

(SIMILAR UNITS: C-108)

THIRD FLOOR UNITS HAVE ELECTRIC FIRE PLACES---CTUAL SQUARE FOOTAGE MAY VARY




**JUNCTION
SHOP MILLS**
JUNCTION SHOPS
MILL

UNIT C-108 (1,236 S.F.)

Project number	Project Number
Date	Issue Date
Drawn by	Author
Checked by	Checker

SKA-3-7

Scale 1/8" = 1'-0"

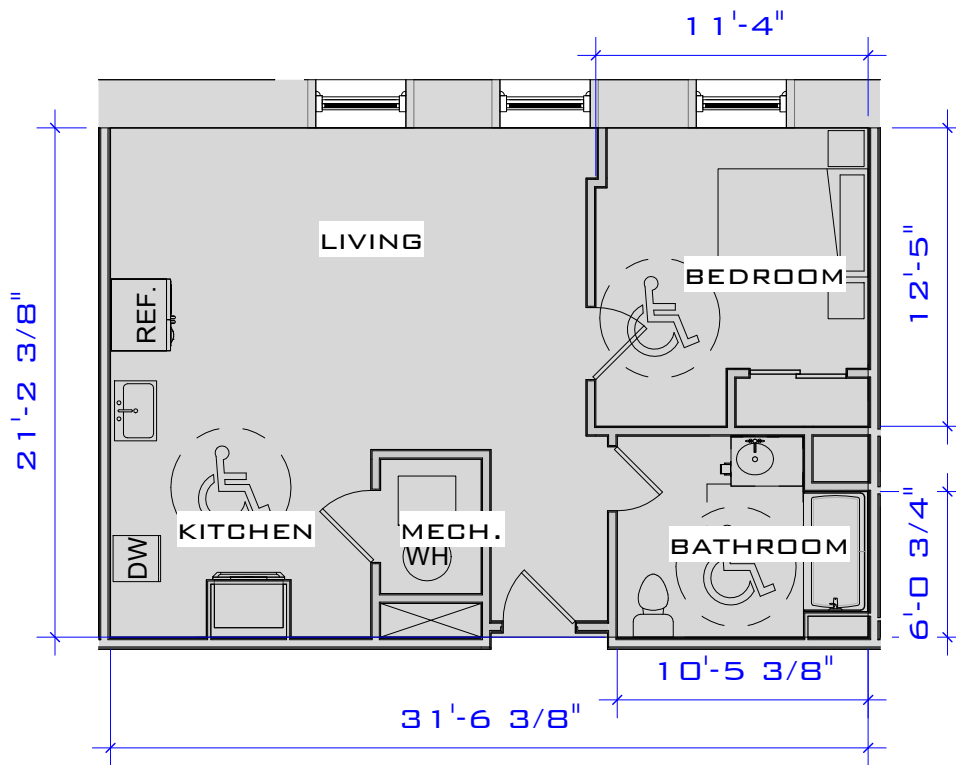

(SIMILAR UNITS: C-109, C-111, C-219, C-221, C-317, C-319)

THIRD FLOOR UNITS HAVE ELECTRIC FIRE PLACES---CTUAL SQUARE FOOTAGE MAY VARY




JUNCTION SHOP MILLS
JUNCTION SHOPS MILL

UNIT C-109 (668 S.F.)

Project number	Project Number
Date	Issue Date
Drawn by	Author
Checked by	Checker

SKA-3-8

Scale 1/8" = 1'-0"

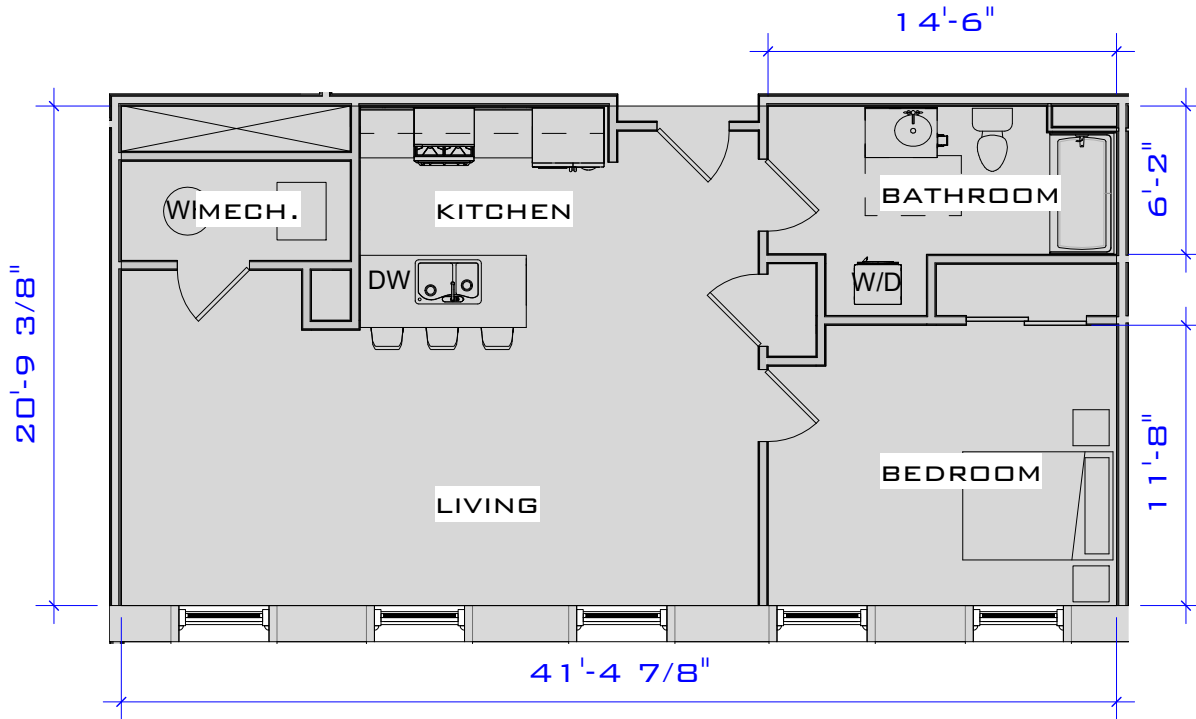

(SIMILAR UNITS: C-110, C-112, C-119, C-214)

THIRD FLOOR UNITS HAVE ELECTRIC FIRE PLACES---CTUAL SQUARE FOOTAGE MAY VARY




**JUNCTION
SHOP MILLS
JUNCTION SHOPS
MILL**

UNIT C-110 (860 S.F.)

Project number	Project Number
Date	Issue Date
Drawn by	Author
Checked by	Checker

SKA-3-9

Scale 1/8" = 1'-0"

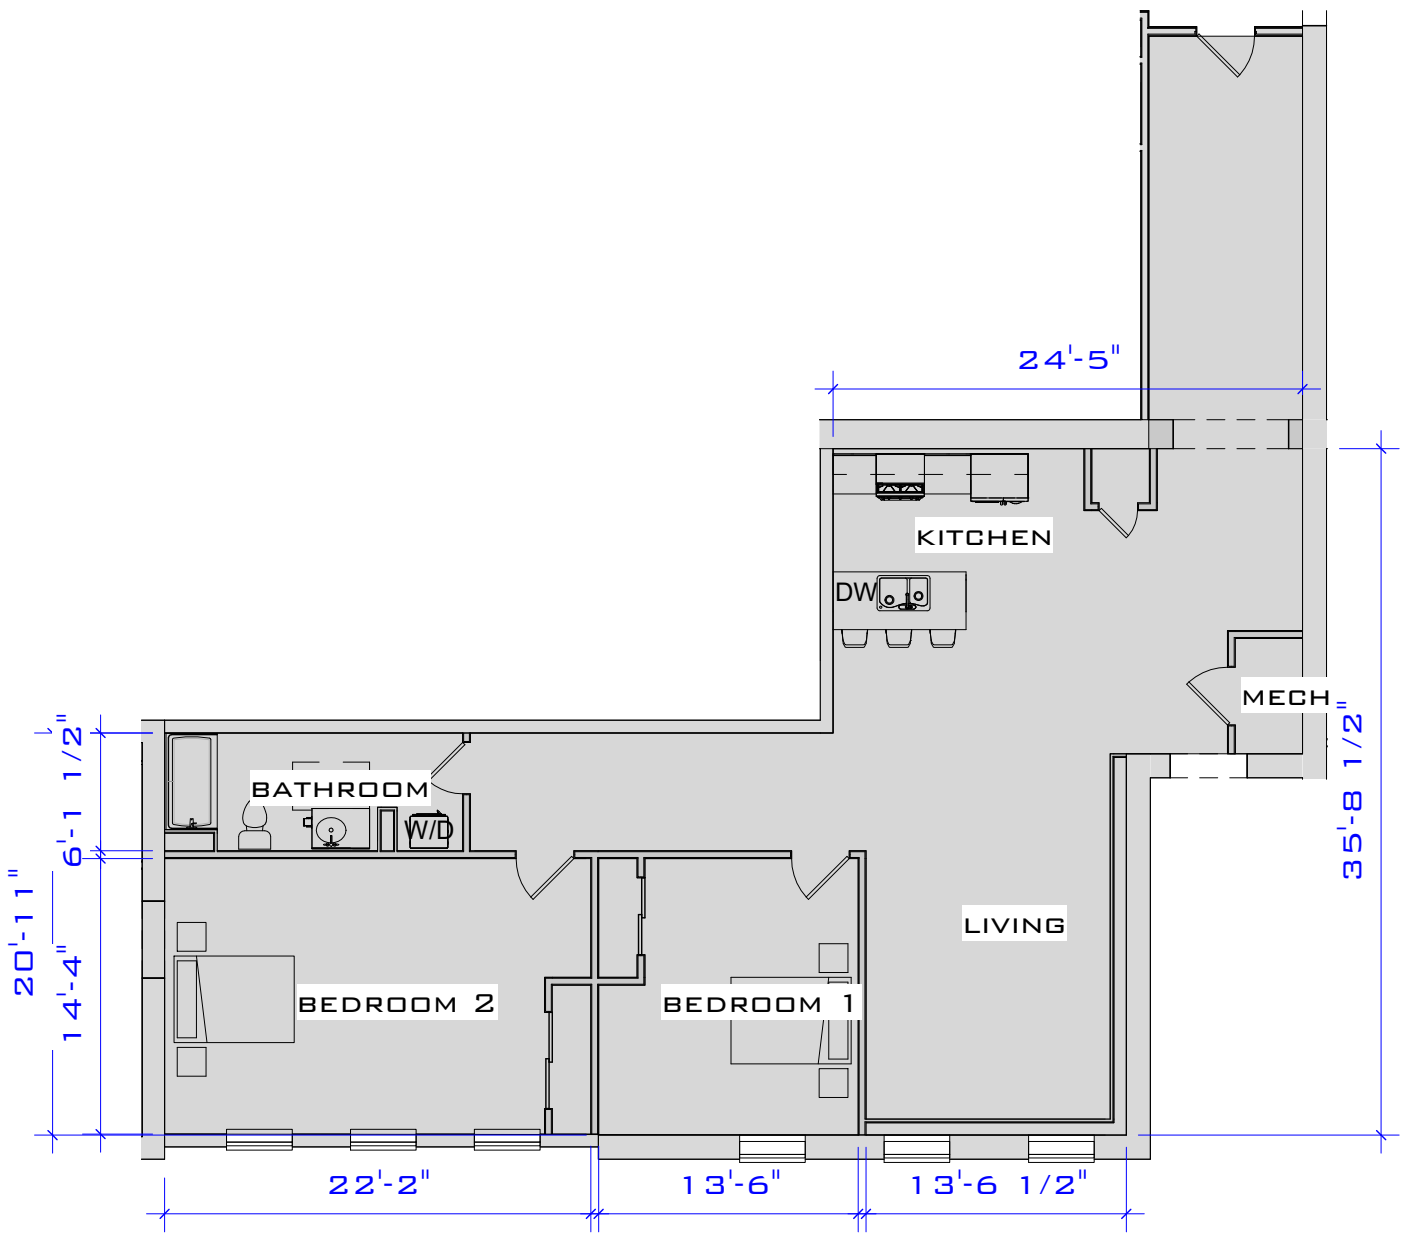

(SIMILAR UNITS: C-113)

THIRD FLOOR UNITS HAVE ELECTRIC FIRE PLACES---CTUAL SQUARE FOOTAGE MAY VARY




**JUNCTION
SHOP MILLS
JUNCTION SHOPS
MILL**

UNIT C-113 (1,587 S.F.)

Project number	Project Number
Date	Issue Date
Drawn by	Author
Checked by	Checker

SKA-3-10

Scale 1" = 10'-0"

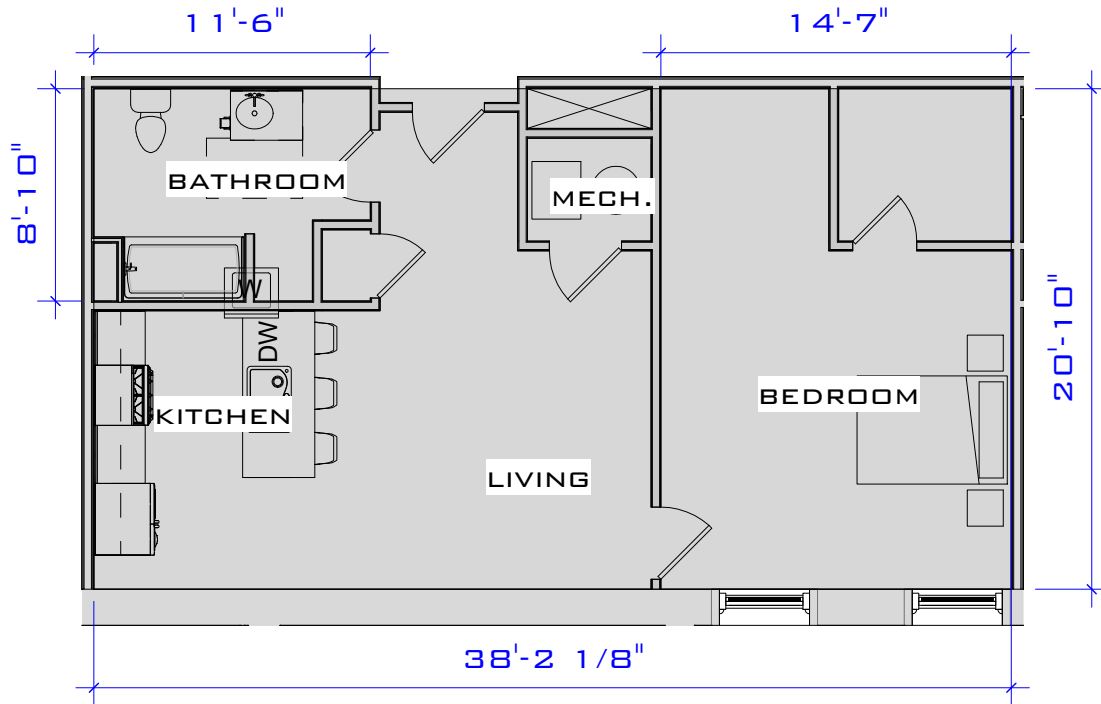

(SIMILAR UNITS: C-114)


THIRD FLOOR UNITS HAVE ELECTRIC FIRE PLACES---CTUAL SQUARE FOOTAGE MAY VARY



**JUNCTION
SHOP MILLS
JUNCTION SHOPS
MILL**

UNIT C-114 (795 S.F.)

Project number	Project Number	SKA-3-11
Date	Issue Date	
Drawn by	Author	Scale 1/8" = 1'-0"
Checked by	Checker	

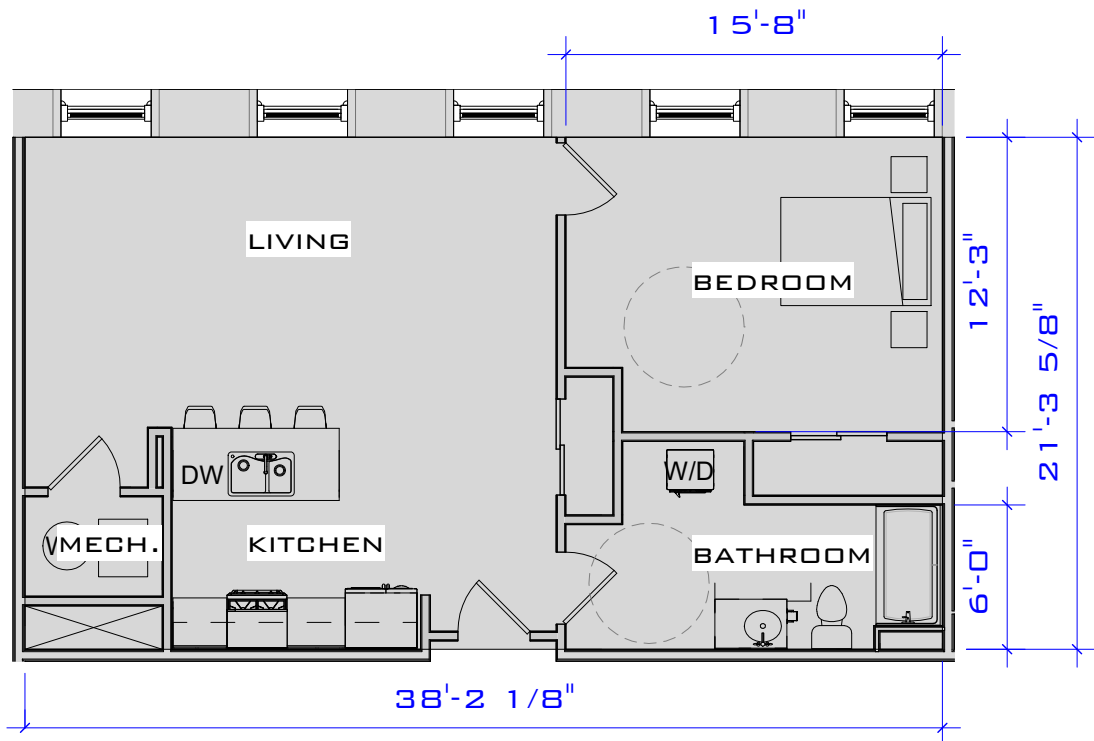

(SIMILAR U) **ADA UNIT**


THIRD FLOOR UNITS HAVE ELECTRIC FIRE PLACES---CTUAL SQUARE FOOTAGE MAY VARY



**JUNCTION
SHOP MILLS**
JUNCTION SHOPS
MILL

UNIT C-115 (814 S.F.)

Project number	Project Number	SKA-3-12
Date	Issue Date	
Drawn by	Author	Scale 1/8" = 1'-0"
Checked by	Checker	

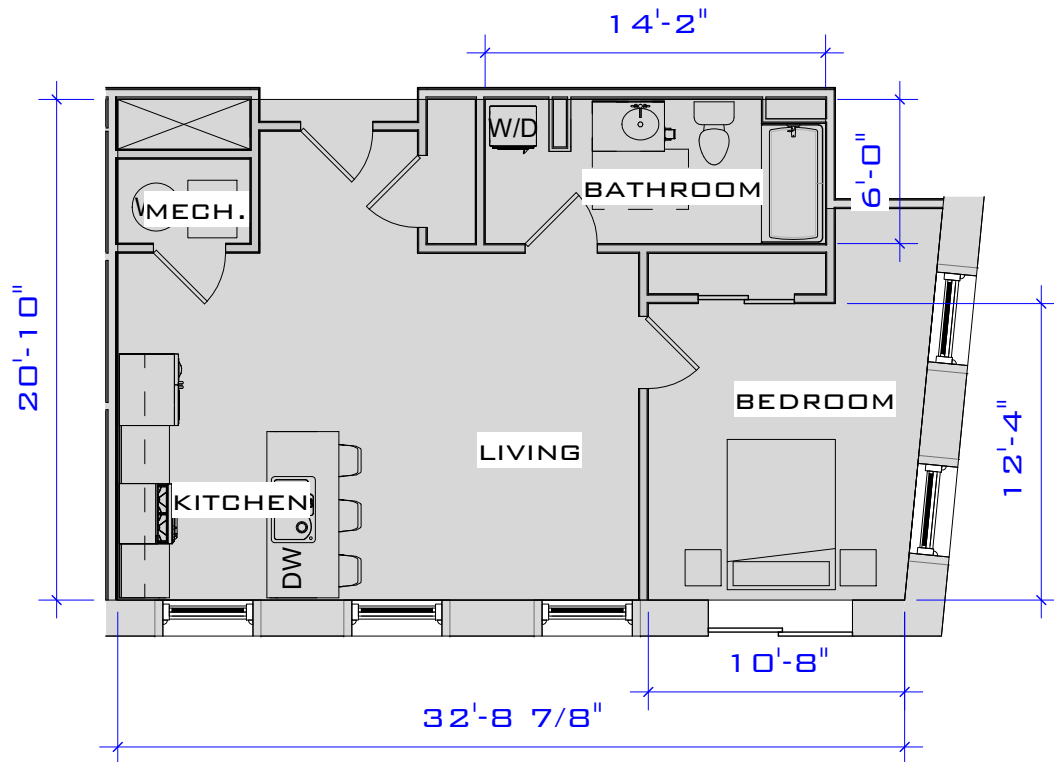


(SIMILAR UNITS: C-120, C-230, C-329)
 THIRD FLOOR UNITS HAVE ELECTRIC FIRE PLACES--ACTUAL SQUARE FOOTAGE MAY VARY



**JUNCTION
 SHOP MILLS
 JUNCTION SHOPS
 MILL**

UNIT C-120 (680 S.F.)

Project number	Project Number	SKA-3-13
Date	Issue Date	
Drawn by	Author	
Checked by	Checker	
Scale		1/8" = 1'-0"

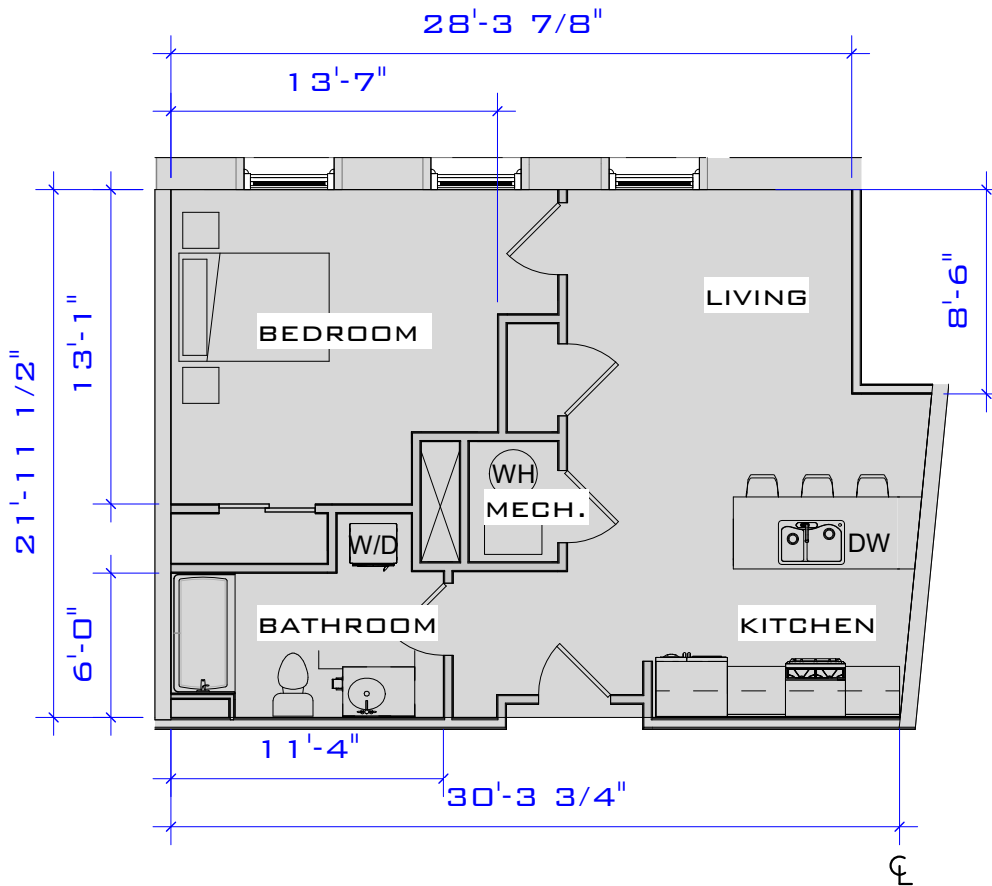

(SIMILAR UNITS: C-121, C-229, C-328)


THIRD FLOOR UNITS HAVE ELECTRIC FIRE PLACES---ACTUAL SQUARE FOOTAGE MAY VARY



**JUNCTION
SHOP MILLS
JUNCTION SHOPS
MILL**

UNIT C-121 (660 S.F.)

Project number	Project Number	SKA-3-14
Date	Issue Date	
Drawn by	Author	Scale 1/8" = 1'-0"
Checked by	Checker	

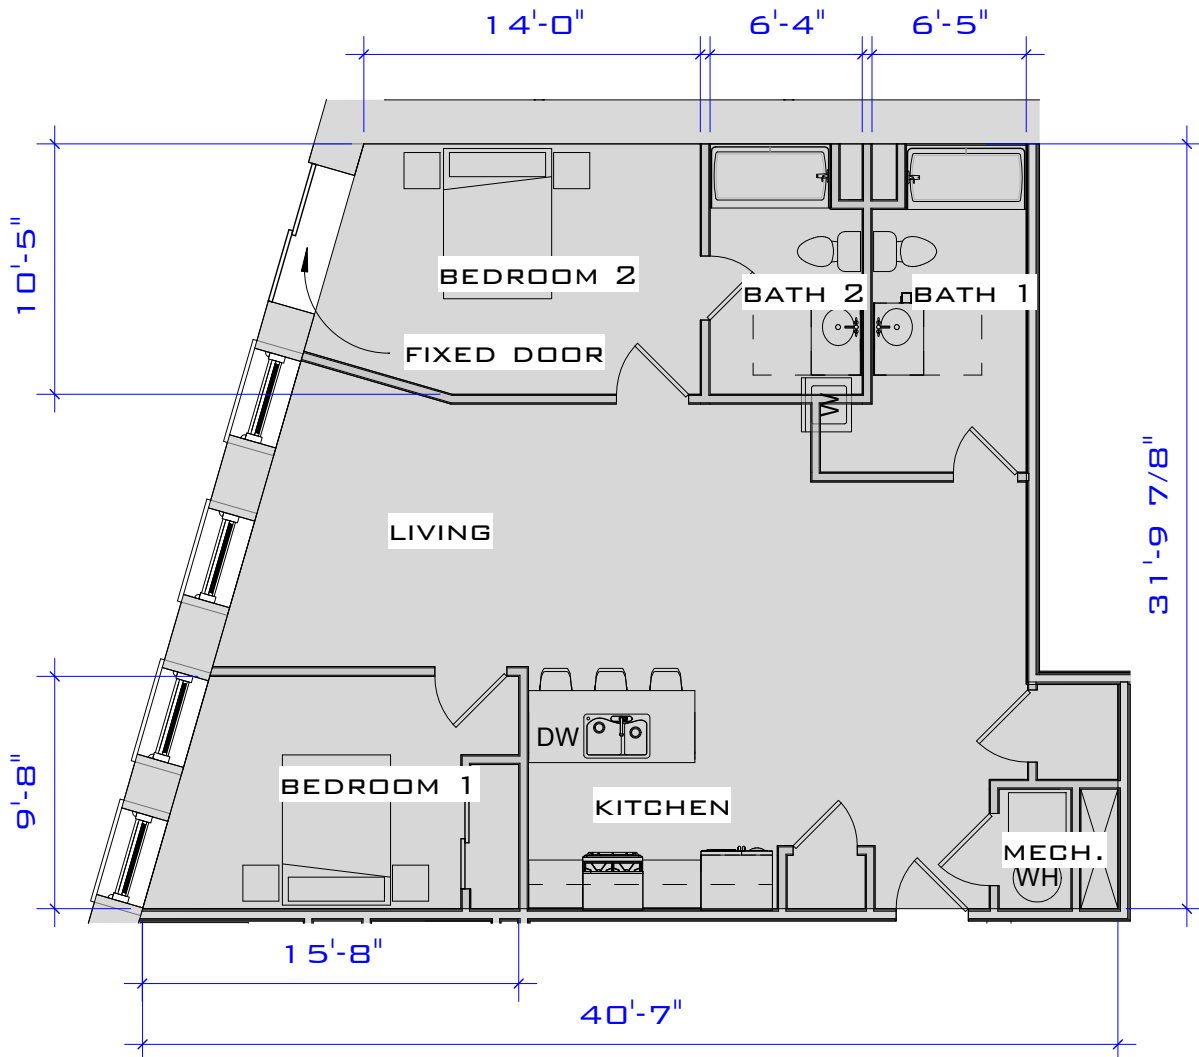

(SIMILAR UNITS: C-201, C-301)


THIRD FLOOR UNITS HAVE ELECTRIC FIRE PLACES---CTUAL SQUARE FOOTAGE MAY VARY



**JUNCTION
SHOP MILLS
JUNCTION SHOPS
MILL**

UNIT C-201 (1,060 S.F.)

Project number	Project Number	SKA-3-15
Date	Issue Date	
Drawn by	Author	
Checked by	Checker	
Scale		1/8" = 1'-0"

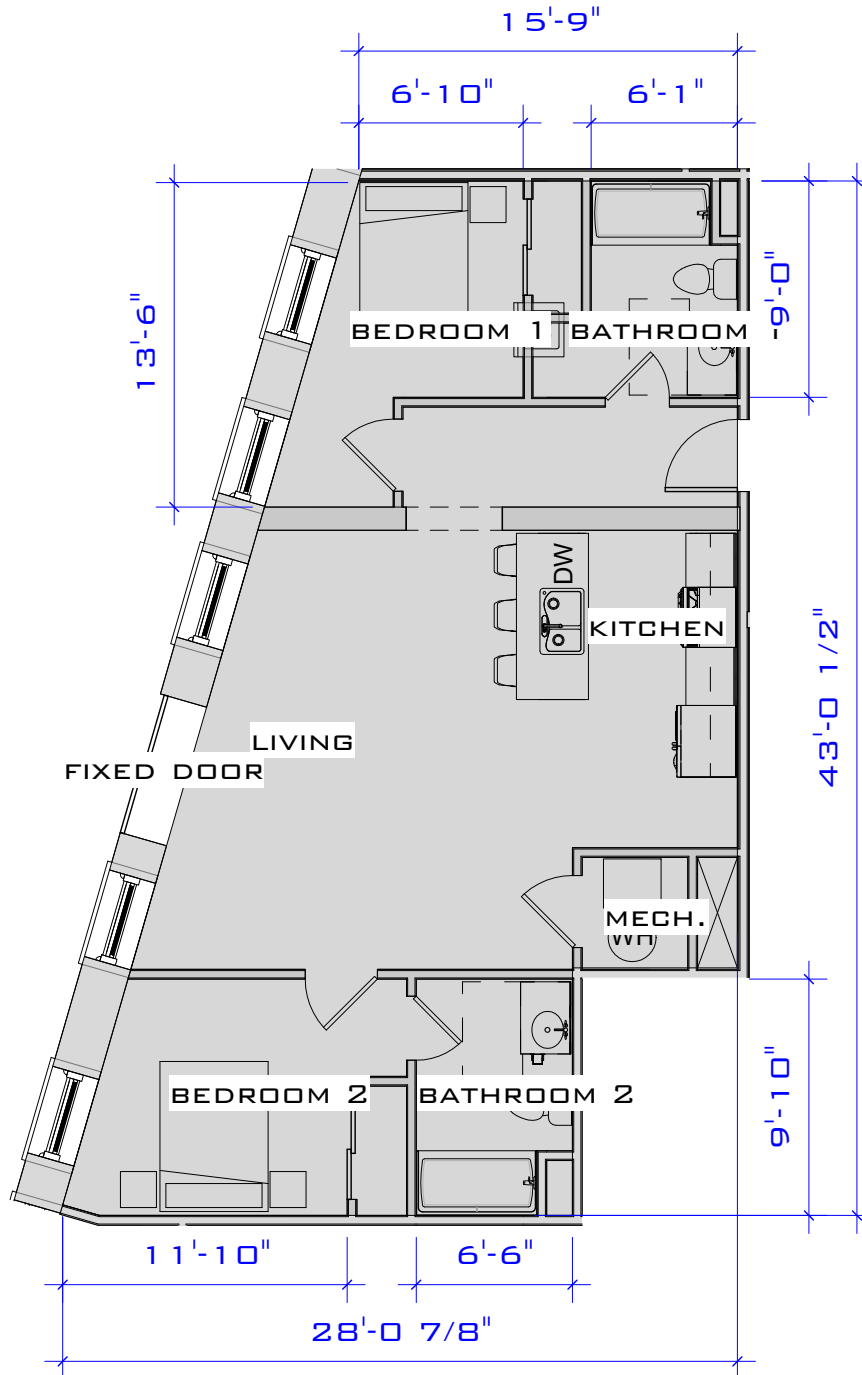

(SIMILAR UNITS: C-202, C-302)


THIRD FLOOR UNITS HAVE ELECTRIC FIRE PLACES---CTUAL SQUARE FOOTAGE MAY VARY



**JUNCTION
SHOP MILLS
JUNCTION SHOPS
MILL**

UNIT C-202 (875 S.F.)

Project number	Project Number	SKA-3-16
Date	Issue Date	
Drawn by	Author	Scale 1/8" = 1'-0"
Checked by	Checker	

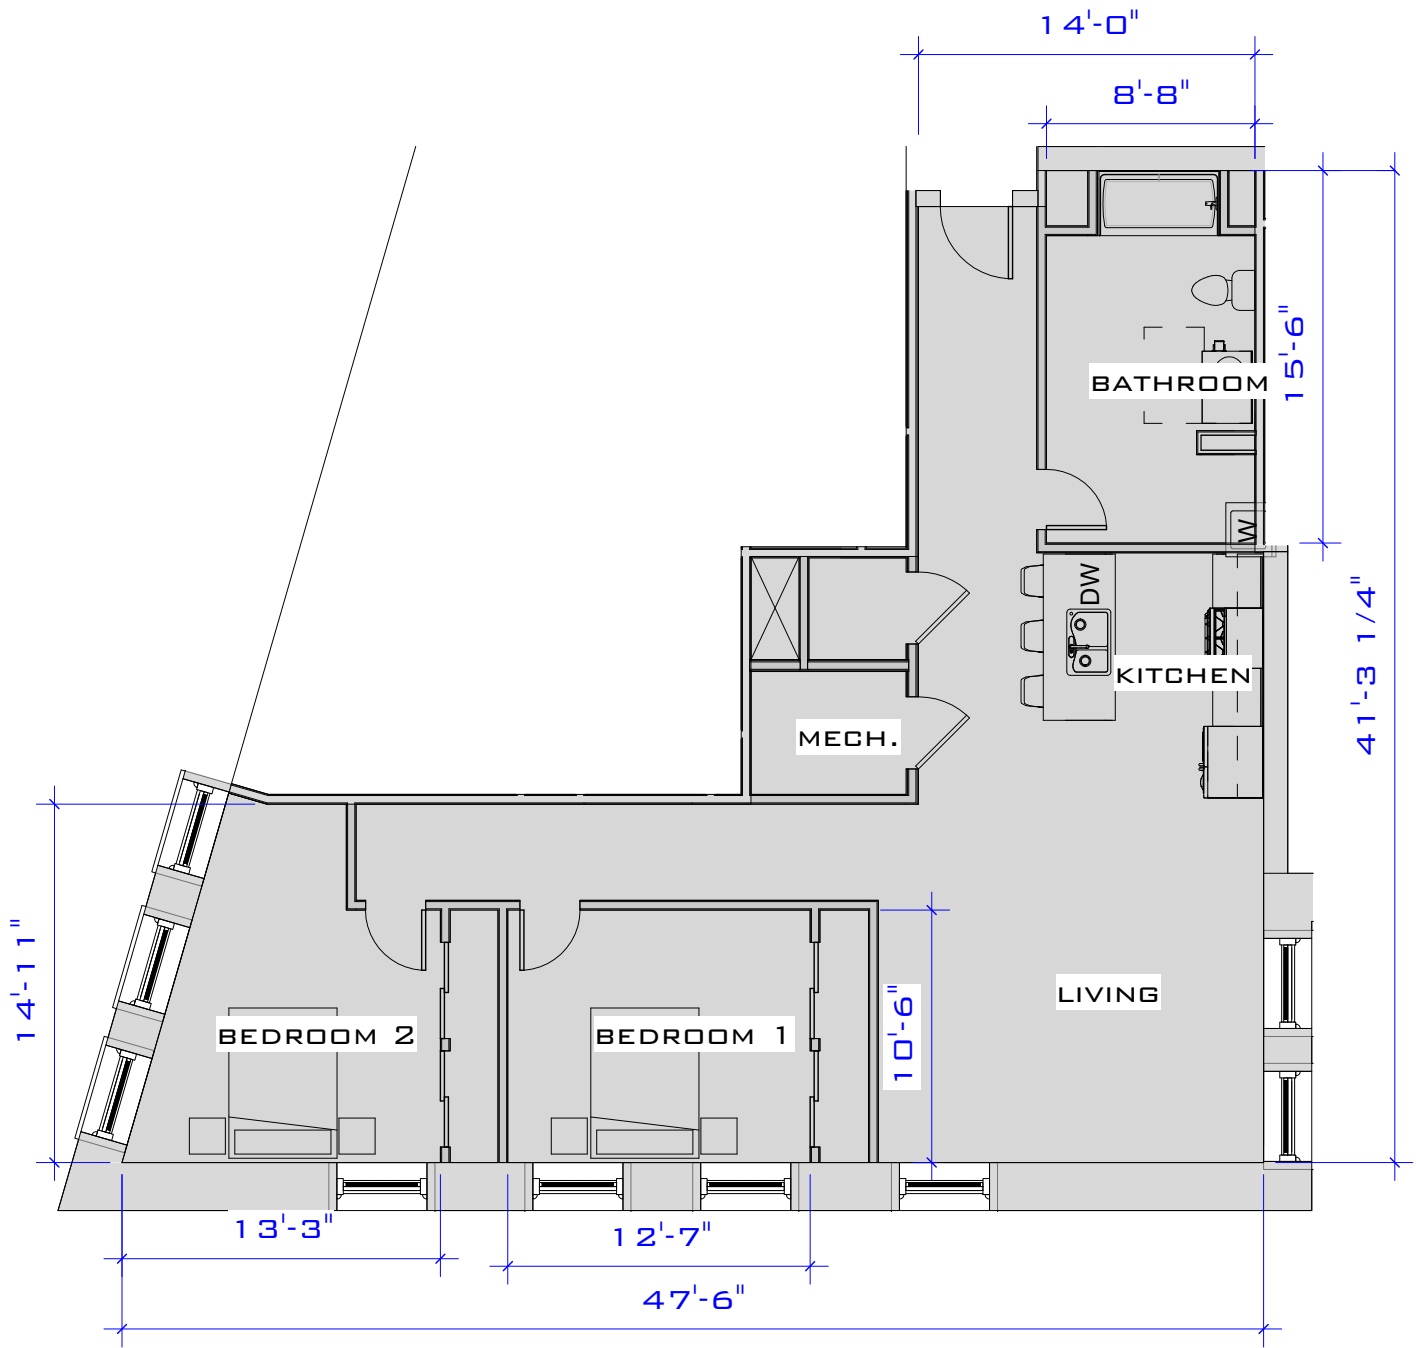

(SIMILAR UNITS: C-203, C-303)

THIRD FLOOR UNITS HAVE ELECTRIC FIRE PLACES---CTUAL SQUARE FOOTAGE MAY VARY



**JUNCTION
SHOP MILLS
JUNCTION SHOPS
MILL**

UNIT C-203 (1,114 S.F.)

Project number Project Number


Date Issue Date

Drawn by Author

Checked by Checker

SKA-3-17

Scale 1/8" = 1'-0"

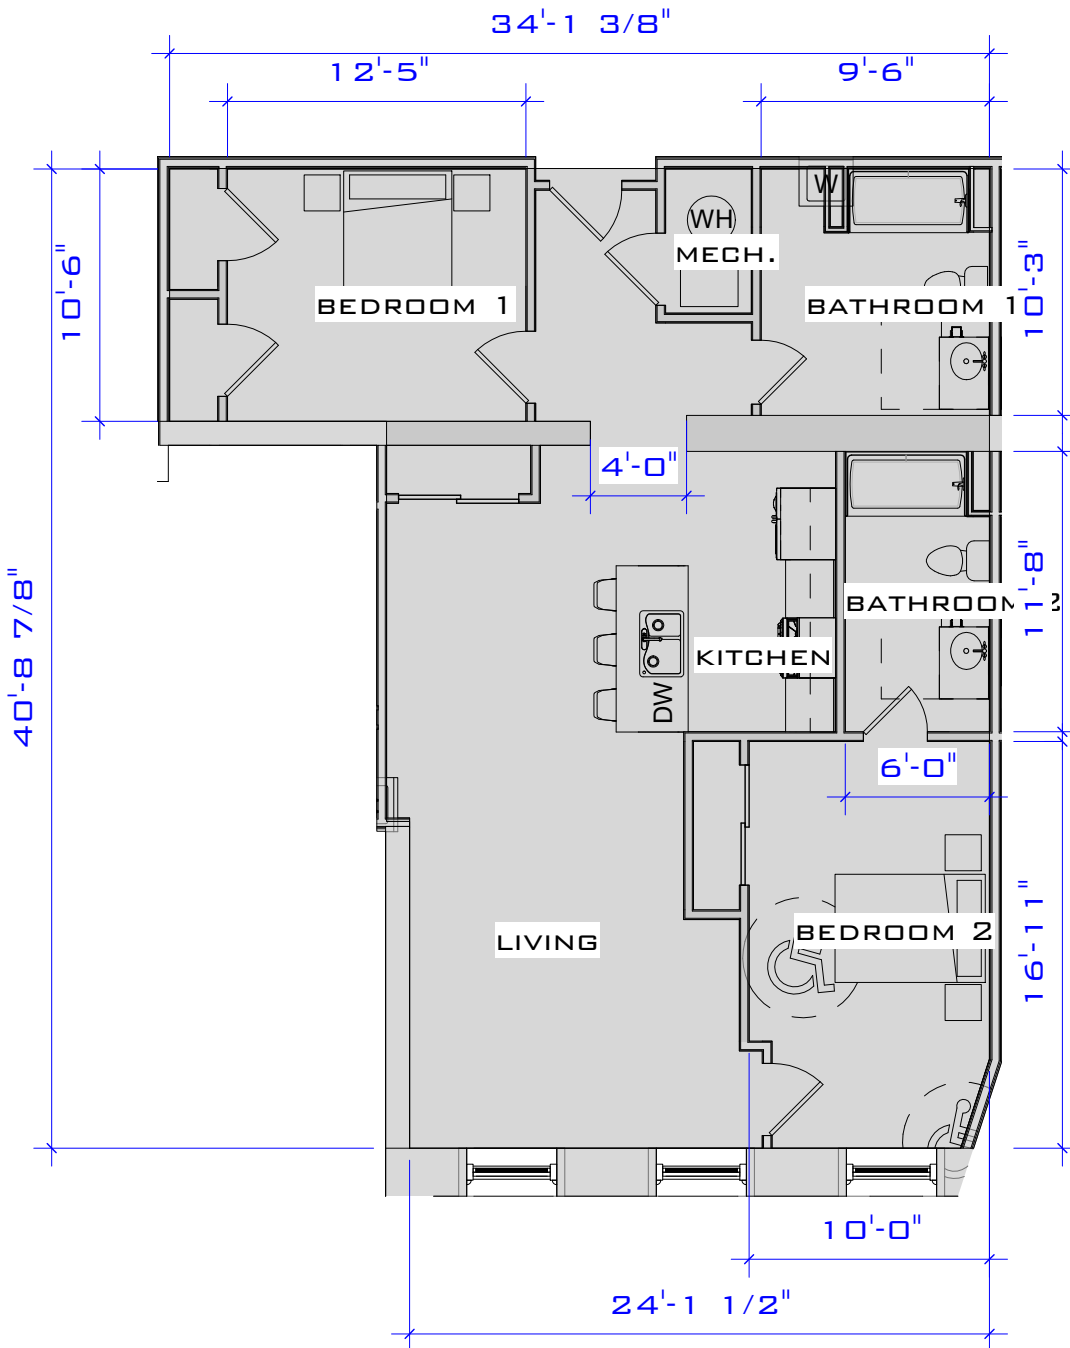

(SIMILAR UNITS: C-204, C-304)

THIRD FLOOR UNITS HAVE ELECTRIC FIRE PLACES---CTUAL SQUARE FOOTAGE MAY VARY




**JUNCTION
SHOP MILLS
JUNCTION SHOPS
MILL**

UNIT C-204 (1,102 S.F.)

Project number	Project Number
Date	Issue Date
Drawn by	Author
Checked by	Checker

SKA-3-18

Scale 1/8" = 1'-0"

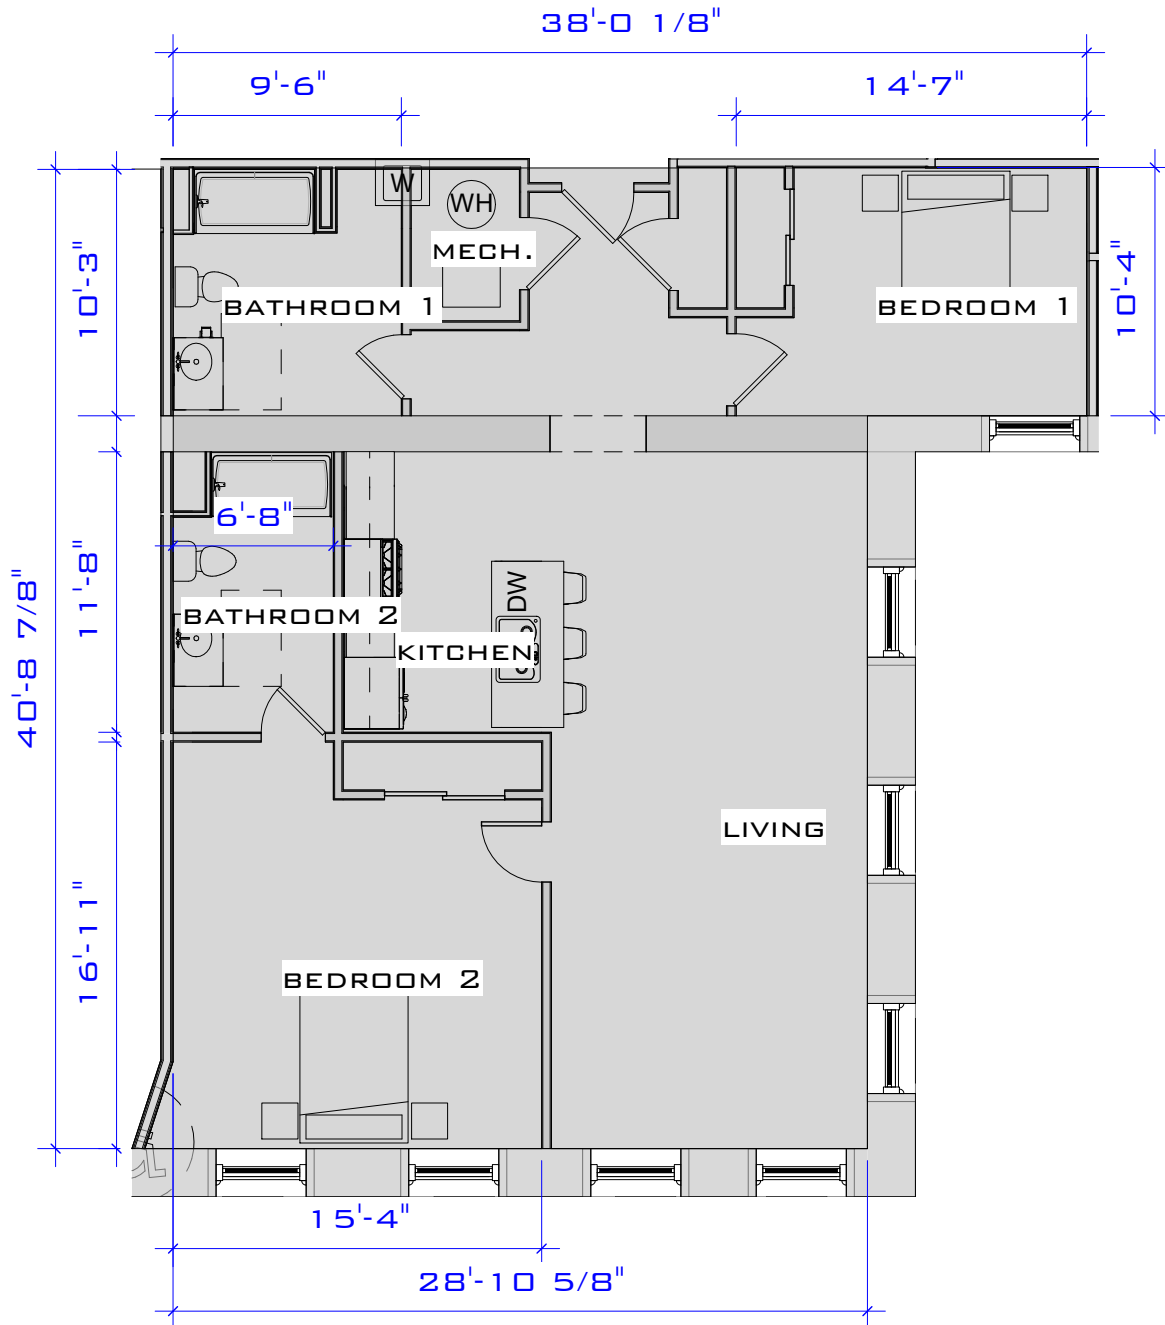

(SIMILAR UNITS: C-206, C-306)

THIRD FLOOR UNITS HAVE ELECTRIC FIRE PLACES---CTUAL SQUARE FOOTAGE MAY VARY




**JUNCTION
SHOP MILLS
JUNCTION SHOPS
MILL**

UNIT C-206 (1,275 S.F.)

Project number	Project Number
Date	Issue Date
Drawn by	Author
Checked by	Checker

SKA-3-19

Scale 1/8" = 1'-0"

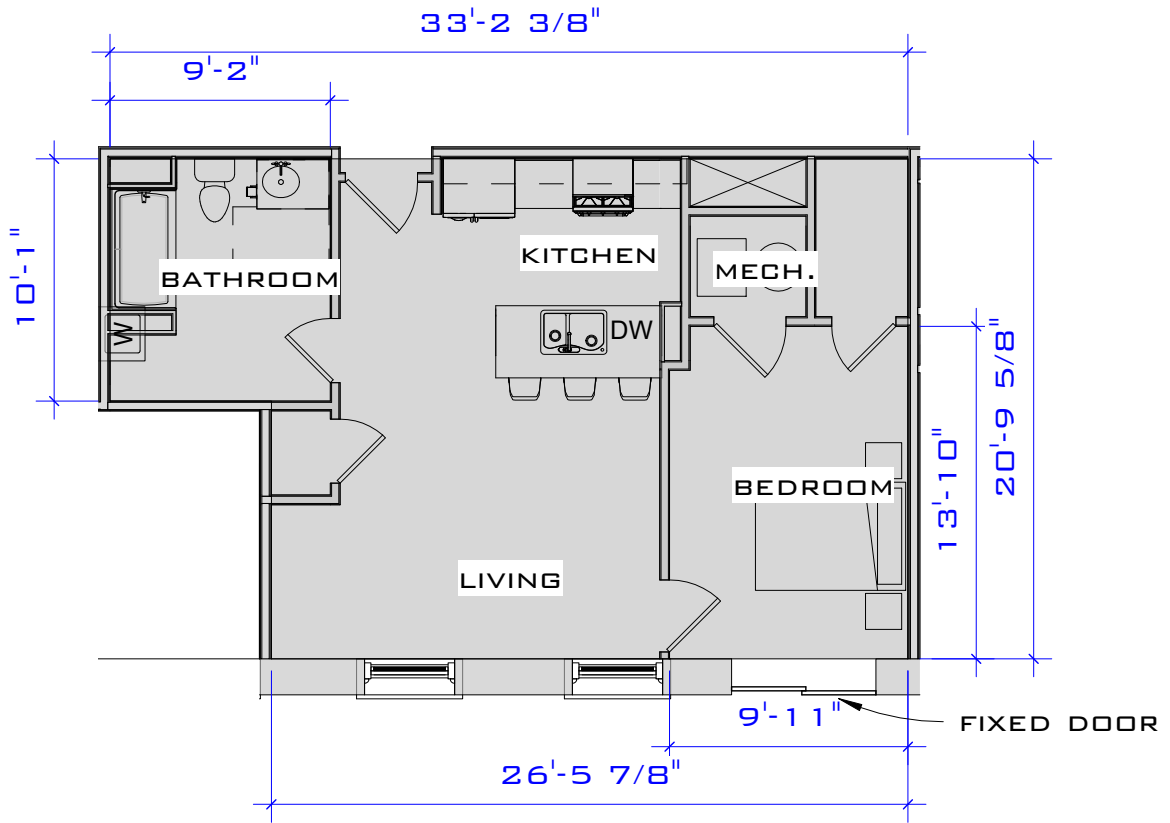

(SIMILAR UNITS: C-208, C-308)


THIRD FLOOR UNITS HAVE ELECTRIC FIRE PLACES---CTUAL SQUARE FOOTAGE MAY VARY



**JUNCTION
SHOP MILLS
JUNCTION SHOPS
MILL**

UNIT C-208 (618 S.F.)

Project number	Project Number	SKA-3-20
Date	Issue Date	
Drawn by	Author	Scale 1/8" = 1'-0"
Checked by	Checker	

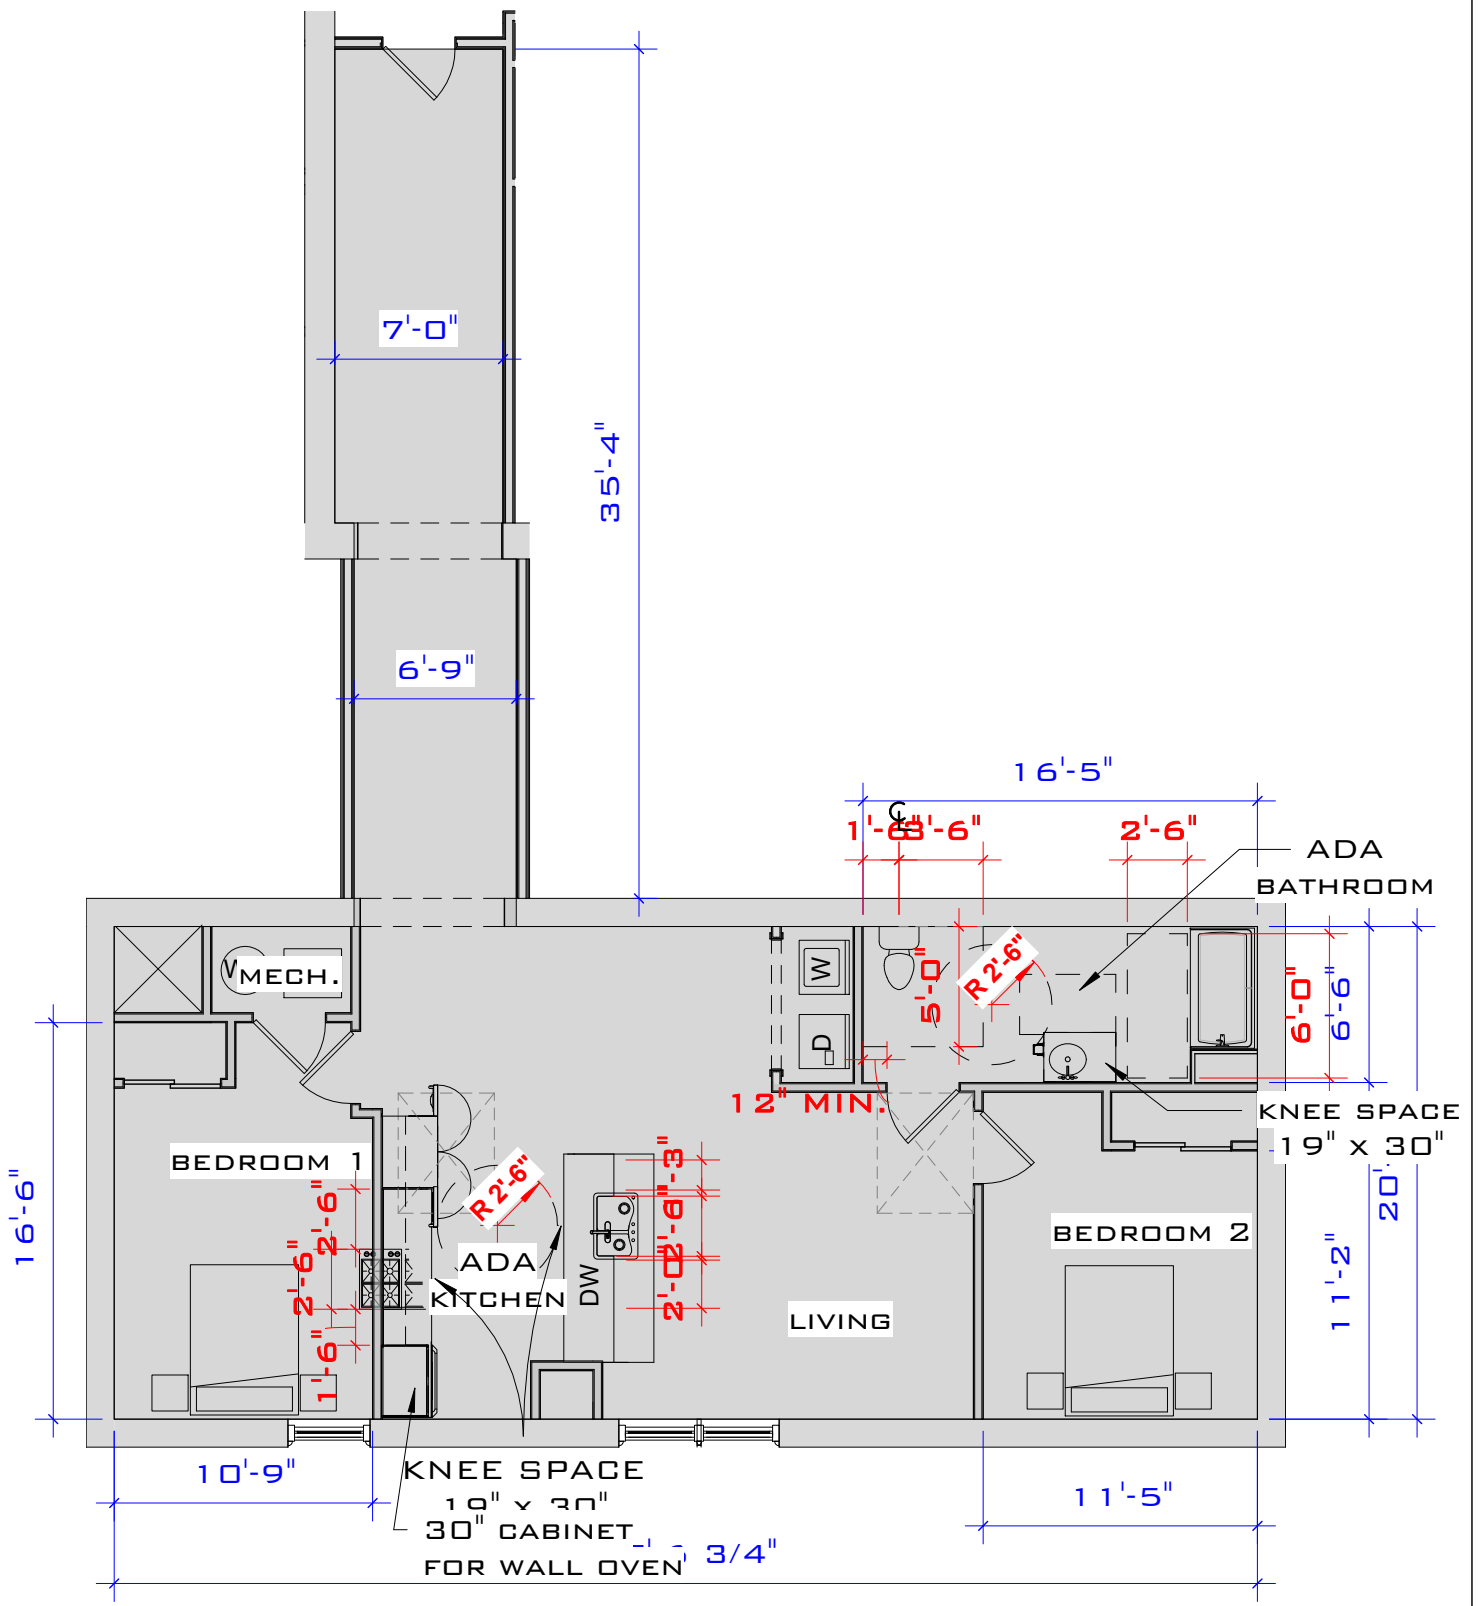

ADA UNIT NITS: C-213)

THIRD FLOOR UNITS H/


QUARE FOOTAGE MAY VARY



**JUNCTION
 SHOP MILLS**
 JUNCTION SHOPS
 MILL

UNIT C-213 (1,226 S.F.)

Project number	Project Number	SKA-3-21
Date	Issue Date	
Drawn by	Author	
Checked by	Checker	
Scale		1/8" = 1'-0"

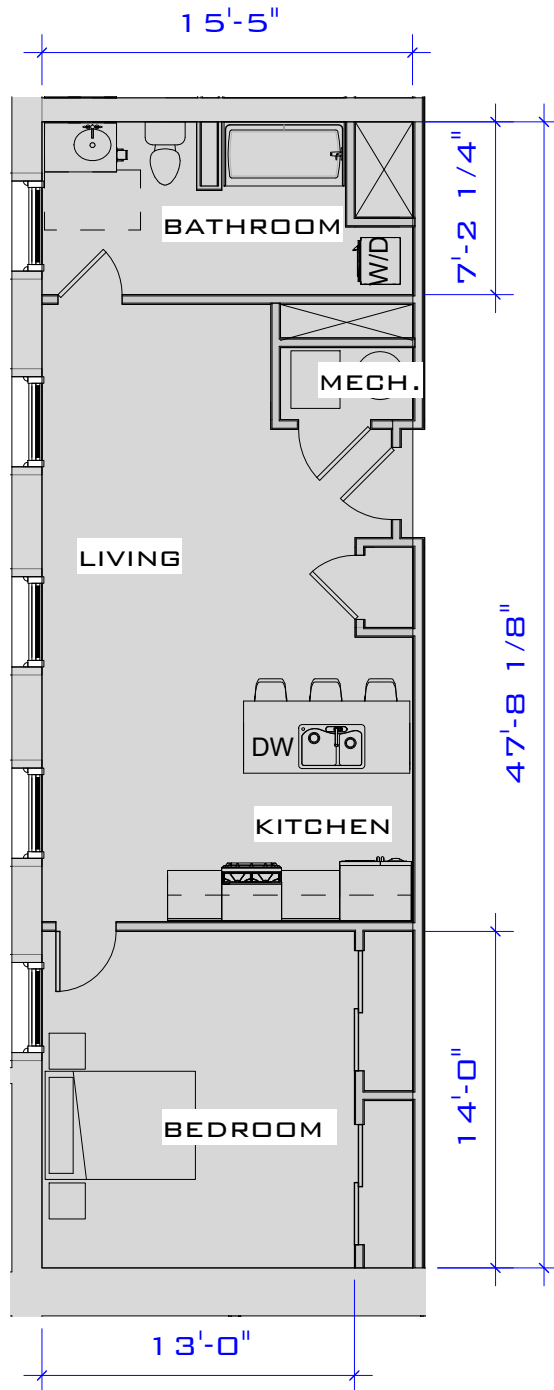

(SIMILAR UNITS: C-215, C-313)


THIRD FLOOR UNITS HAVE ELECTRIC FIRE PLACES---CTUAL SQUARE FOOTAGE MAY VARY



**JUNCTION
SHOP MILLS
JUNCTION SHOPS
MILL**

UNIT C-215 (736 S.F.)

Project number	Project Number	SKA-3-22
Date	Issue Date	
Drawn by	Author	Scale 1/8" = 1'-0"
Checked by	Checker	

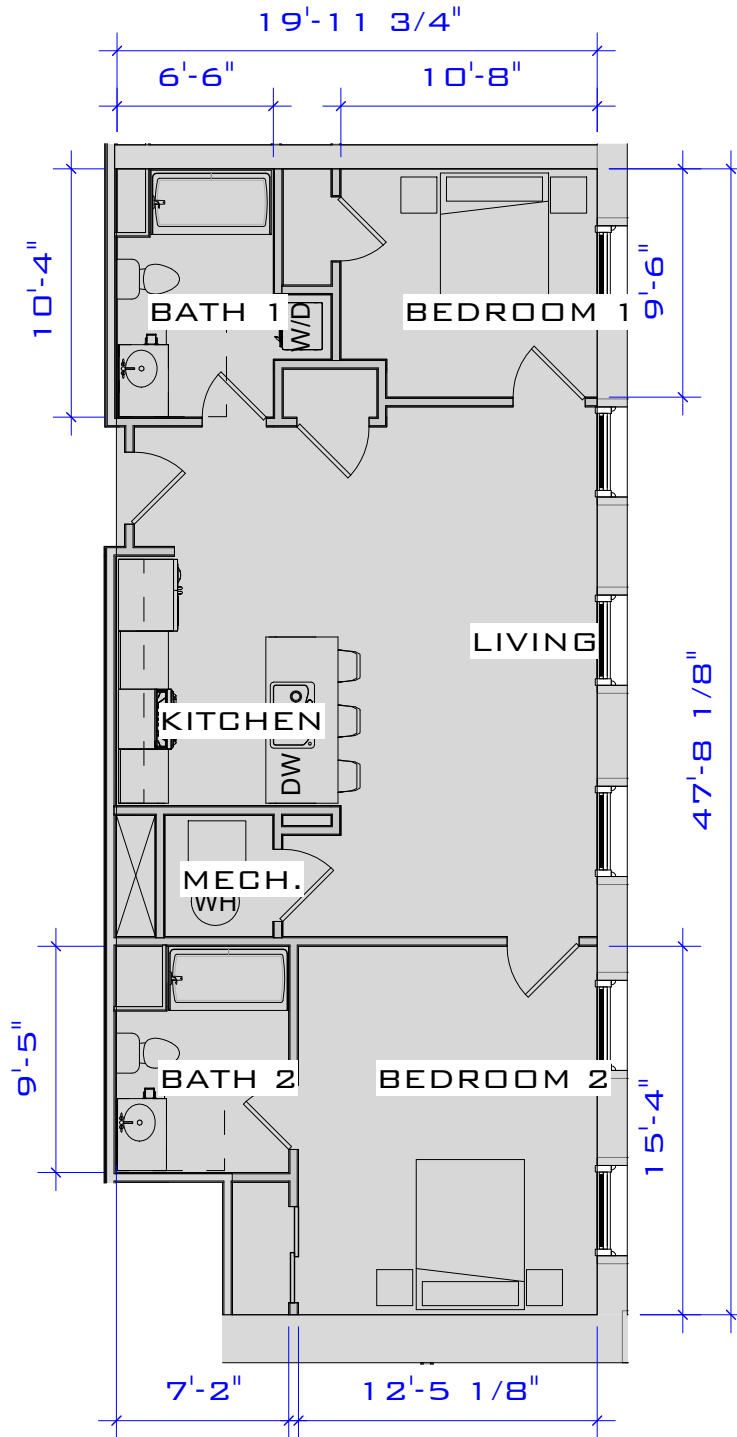

(SIMILAR UNITS: C-216, C-314)


THIRD FLOOR UNITS HAVE ELECTRIC FIRE PLACES---CTUAL SQUARE FOOTAGE MAY VARY



**JUNCTION
SHOP MILLS
JUNCTION SHOPS
MILL**

UNIT C-216 (926 S.F.)

Project number	Project Number	SKA-3-23
Date	Issue Date	
Drawn by	Author	
Checked by	Checker	
Scale		1/8" = 1'-0"

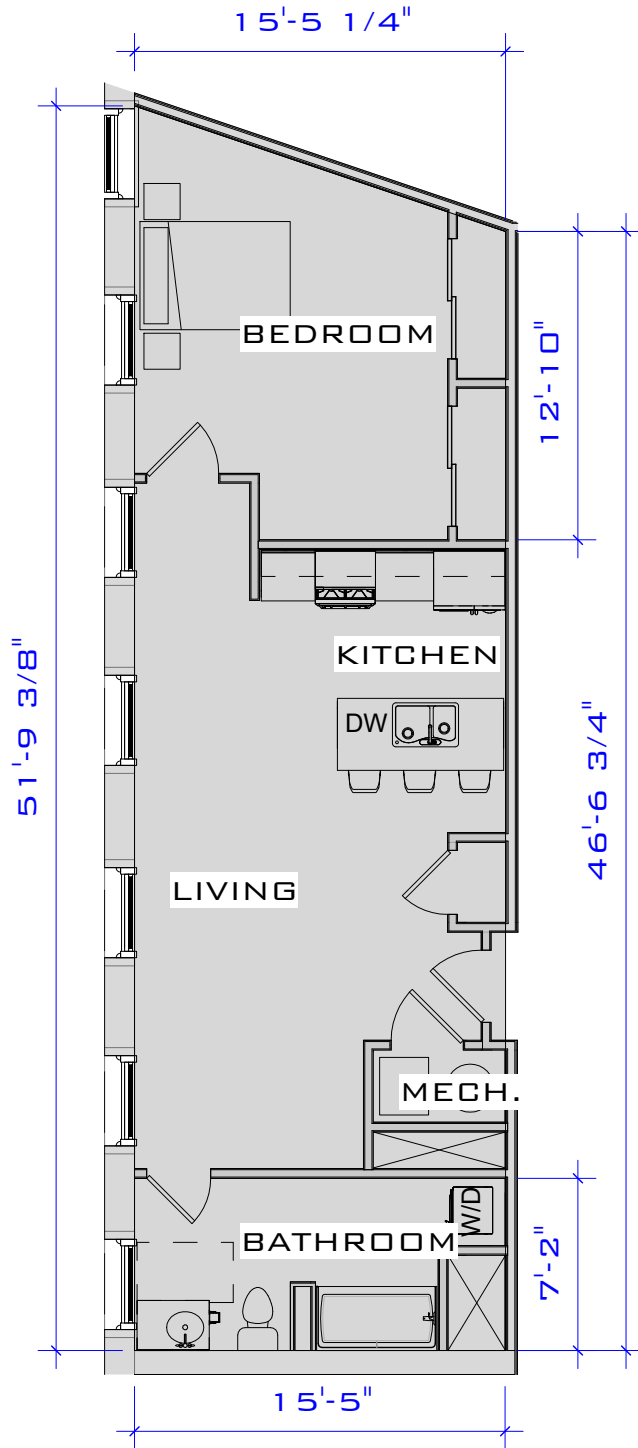

(SIMILAR UNITS: C-217, C-315)


THIRD FLOOR UNITS HAVE ELECTRIC FIRE PLACES---CTUAL SQUARE FOOTAGE MAY VARY



**JUNCTION
SHOP MILLS
JUNCTION SHOPS
MILL**

UNIT C-217 (760 S.F.)

Project number	Project Number	SKA-3-24
Date	Issue Date	
Drawn by	Author	Scale 1/8" = 1'-0"
Checked by	Checker	

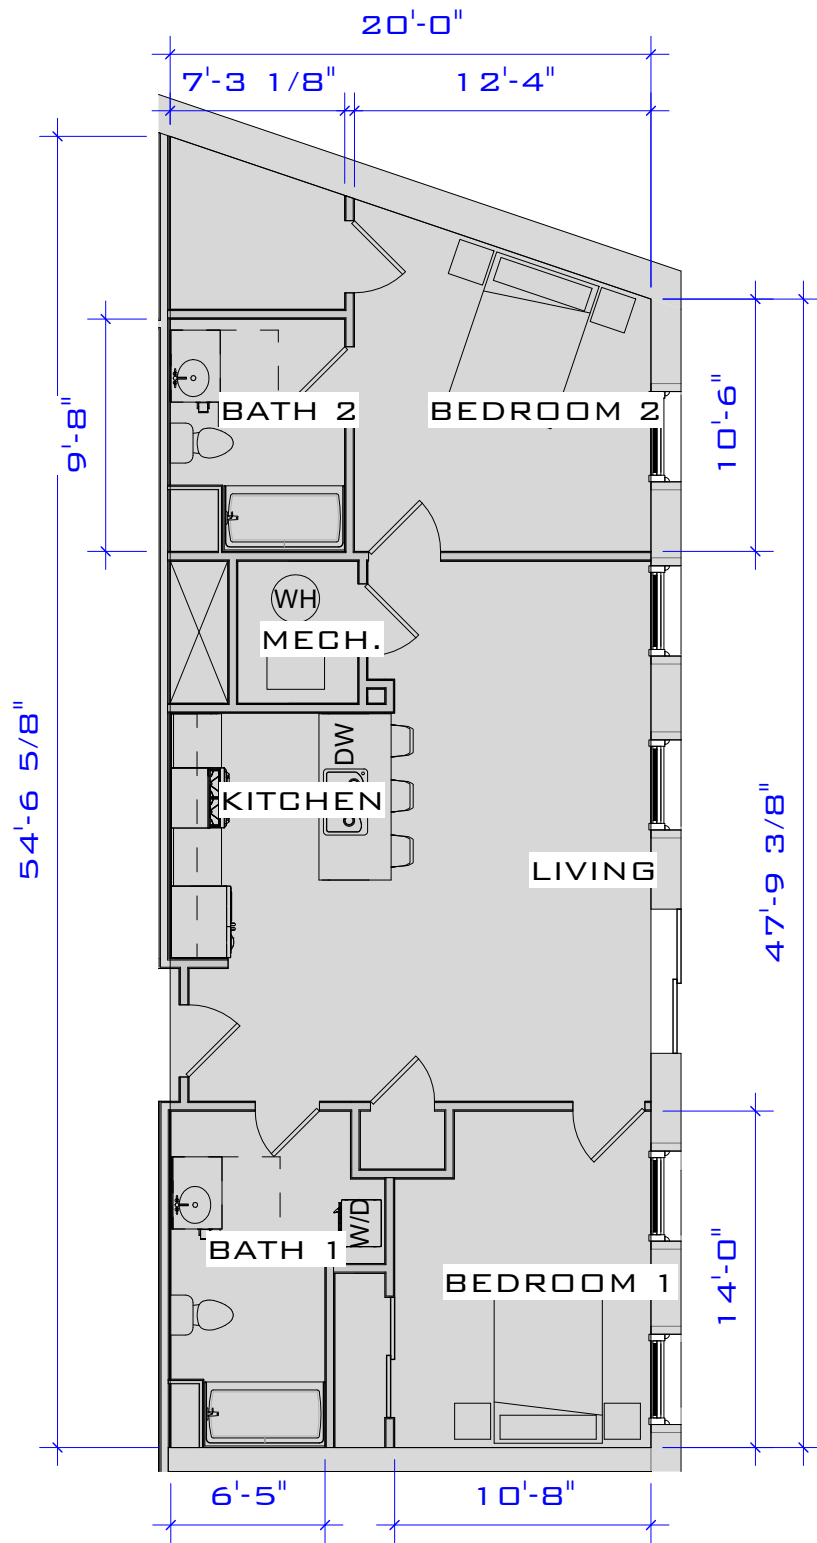

(SIMILAR UNITS: C-218, C-316)


THIRD FLOOR UNITS HAVE ELECTRIC FIRE PLACES---CTUAL SQUARE FOOTAGE MAY VARY



**JUNCTION
SHOP MILLS
JUNCTION SHOPS
MILL**

UNIT C-218 (1,024 S.F.)

Project number	Project Number	SKA-3-25
Date	Issue Date	
Drawn by	Author	Scale 1/8" = 1'-0"
Checked by	Checker	

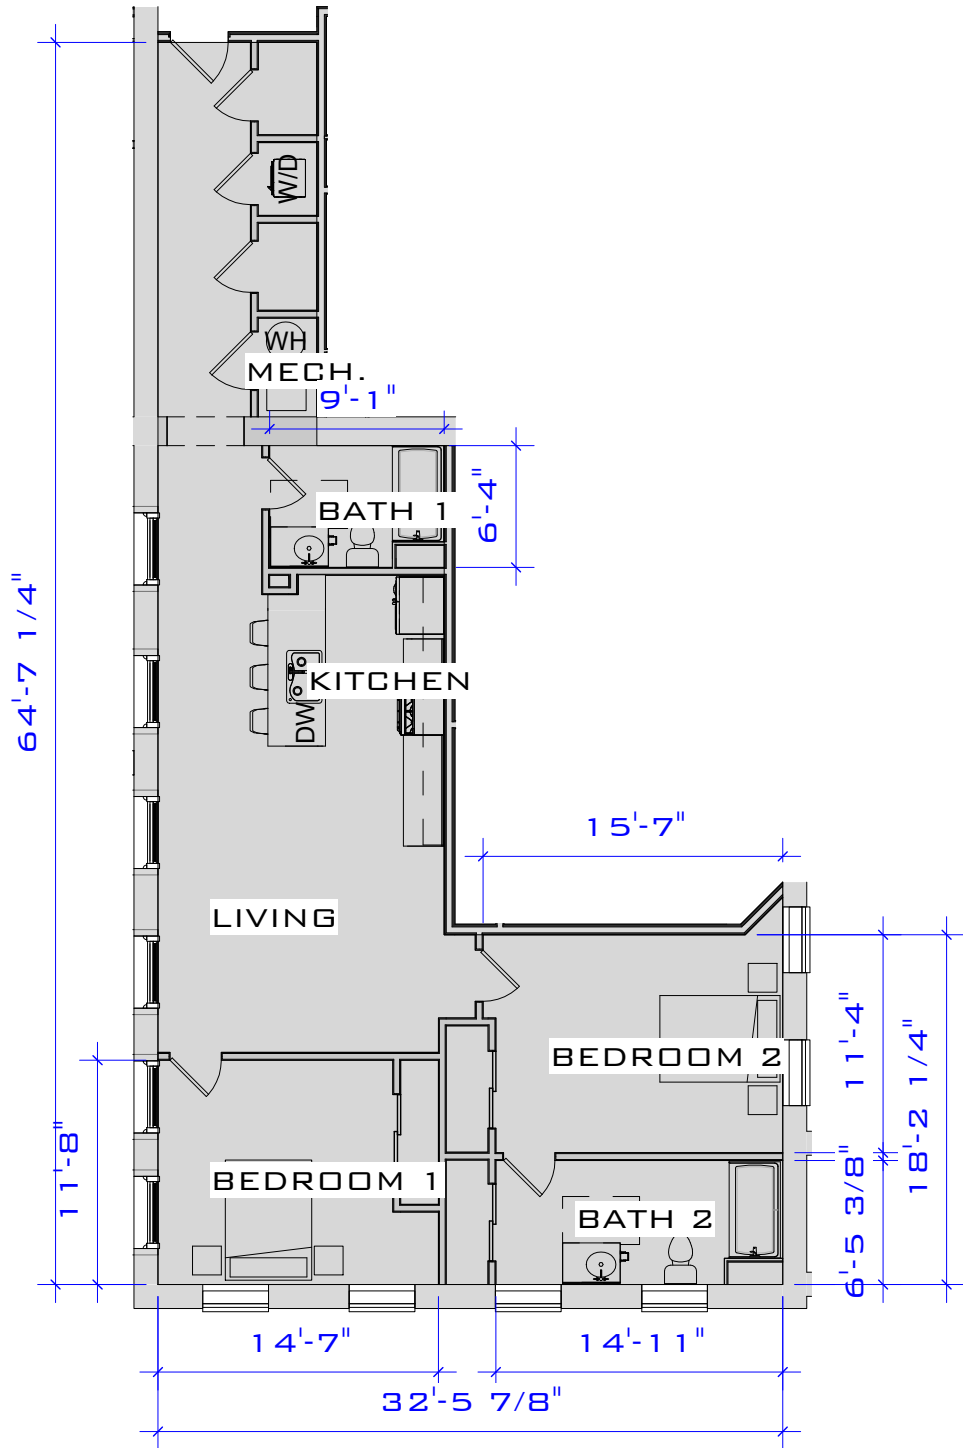

(SIMILAR UNITS: C-222, C-321)

THIRD FLOOR UNITS HAVE ELECTRIC FIRE PLACES---CTUAL SQUARE FOOTAGE MAY VARY




**JUNCTION
SHOP MILLS
JUNCTION SHOPS
MILL**

UNIT C-222 (1,146 S.F.)

Project number	Project Number
Date	Issue Date
Drawn by	Author
Checked by	Checker

SKA-3-26

Scale 1" = 10'-0"

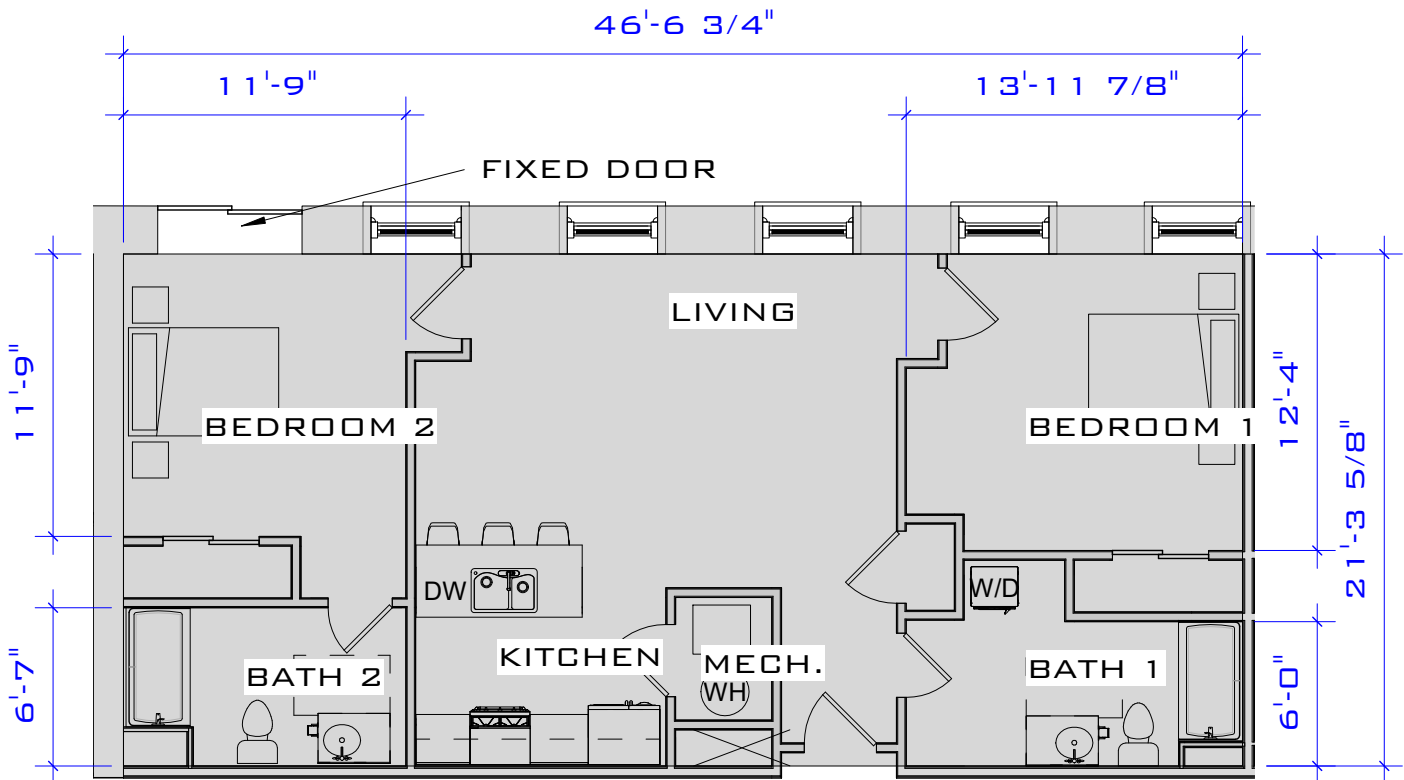

(SIMILAR UN) **ADA UNIT**


THIRD FLOOR UNITS HAVE ELECTRIC FIRE PLACES---CTUAL SQUARE FOOTAGE MAY VARY



**JUNCTION
SHOP MILLS**
JUNCTION SHOPS
MILL

UNIT C-223 (992 S.F.)

Project number	Project Number	SKA-3-27
Date	Issue Date	
Drawn by	Author	Scale 1/8" = 1'-0"
Checked by	Checker	

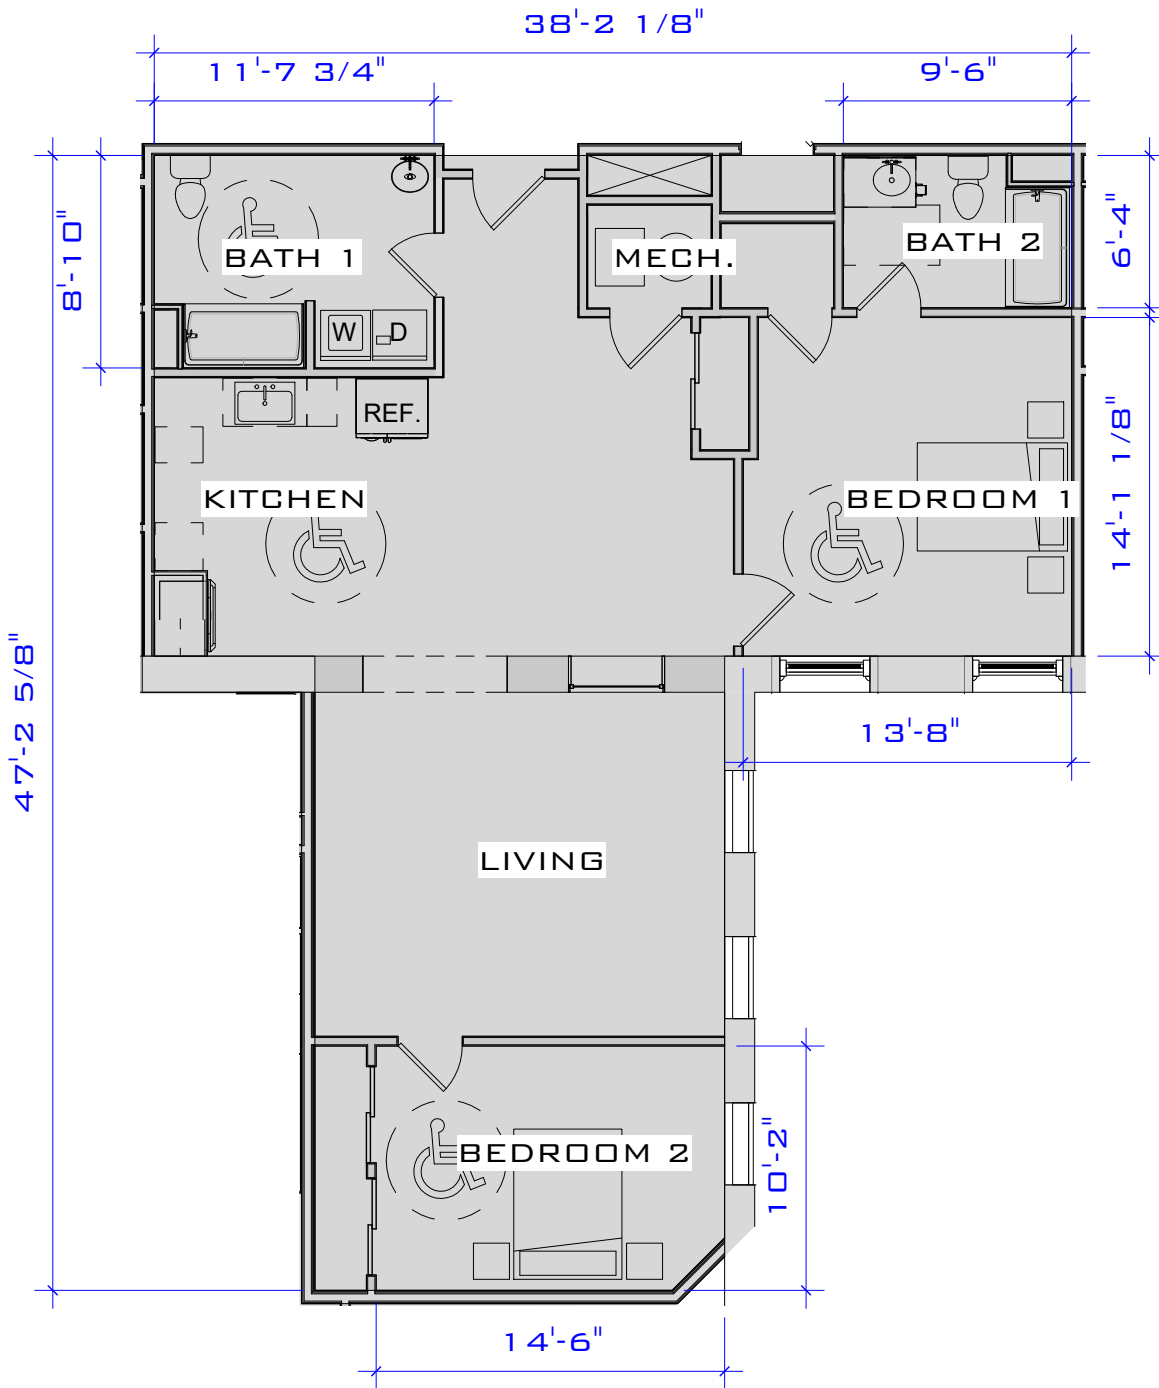

(SIMILAR UNITS: C-224, C-322)


THIRD FLOOR UNITS HAVE ELECTRIC FIRE PLACES---CTUAL SQUARE FOOTAGE MAY VARY



**JUNCTION
SHOP MILLS
JUNCTION SHOPS
MILL**

UNIT C-224 (1,242 S.F.)

Project number	Project Number	SKA-3-28
Date	Issue Date	
Drawn by	Author	
Checked by	Checker	
Scale		1/8" = 1'-0"

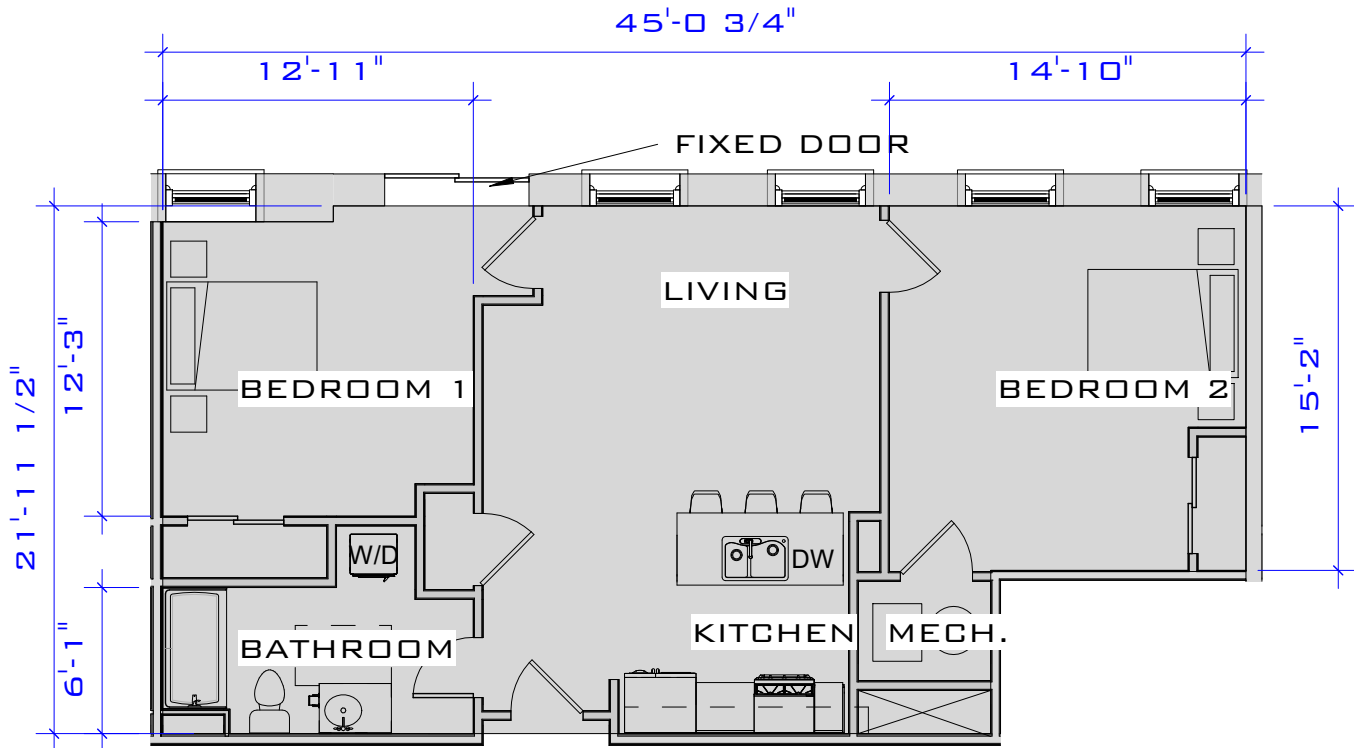

(SIMILAR UNITS: C-227, C-326)


THIRD FLOOR UNITS HAVE ELECTRIC FIRE PLACES---CTUAL SQUARE FOOTAGE MAY VARY




**JUNCTION
SHOP MILLS**
JUNCTION SHOPS
MILL

UNIT C-227 (914 S.F.)

Project number	Project Number	SKA-3-29
Date	Issue Date	
Drawn by	Author	
Checked by	Checker	
Scale		1/8" = 1'-0"

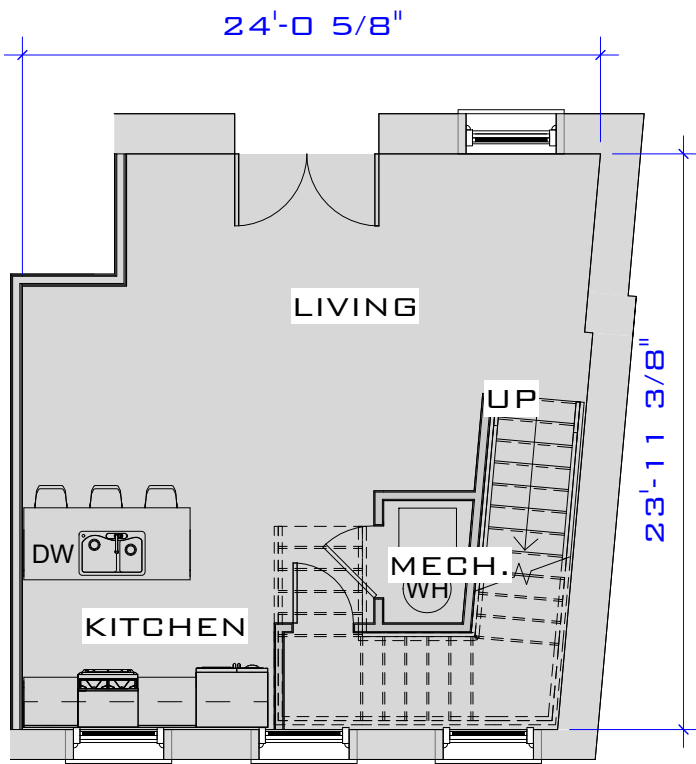

FIRST FLOOR

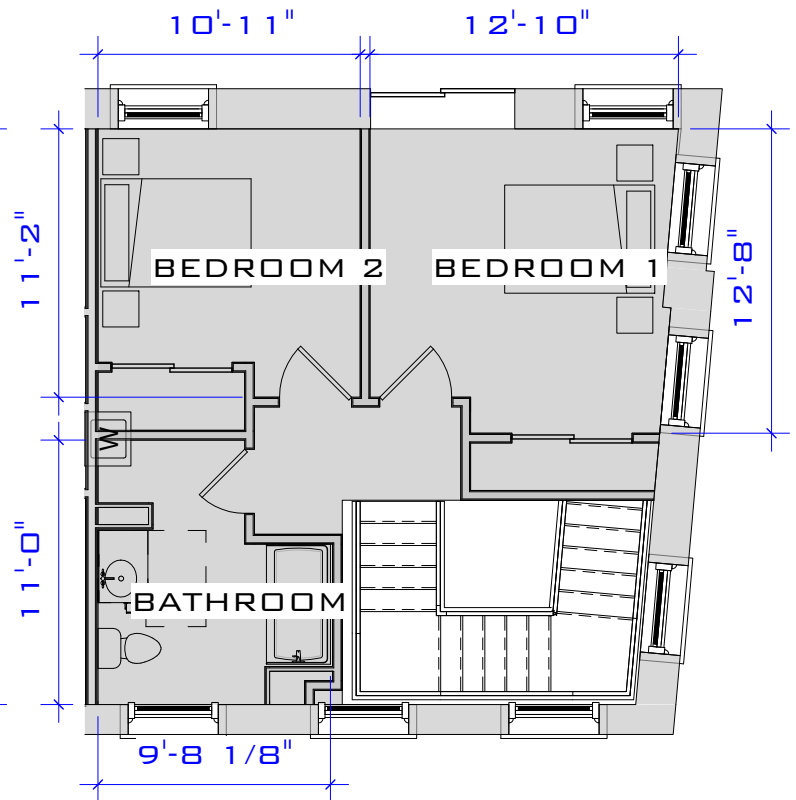

SECOND FLOOR

(SIMILAR UNITS: D-101)

ACTUAL SQUARE FOOTAGE MAY VARY




**JUNCTION
SHOP MILLS
JUNCTION SHOPS
MILL**

UNIT D-101 (984 S.F.)


Project number	Project Number
Date	Issue Date
Drawn by	Author
Checked by	Checker

SKA-4-1

Scale 1/8" = 1'-0"

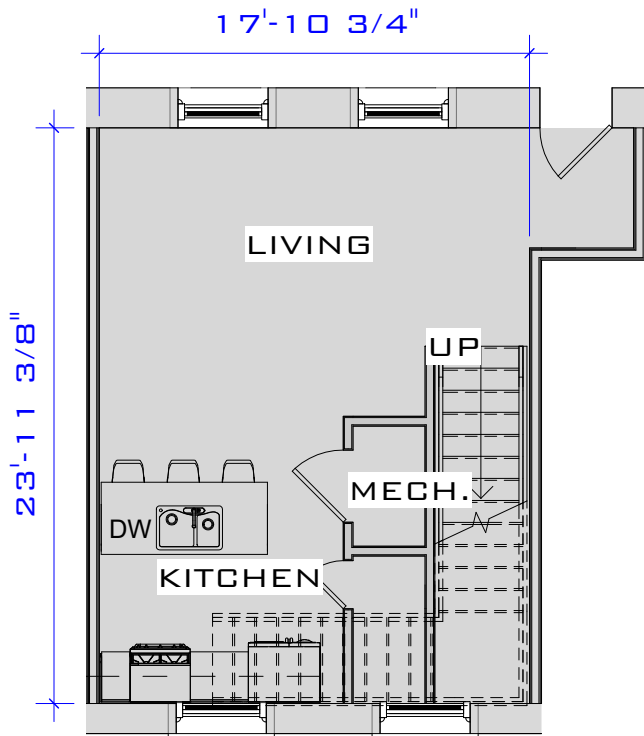

FIRST FLOOR

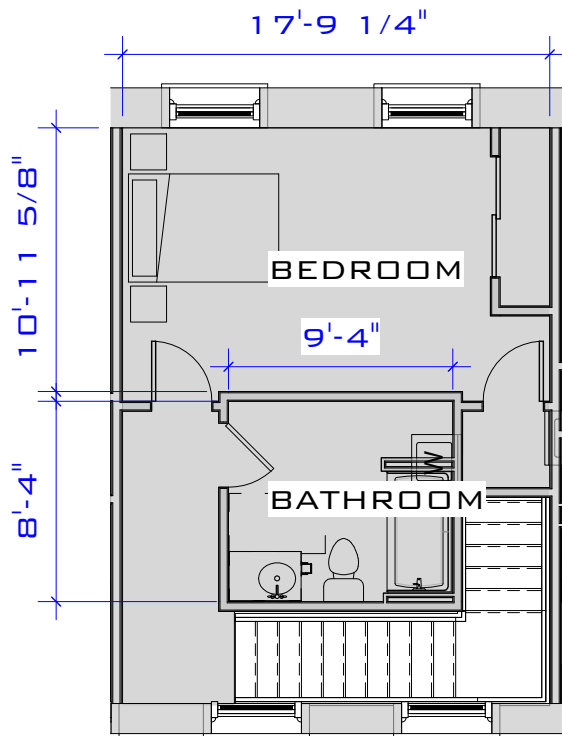

SECOND FLOOR

(SIMILAR UNITS: D-102)

ACTUAL SQUARE FOOTAGE MAY VARY




**JUNCTION
SHOP MILLS**
JUNCTION SHOPS
MILL

UNIT D-102 (810 S.F.)

Project number	Project Number
Date	Issue Date
Drawn by	Author
Checked by	Checker

SKA-4-2

Scale 1/8" = 1'-0"

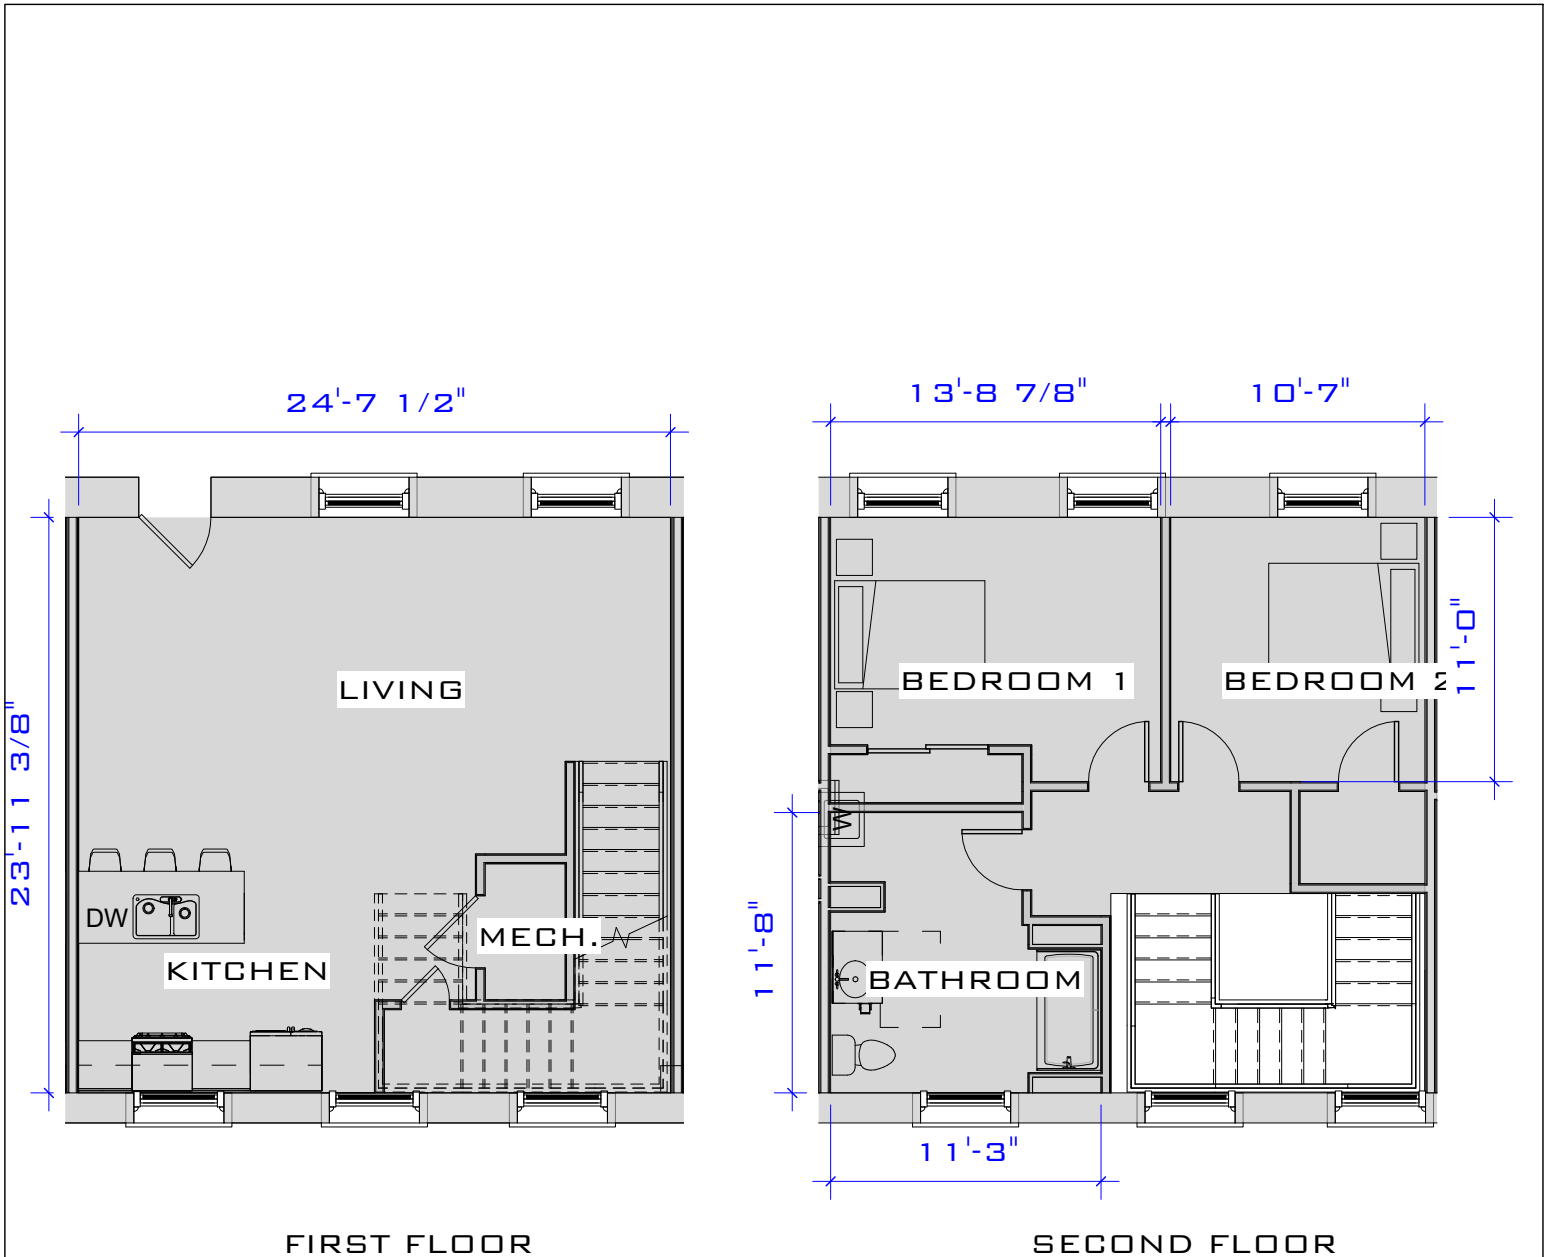

FIRST FLOOR

SECOND FLOOR

(SIMILAR UNITS: D-103)

ACTUAL SQUARE FOOTAGE MAY VARY





**JUNCTION
SHOP MILLS
JUNCTION SHOPS
MILL**

UNIT D-103 (1,075 S.F.)

Project number	Project Number
Date	Issue Date
Drawn by	Author
Checked by	Checker

SKA-4-3

Scale 1/8" = 1'-0"

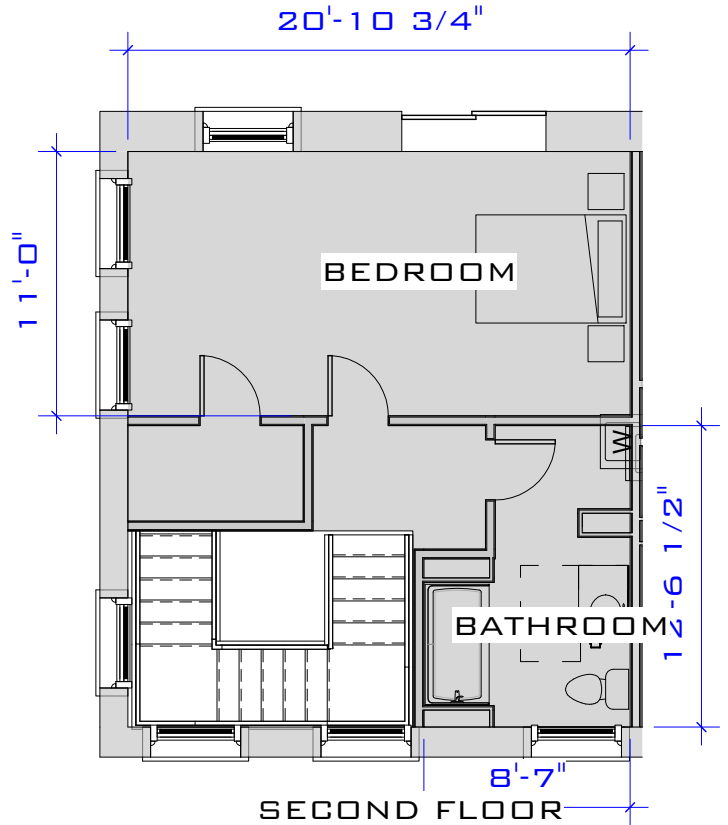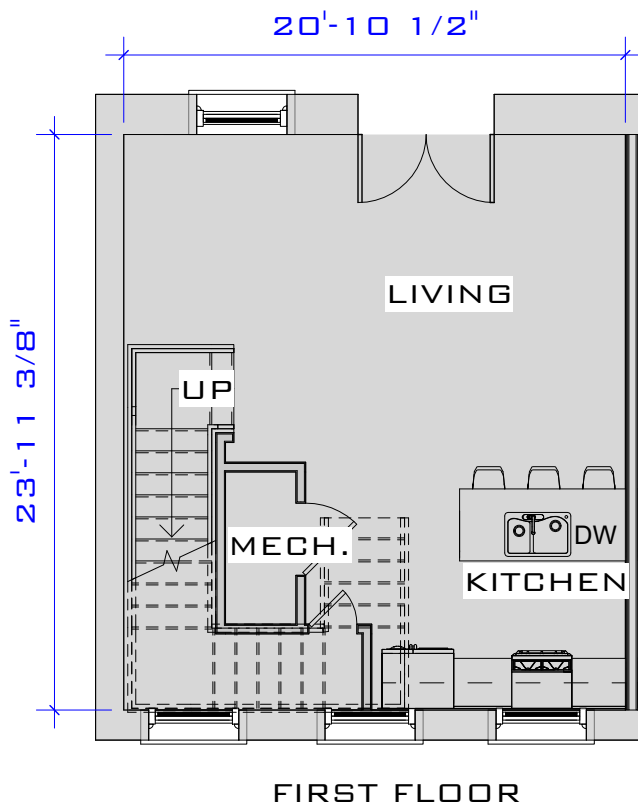

(SIMILAR UNITS: D-104)

ACTUAL SQUARE FOOTAGE MAY VARY



**JUNCTION
SHOP MILLS**
JUNCTION SHOPS
MILL

UNIT D-104 (904 S.F.)

Project number	Project Number
Date	Issue Date
Drawn by	Author
Checked by	Checker

SKA-4-4

Scale 1/8" = 1'-0"