


SNHU  
 1230 ELM STREET  
 4TH FLOOR  
 IT  
 PROPOSED LAYOUT  
 OPTION A

MARKED UP BY COMPUTER CABLE COMPANY 05-01-17

PROPOSED LAYOUT 02-22-17

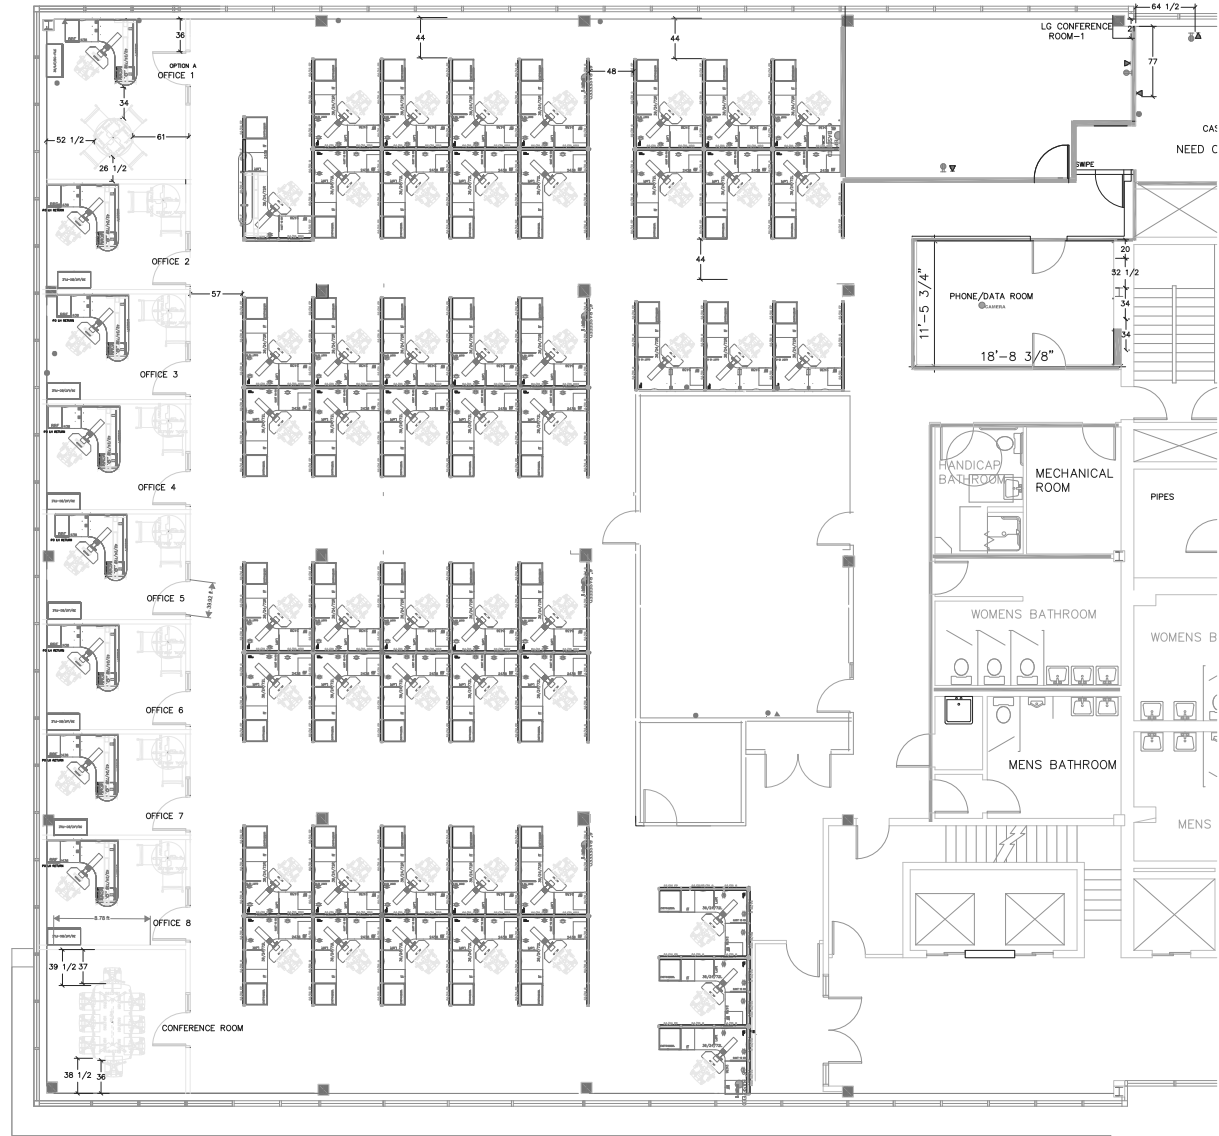

155 Dow Street, Suite 100  
 Manchester, NH 03103  
 TEL: 603.647.4233  
 FAX: 603.647.3946

SNHU  
 1230 ELM STREET  
 MANCHESTER, NH

4TH FLOOR

- 02-11-14
- 02-25-14
- 02-27-14
- 03-11-14
- 03-14-14
- 04-11-14
- 04-23-14
- 02-22-17
- 03-16-17
- 03-17-17
- 04-05-17

SCALE: 1/4"=1'-0"  
 DATE: 11/20/17  
 PROJECT: ITK REDESIGN  
 FLOOR: DATA ROOMS